


HAROLD H. KOLB
REGISTERED PROFESSIONAL LAND SURVEYOR
TWO BUILDING
LAKE GENEVA, WIS. 53147

PLAT OF SURVEY OF

OUT-LOTS 86, 87, 90, 110, AND 111 OF THE ASSESSORS PLAT
OF THE VILLAGE OF WAINWORTH, AND A PARCEL OF LAND LOCATED IN
THE NORTHWEST 1/4 OF SECTION 22, T 1 N, R 16 E, WALWORTH
COUNTY, WISCONSIN.

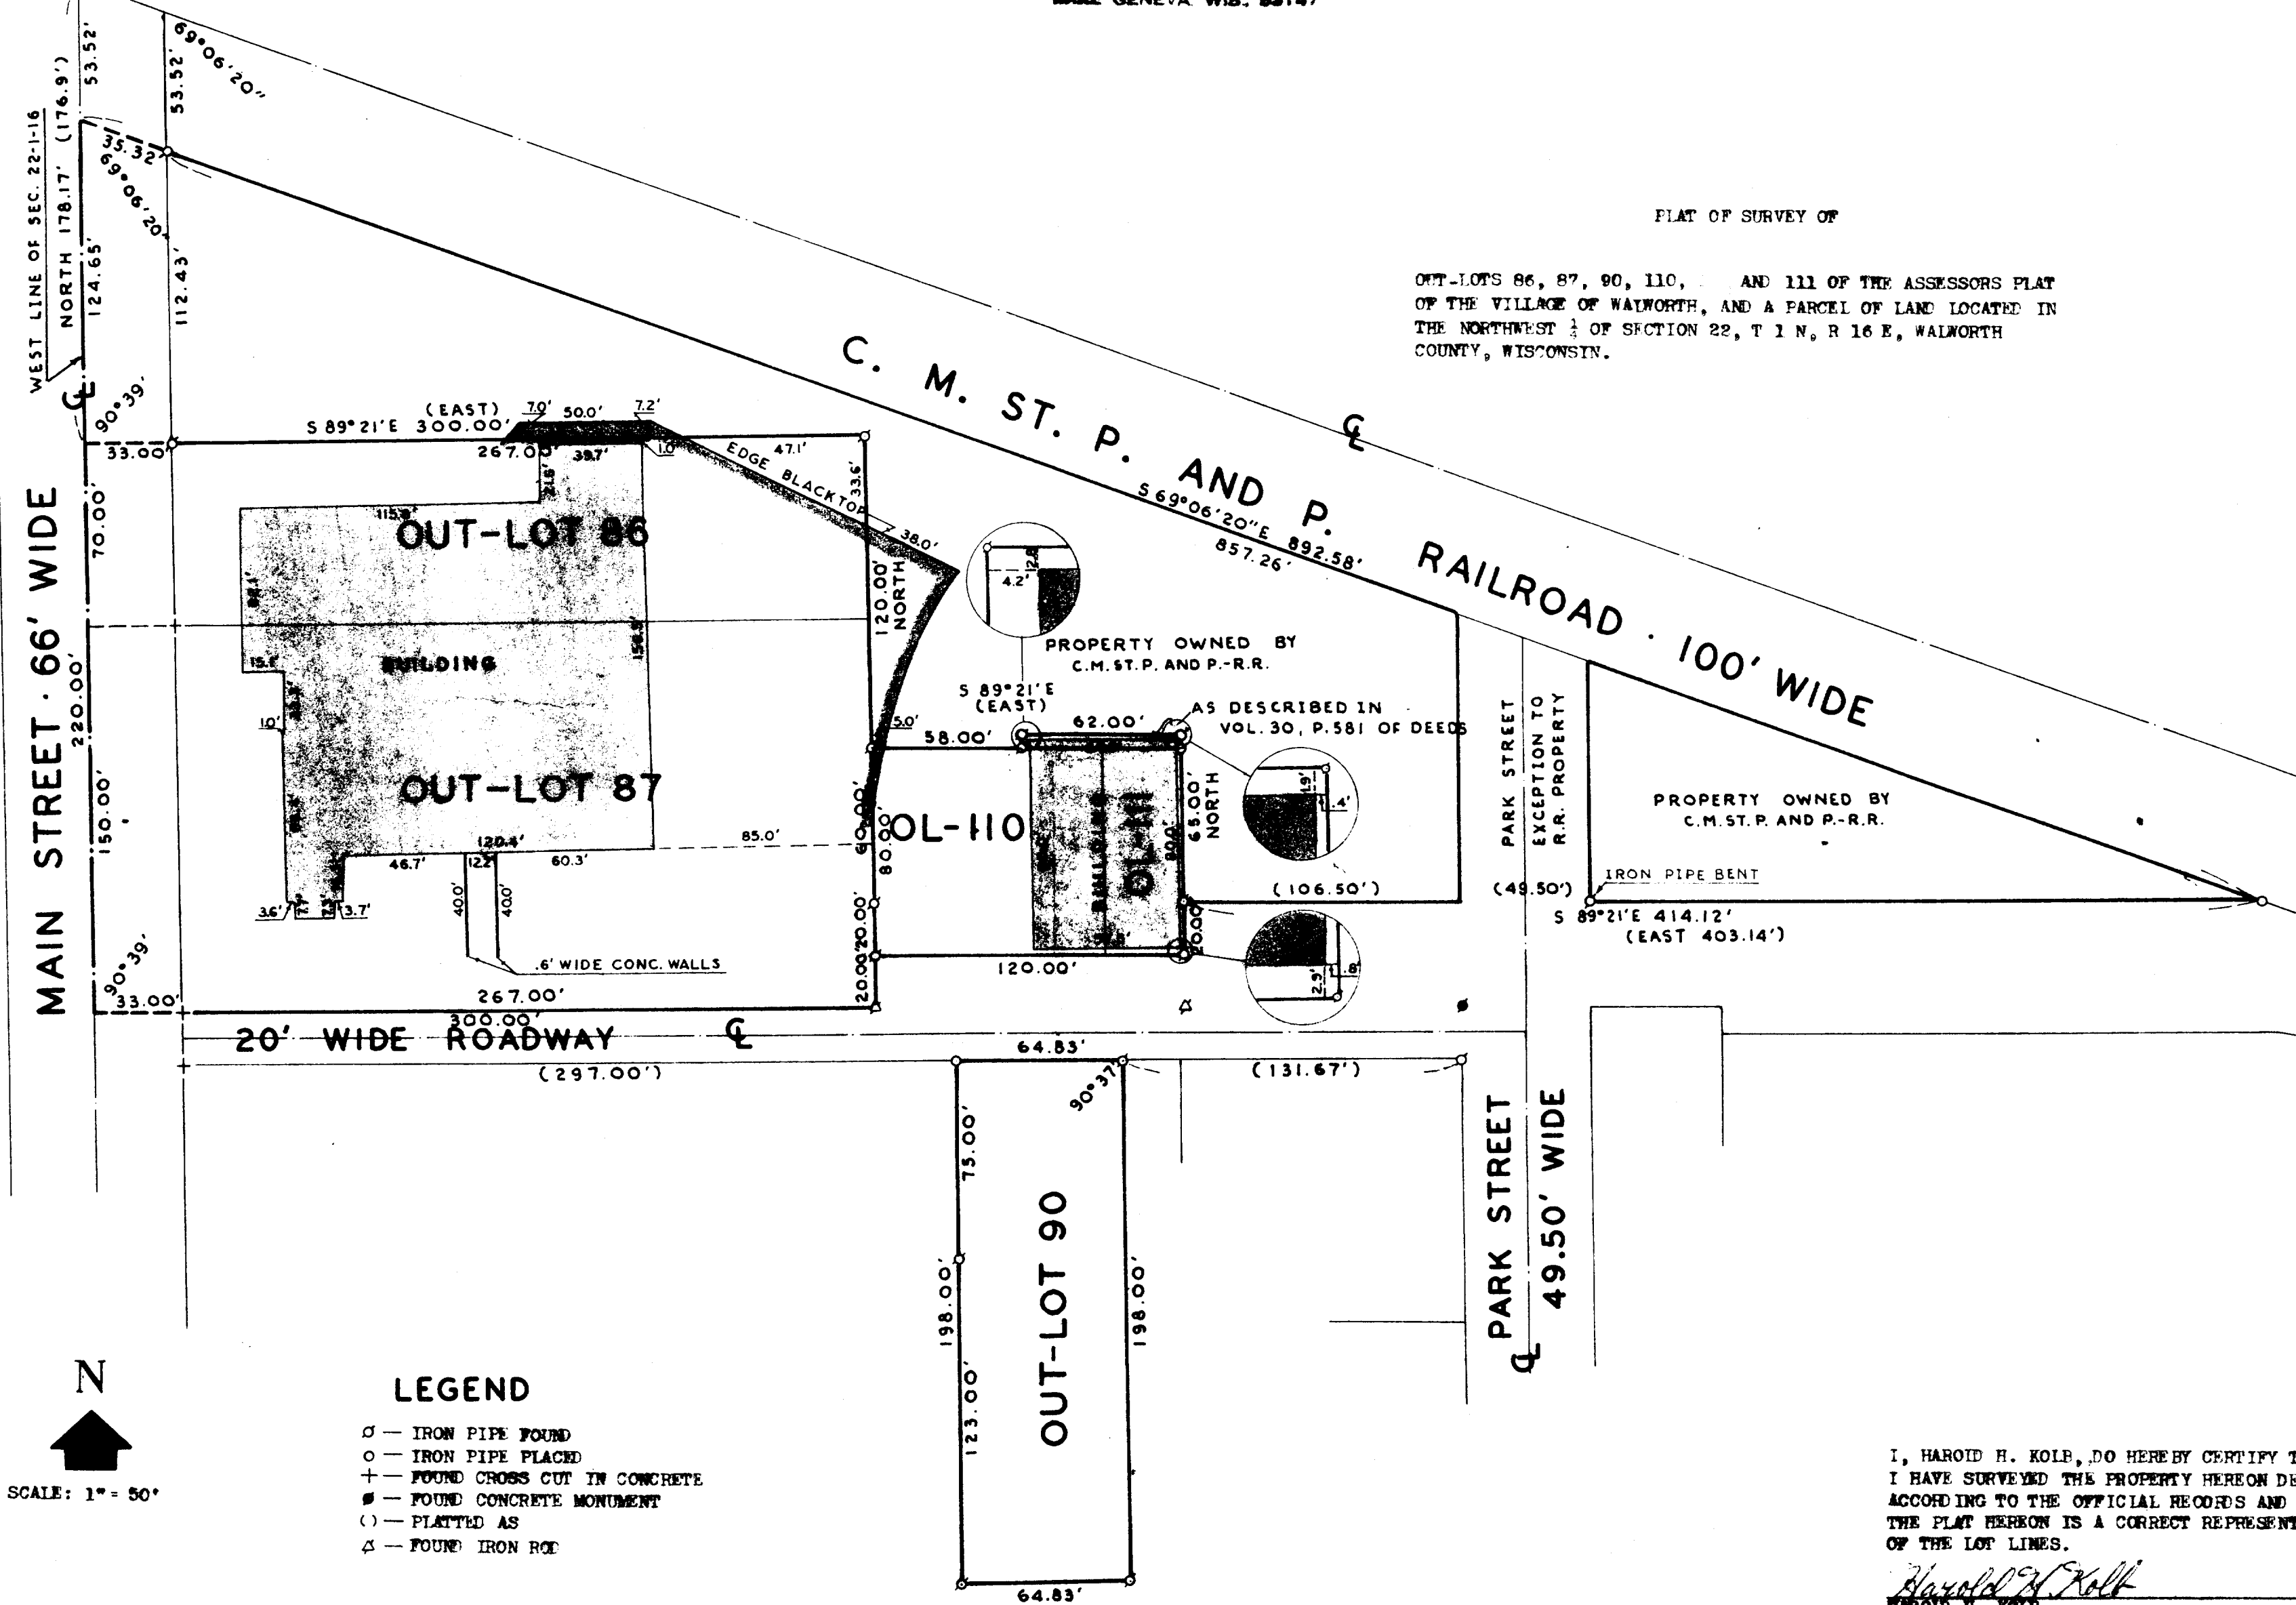

N
SCALE: 1" = 50'

LEGEND

- — IRON PIPE FOUND
- — IRON PIPE PLACED
- + — FOUND CROSS CUT IN CONCRETE
- — FOUND CONCRETE MONUMENT
- () — PLATTED AS
- △ — FOUND IRON ROD

I, HAROLD H. KOLB, DO HEREBY CERTIFY THAT
I HAVE SURVEYED THE PROPERTY HEREON DESCRIBED
ACCORDING TO THE OFFICIAL RECORDS AND THAT
THE PLAT HEREON IS A CORRECT REPRESENTATION
OF THE LOT LINES.

Harold H. Kolb
HAROLD H. KOLB

WISCONSIN REGISTERED SURVEYOR, S-187

DATE: November 10, 1972

REVISED: JUNE 21, 1976

VW P-100, 185, 186, 187

9-138

WAL-25