


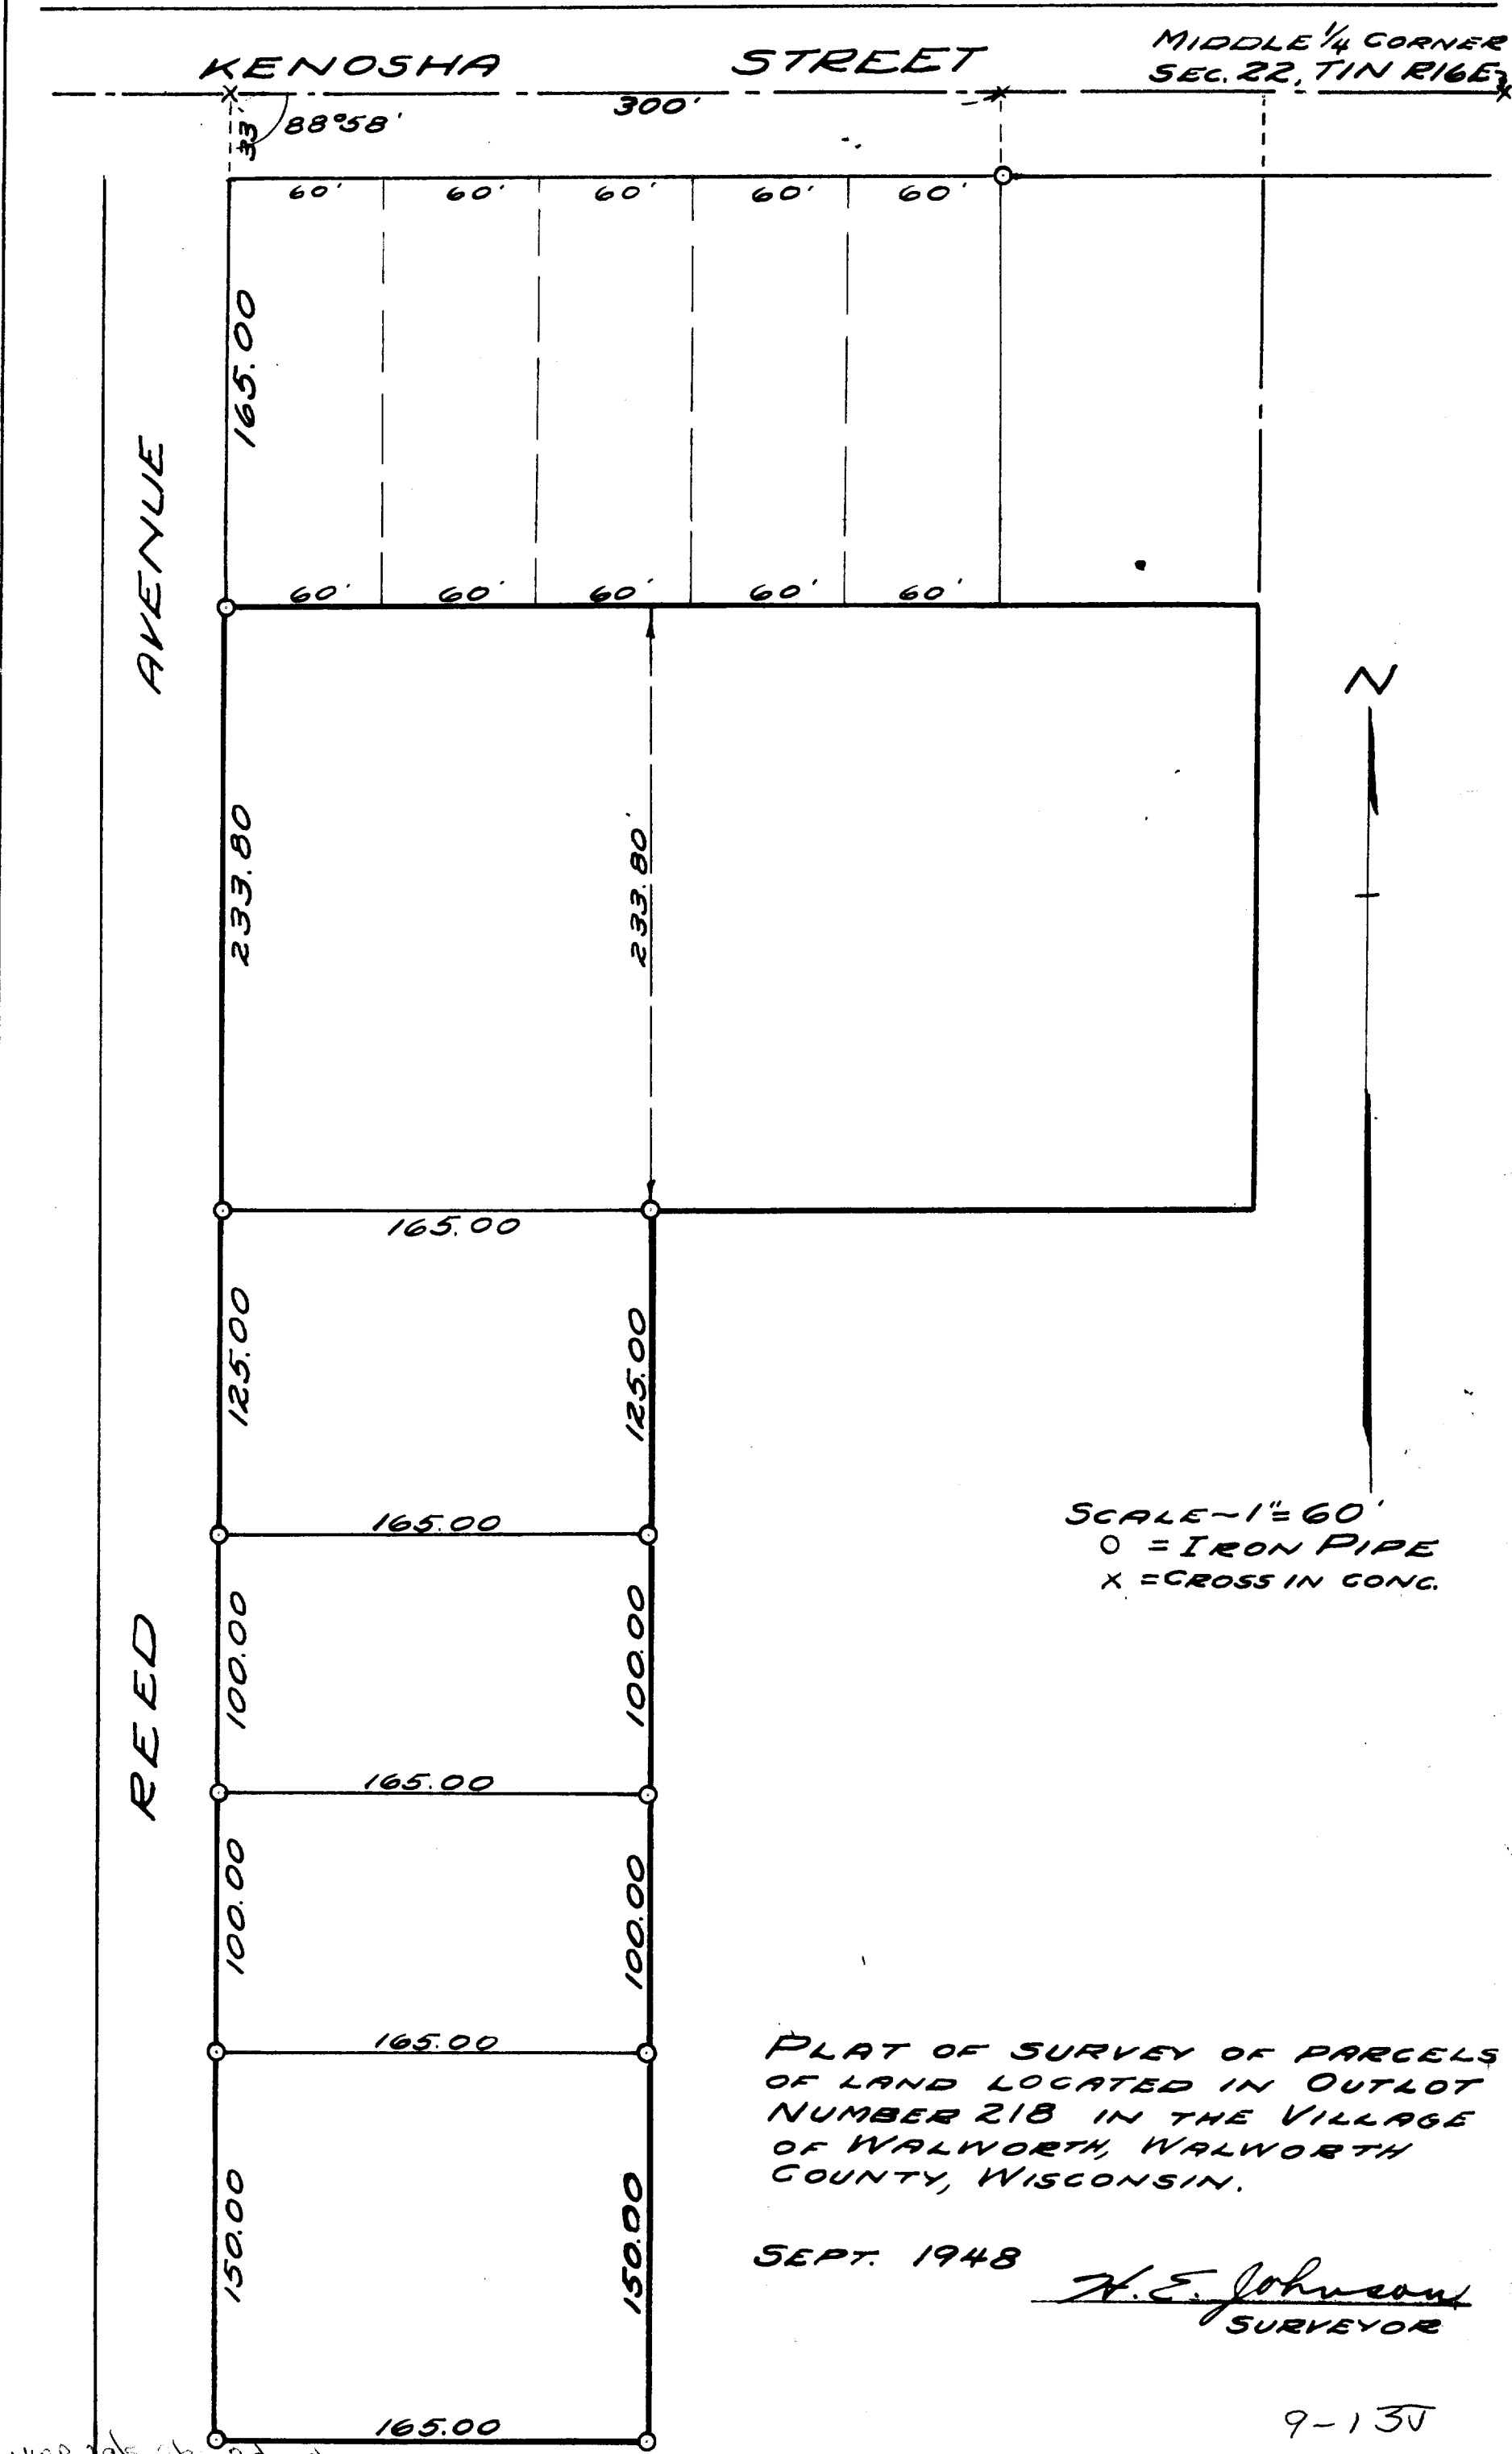

VWP-225.26.291 278.298A

9-13U