
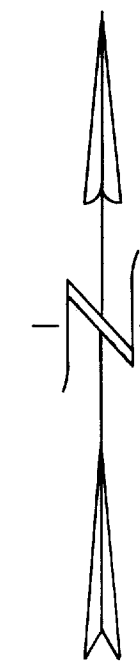


PLAT OF SURVEY

OF OUTLOT 62 OF THE ASSESSORS PLAT OF
THE VILLAGE OF WALWORTH, WALWORTH
COUNTY, WISCONSIN

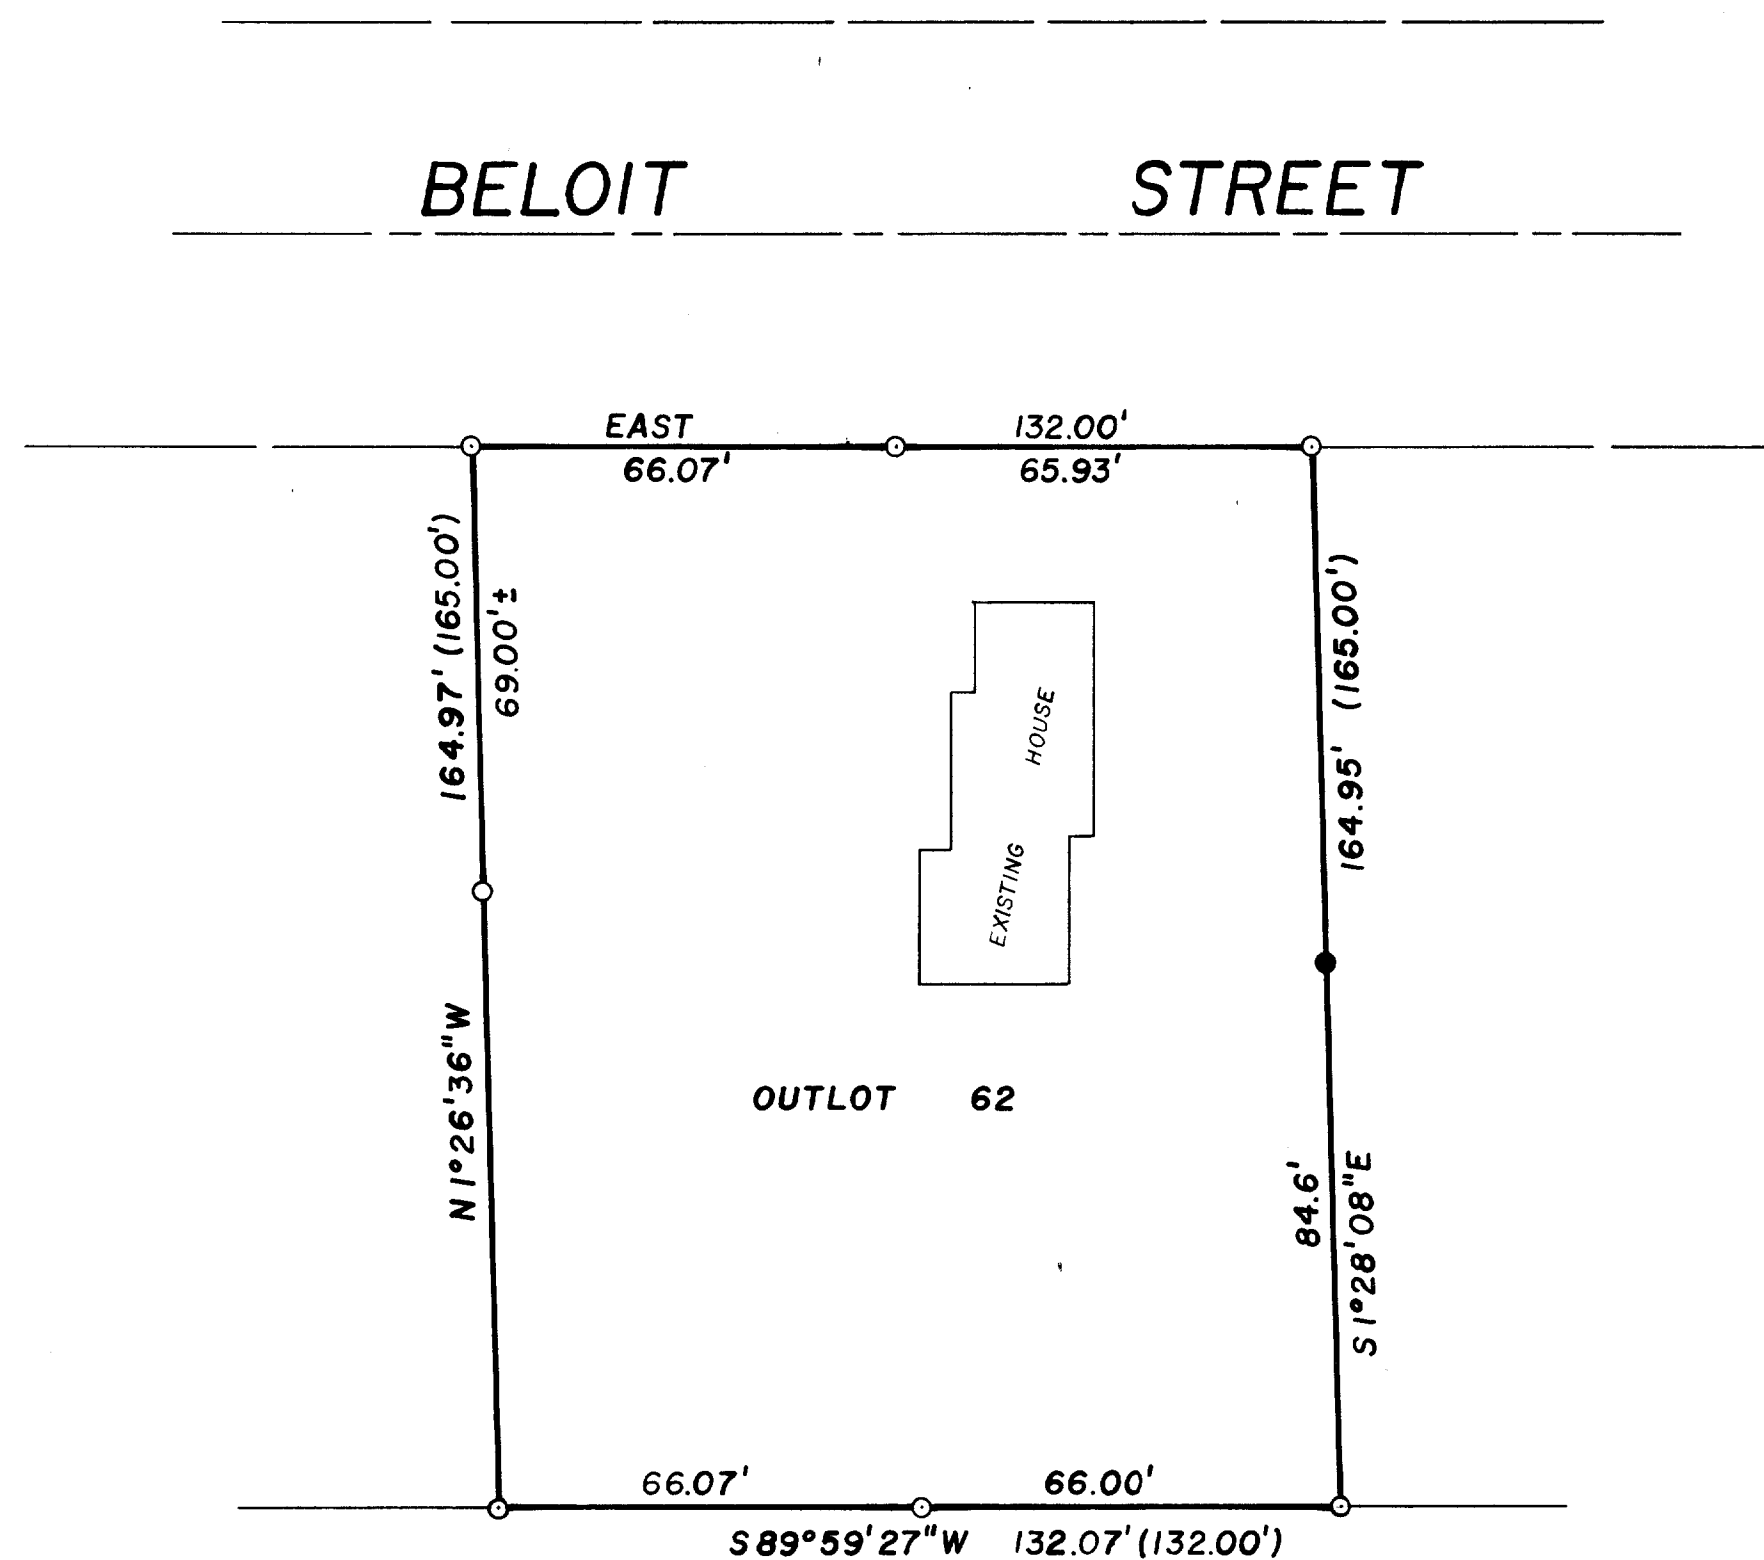

BEARING REFERENCED TO SOUTHERLY
LINE OF BELOIT STREET ASSUMED EAST

LEGEND

- FOUND CONCRETE MONUMENT
- SET IRON ROD 3/4" X 30"
- FOUND IRON PIPE
- () RECORDED AS


Surveyors Certificate

I, William A. Shearman, registered Land Surveyor, do hereby certify that the plat shown herein is a true and accurate survey and a true representation thereof and the exterior boundary lines and all divisions of said property have been surveyed under my direction and to the best of my knowledge and belief.

William A. Shearman S-1378
Registered Land Surveyor
Date this 12th day of December, 1977.

VW-72

JENSEN & JOHNSON
ENGINEERS AND SURVEYORS
PO BOX 290, ELKHORN, WISCONSIN
414-723-3204
A Division of
Donohue & Associates, Inc.

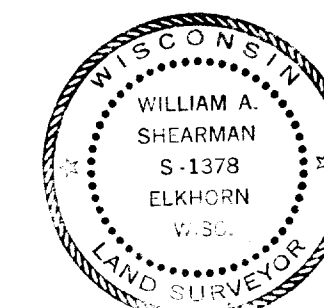

Date 12 / 22 / 77	Scale 1" = 30'
Drawn By D. J. H.	Surveyed For M. SORENSON
Checked By D. J. C.	Project No. 1658.256