


GRAPHIC SCALE IN FEET

0 50 100 200 400

A circular professional seal for a Wisconsin Land Surveyor. The outer ring contains the text "WISCONSIN" at the top and "LAND SURVEYOR" at the bottom, separated by two five-pointed stars. The inner circle contains the text "DONALD E. ZENZ", "S-1088", and "Burlington, Wis." in three lines.

THE ABOVE - DESCRIBED PROPERTY HAS BEEN
SURVEYED UNDER MY DIRECTION AND THE
MAP BELOW IS A TRUE REPRESENTATION
THEREOF AND SHOWS THE SIZE AND LOCATION
OF THE PROPERTY TO THE BEST OF MY KNOWLEDGE
AND BELIEF

Donald E. Zenz
DONALD E. ZENZ
REGISTERED LAND SURVEYOR NO. 51088

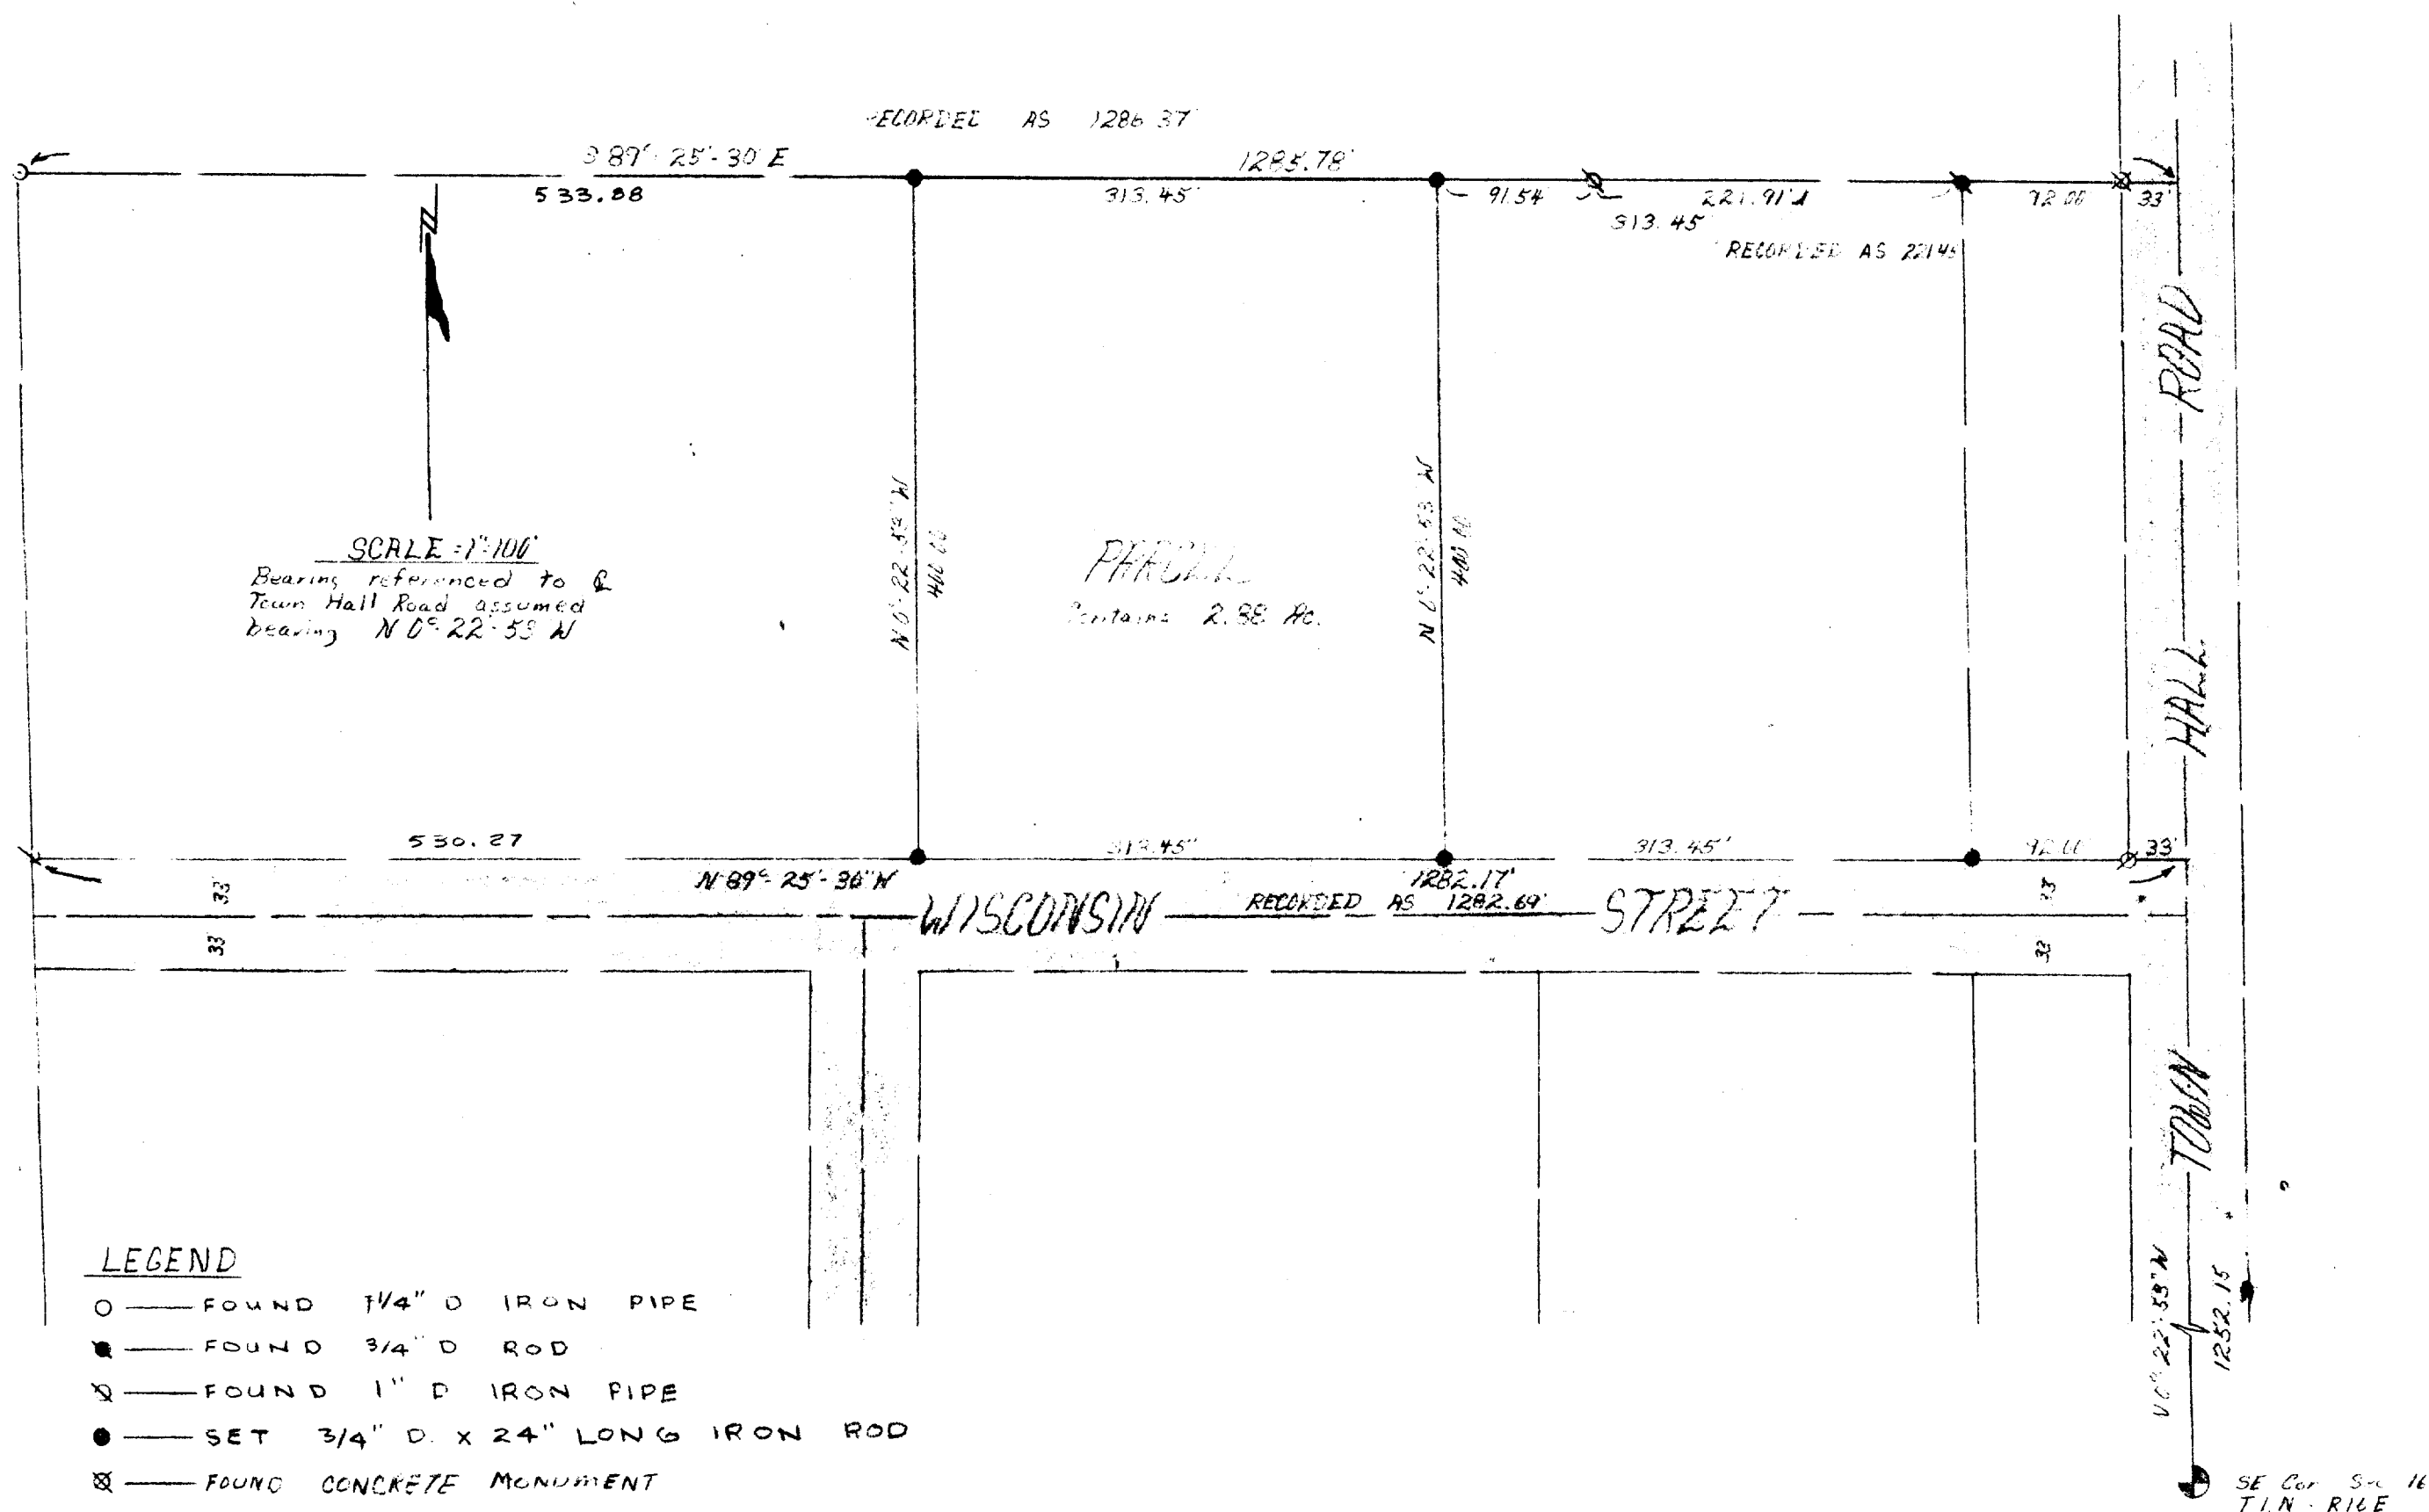

SURVEYED FOR VILLAGE OF WALWORTH
BUSINESS & INDUSTRIAL CORP.