


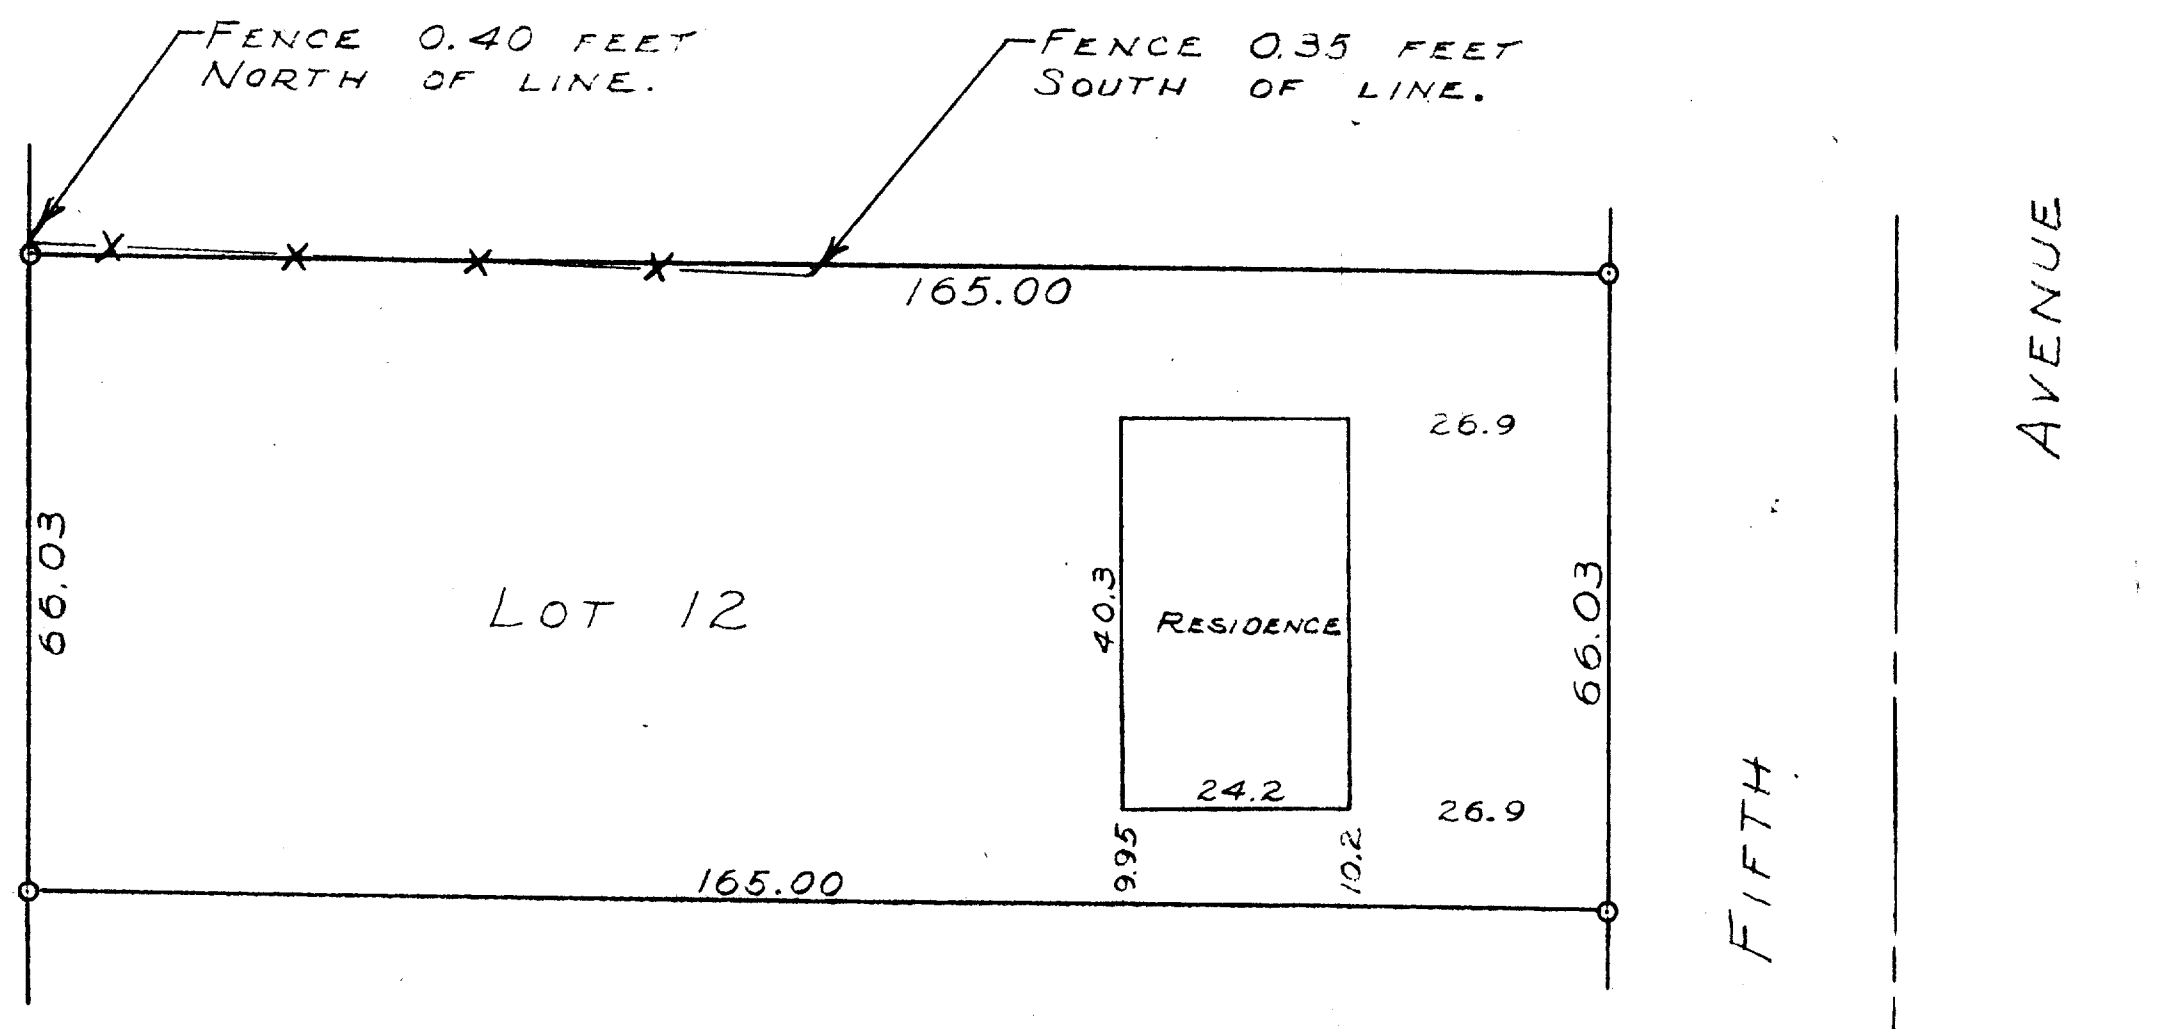

SCALE ~ 1" = 20'
 O ~ IRON PIPE

STATE OF WISCONSIN } S.S.
 COUNTY OF WALWORTH }

I, GEORGE T. DUNHAM, DO HEREBY CERTIFY THAT I HAVE SURVEYED
 THE PROPERTY DESCRIBED AS FOLLOWS:

LOT 12, BLOCK 1, E.W. CRUMB'S ADDITION TO THE VILLAGE OF
 WALWORTH, WALWORTH COUNTY, WISCONSIN.

AND THAT THE PLAT SHOWN ABOVE IS A CORRECT REPRESENTATION OF THE
 PROPERTY LINES AND IMPROVEMENTS THEREON.
 AUGUST 22, 1957

George T. Dunham
 GEORGE T. DUNHAM, SURVEYOR
 DELAVAN, WISCONSIN