


## DUNHAM SURVEYING CO., INC.

DELAWARE, WISCONSIN

FILE # 510

COURT

I.P. located N. 45° W.  
W. of I.P. N. 45° W.  
fence corner.

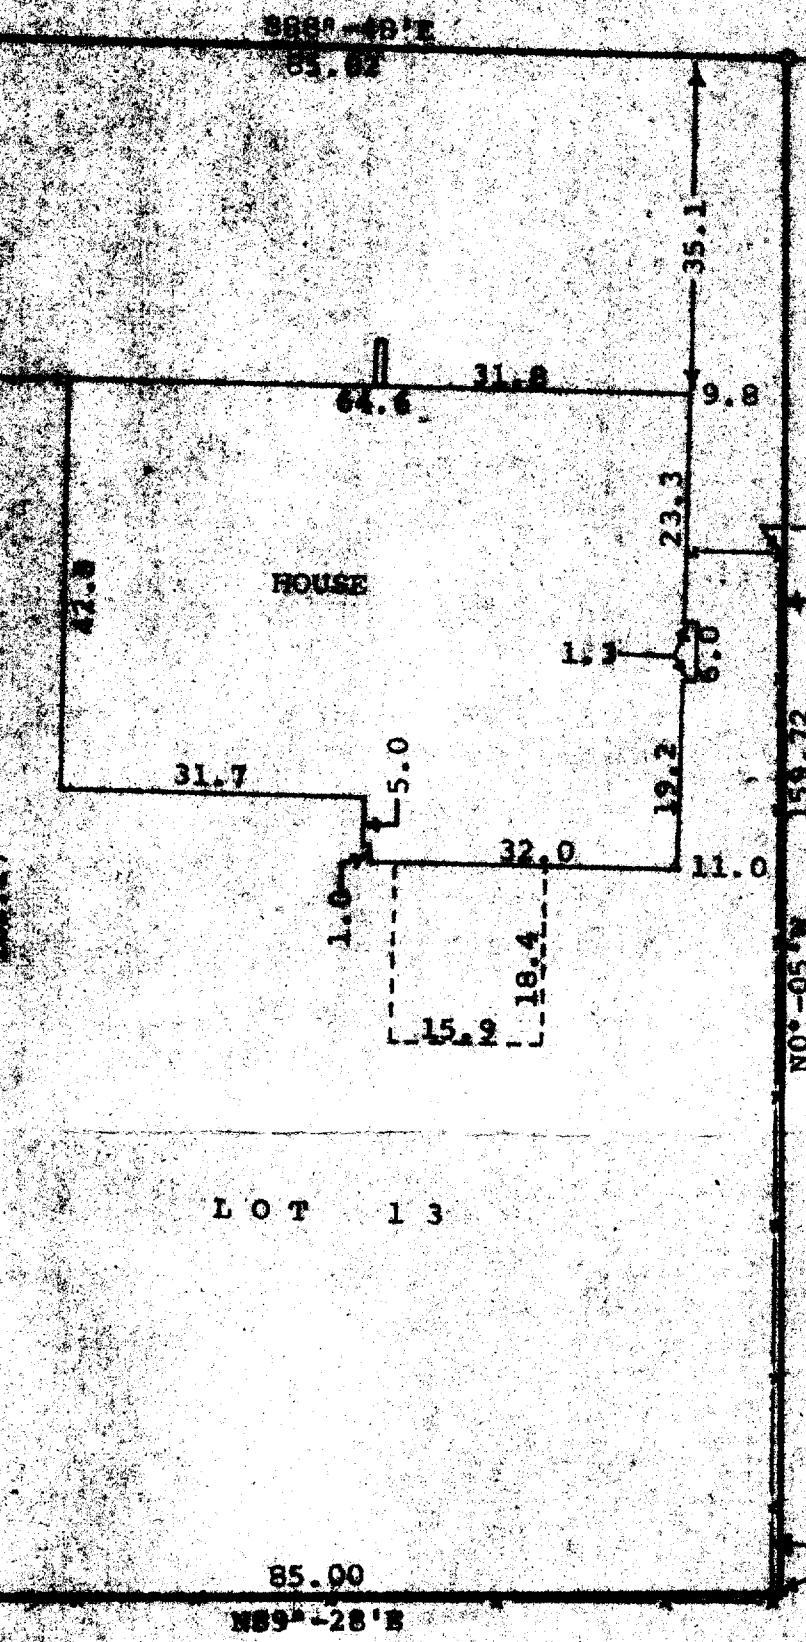

Lot corner is located  
0.9' East & 0.7' North  
of fence corner.


I.P. at SW corner  
of fence corner.

STATE OF WISCONSIN, ss  
COUNTY OF WALWORTH,

I, George T. Dunham, Surveyor, certify that I have  
surveyed the property described as follows,  
Lot 13 of Sahr's Subdivision located in the Village  
of Walworth, Walworth County, Wisconsin,  
and the above map is a true representation thereof and shows  
the size and location of the property, its exterior boundaries,  
the location and dimensions of all structures thereon, fences,  
apparent easements and roadways and visible encroachments, if  
any.

December 27, 1977

*George T. Dunham*  
George T. Dunham, Surveyor

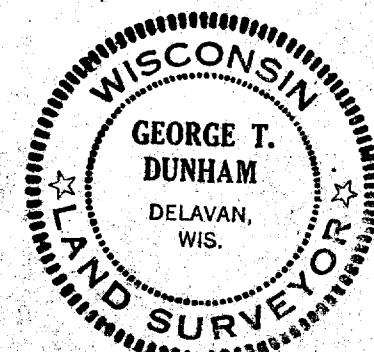

Parcel

VSS-00013