


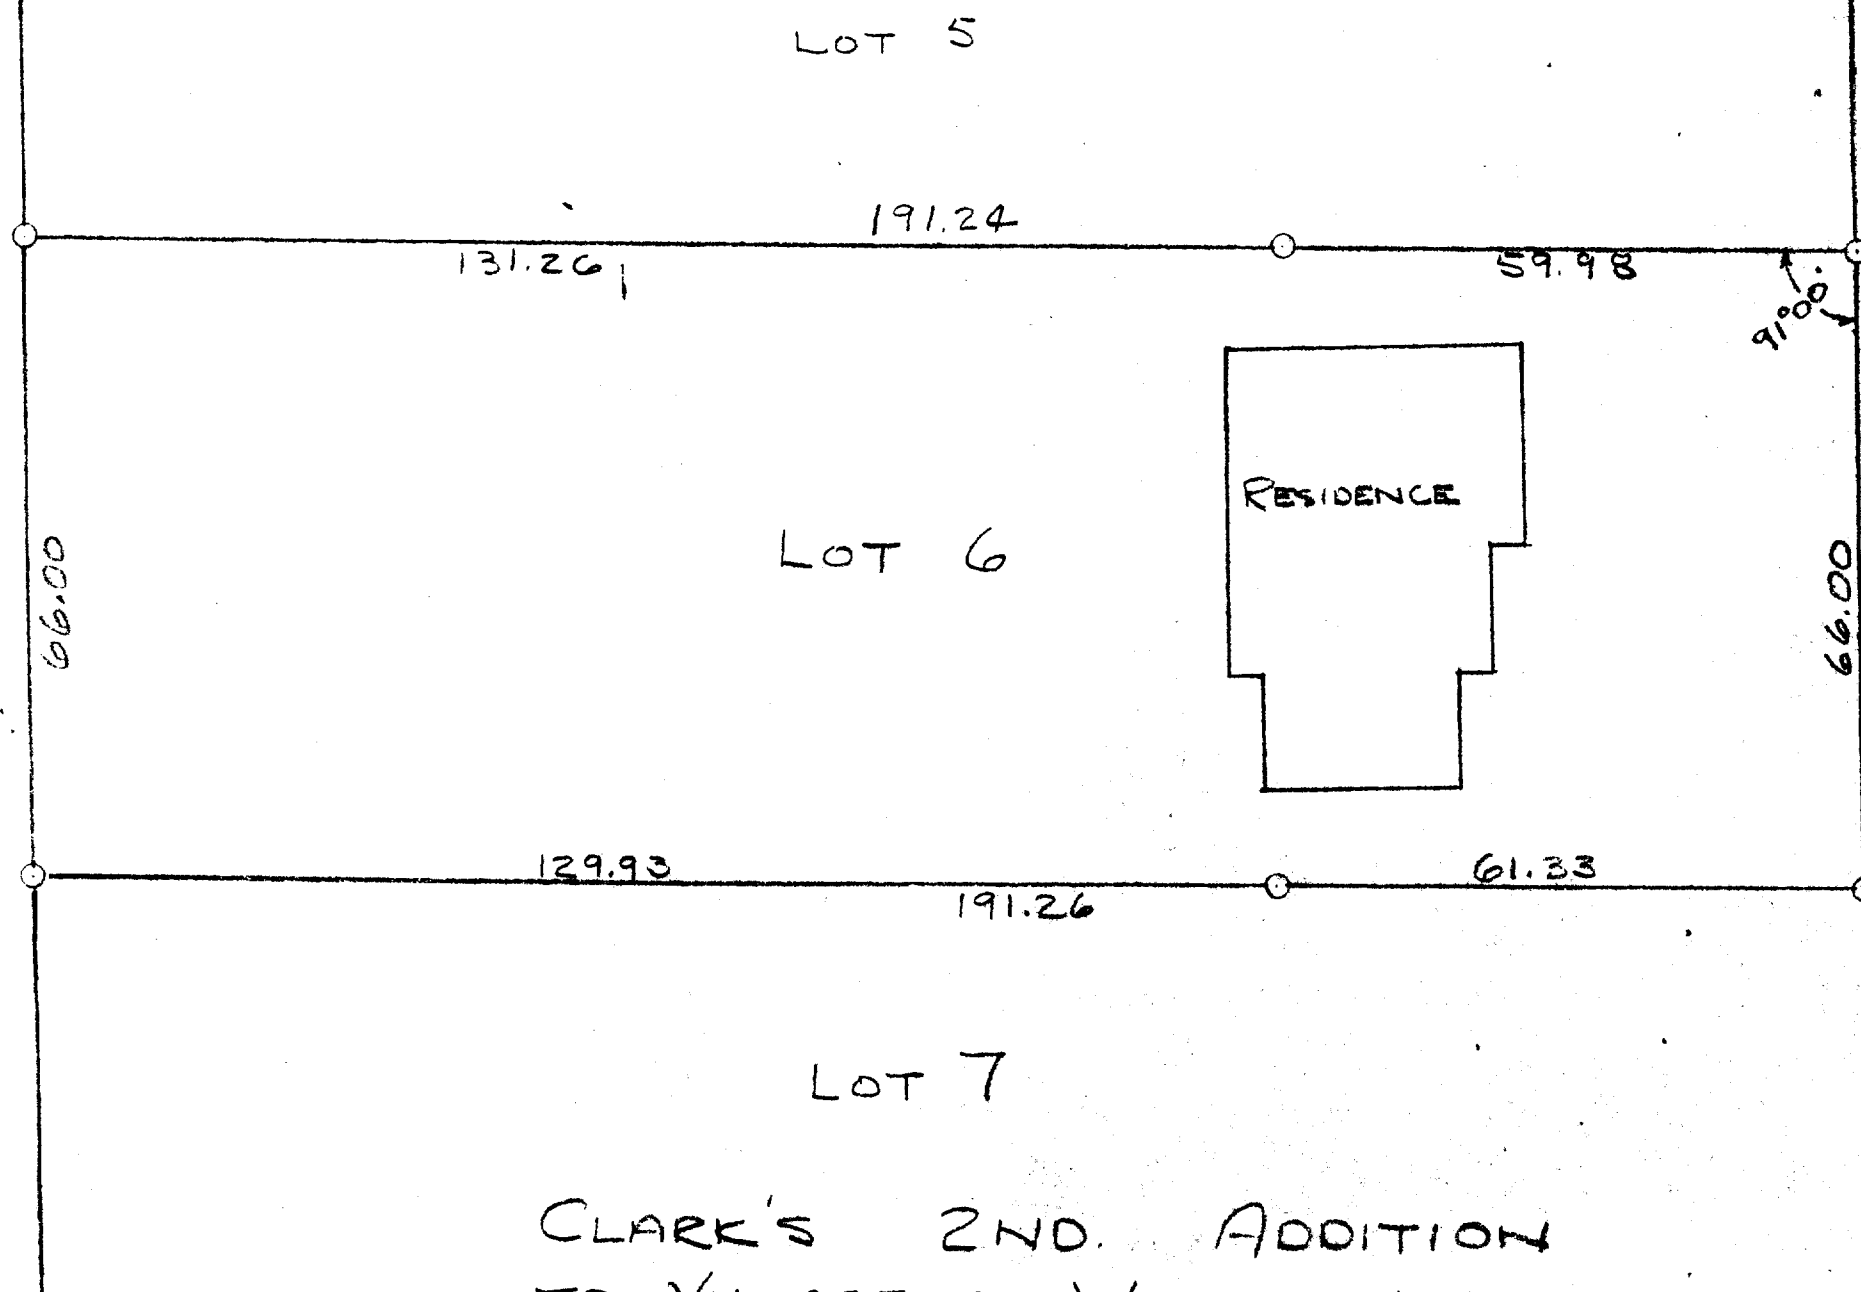

STATE OF WISCONSIN } ss
COUNTY OF WALWORTH }

I, LLOYD L. JENSEN, DO HEREBY CERTIFY THAT I HAVE
SURVEYED THE PROPERTY DESCRIBED, ACCORDING TO THE OFFICIAL
RECORDS, AS FOLLOWS:

LOT 6 OF CLARK'S 2ND. ADDITION TO THE VILLAGE OF
WALWORTH, WALWORTH COUNTY, WISCONSIN,
AND THAT THE PLAT ABOVE, IS A CORRECT REPRESENTATION
OF THE LOT LINES AND PRINCIPAL LINES OF BUILDINGS THEREON.

ELKHORN, WISCONSIN, AUGUST 7, 1950

Lloyd L. Jensen
COUNTY SURVEYOR 9-15