


SURVEYING & SUBDIVIDING

DELA VAN, WISCONSIN 53115

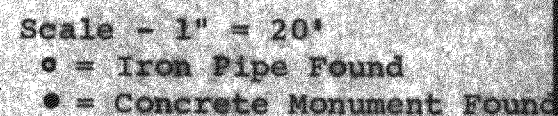

I, George T. Dunham, Surveyor, certify that I have surveyed the property described as follows:
 Lot 1 of Glenn T. Johnson Subdivision located in the Village of Walworth, Walworth County, Wisconsin,
 and the above map is a true representation thereof and shows the size and location of the property, its exterior boundaries, the location and dimensions of all structures thereon, fences, apparent easements and roadways and visible encroachments, if any.
 December 14, 1977

George T. Dunham
George T. Dunham, Surveyor

