




READ

AVENUE

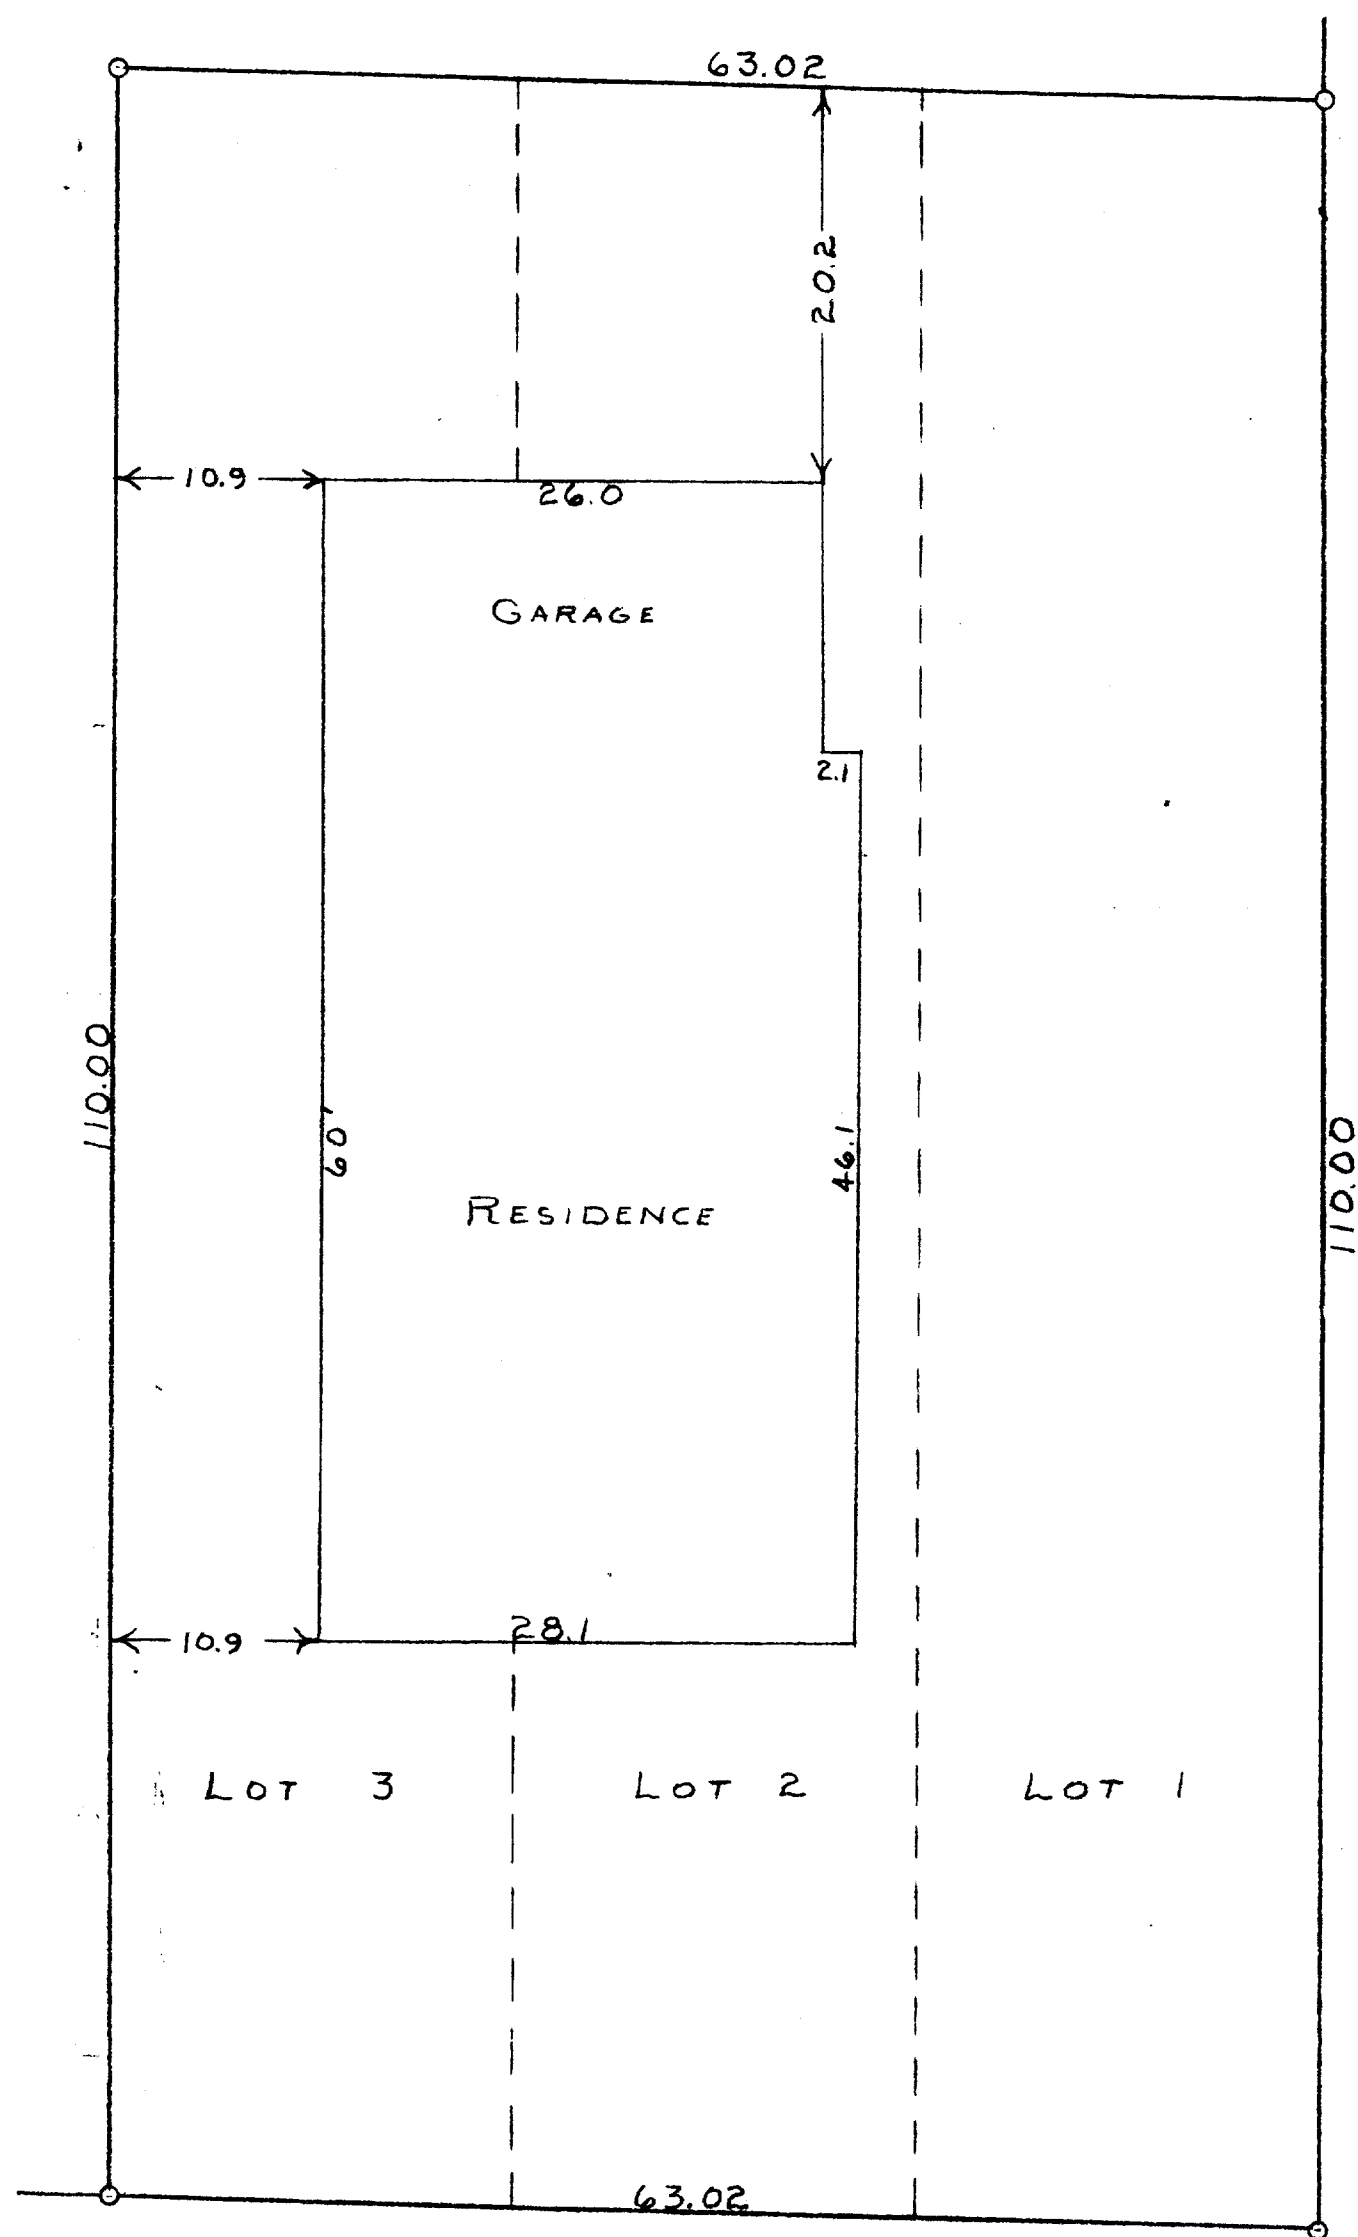

SCALE - 1" = 10'
O = IRON PIPE

2ND STREET-50' (1ST STREET ACCORDING TO RECORDED PLAT)

STATE OF WISCONSIN
WALWORTH COUNTY)

I, GEORGE T. DUNHAM, DO HEREBY CERTIFY THAT I HAVE SURVEYED THE
PROPERTY DESCRIBED AS FOLLOWS:

LOTS 1, 2, AND 3, BLOCK 7, EAST SIDE 2ND ADDITION TO THE
VILLAGE OF WALWORTH, WALWORTH COUNTY, WISCONSIN

AND THAT THE PLAT SHOWN ABOVE IS A CORRECT REPRESENTATION OF THE PROPERTY
LINES AND OF THE IMPROVEMENTS LOCATED THEREON.

DEC. 18, 1958

George T. Dunham
GEORGE T. DUNHAM, SURVEYOR
DELAVER, WISCONSIN

VES2-11

9-17