


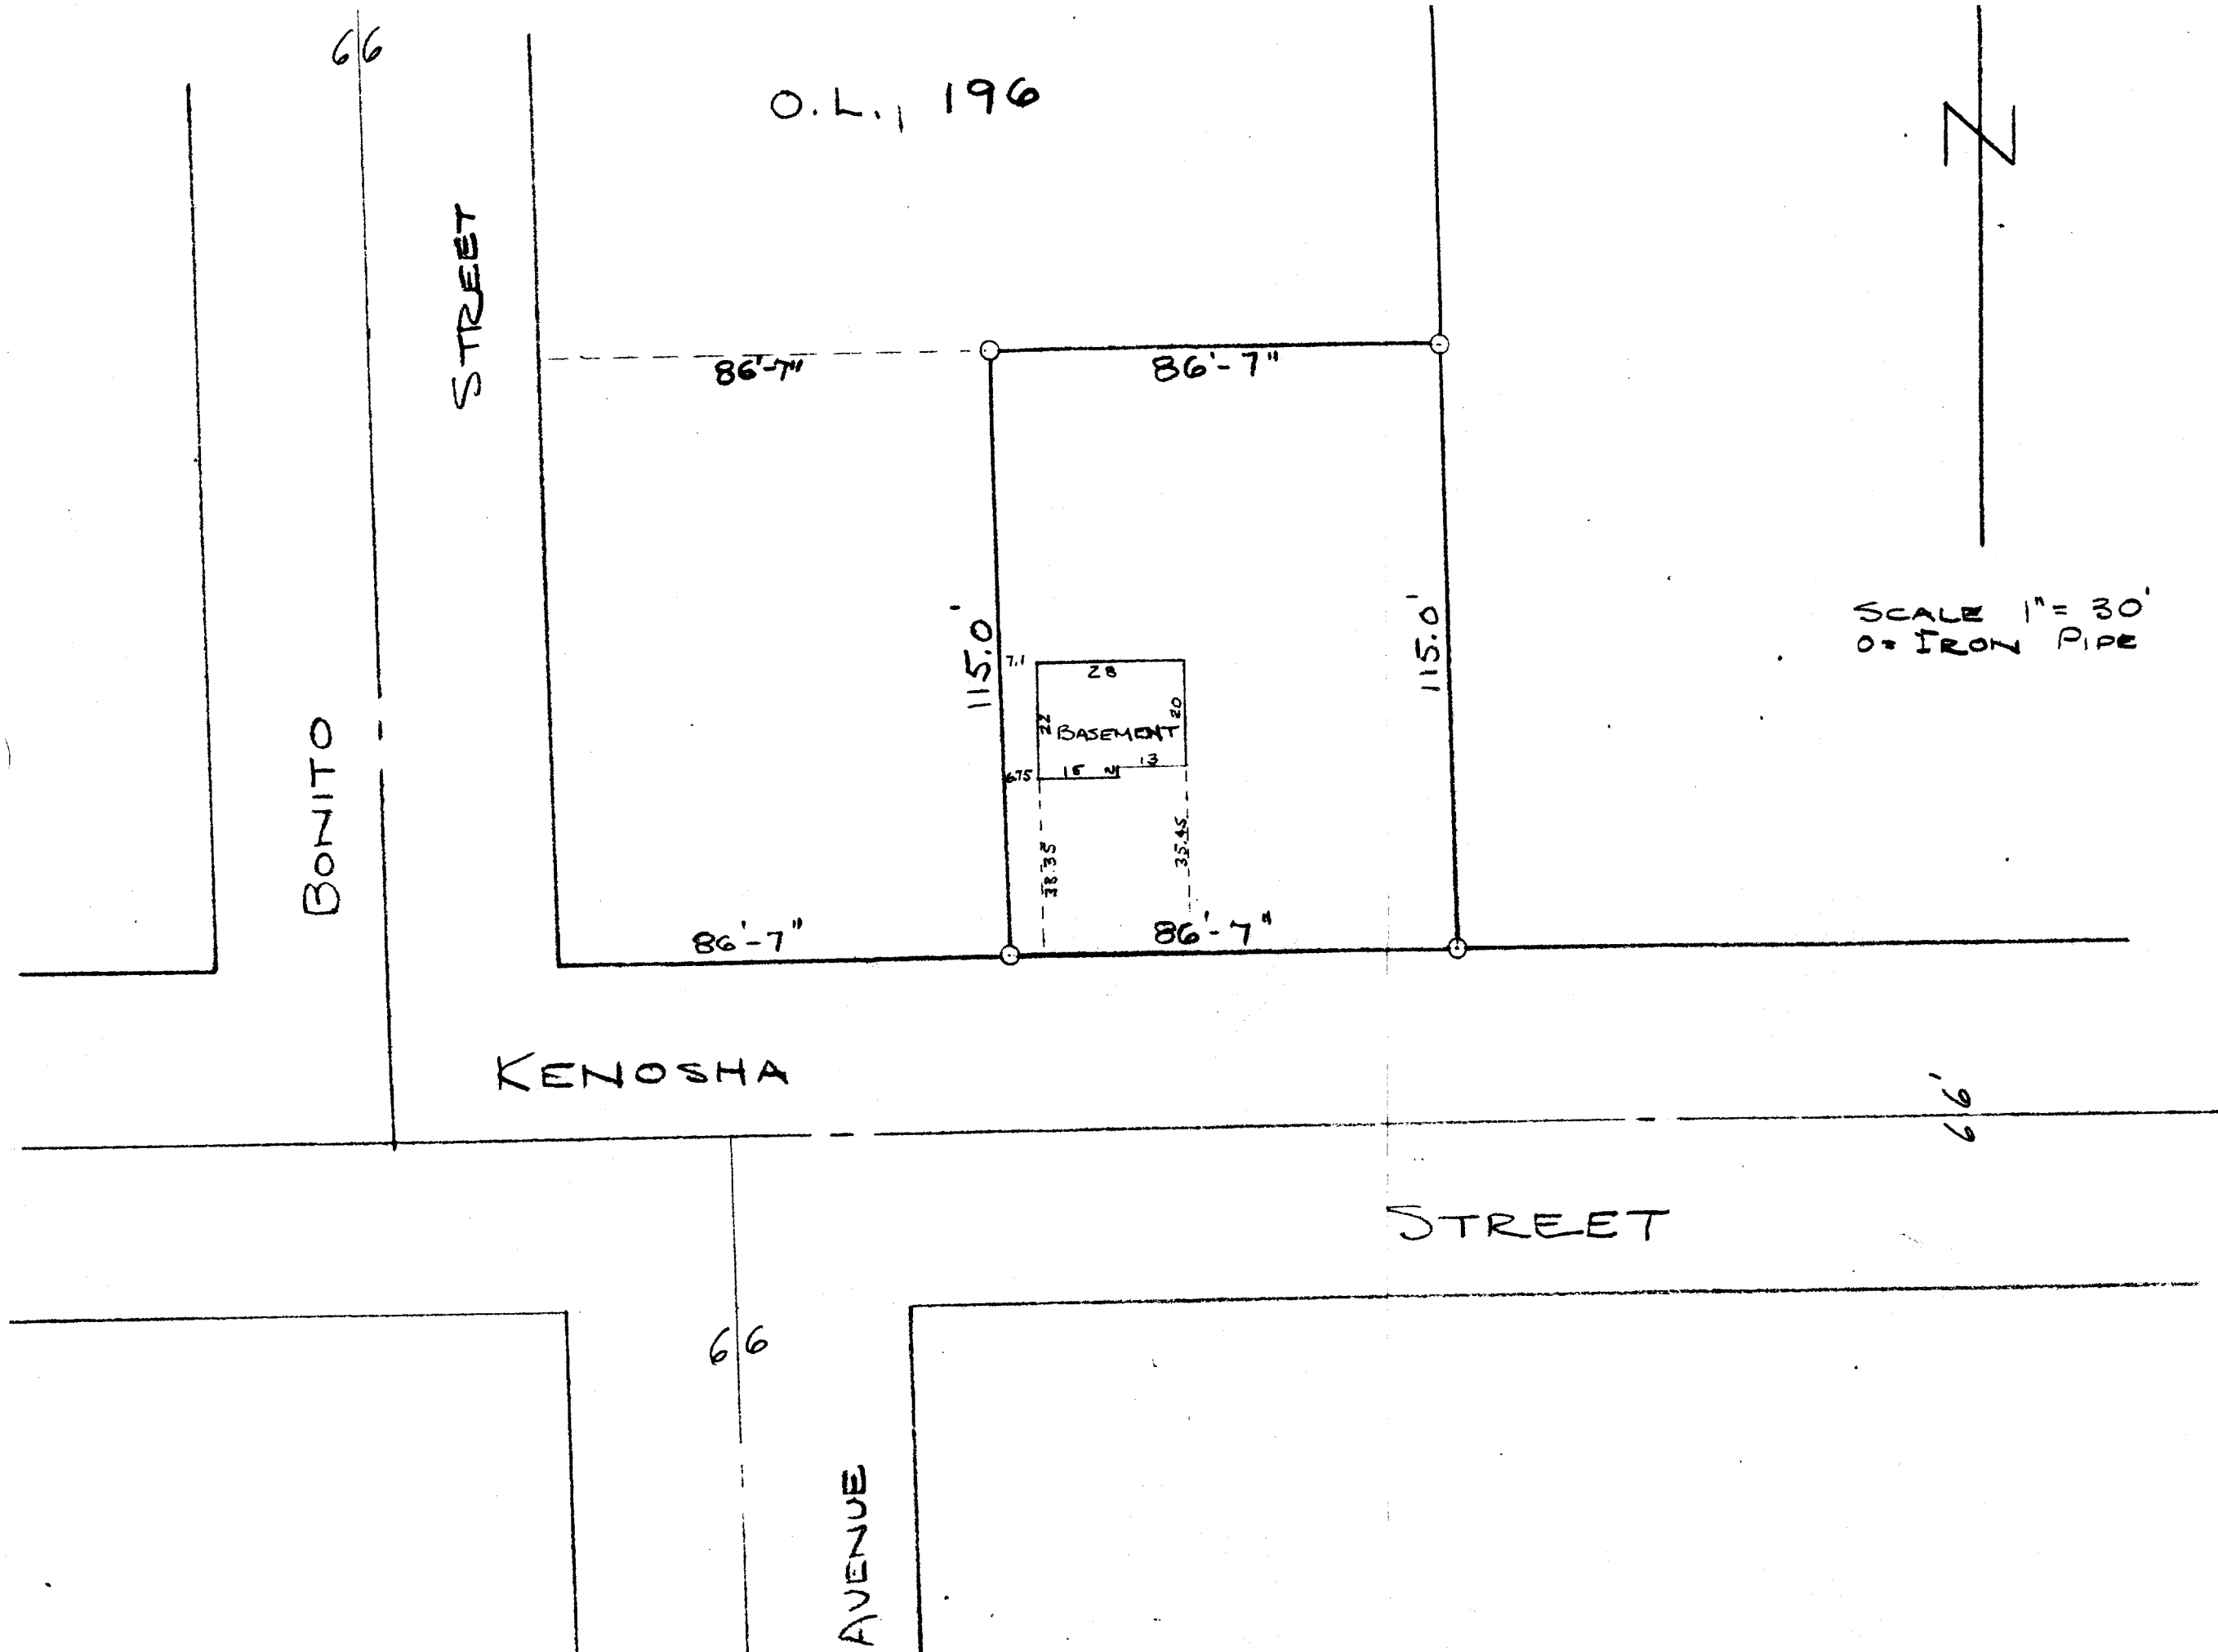

Parcel VW.P-246

STATE OF WISCONSIN)
COUNTY OF WALWORTH)

I, LLOYD L. JENSEN, DO HEREBY CERTIFY THAT THE ABOVE PLAT IS A TRUE AND CORRECT PLAT OF A SURVEY MADE ON NOVEMBER 18, 1950, OF PROPERTY LEGALLY DESCRIBED AS FOLLOWS:

PART OF OUTLOT 196 OF THE ASSESSOR'S PLAT OF THE VILLAGE OF WALWORTH, WALWORTH COUNTY, WISCONSIN; BEGINNING AT A POINT IN THE NORTH LINE OF KENOSHA STREET WHICH POINT IS 86 FEET AND 7 INCHES EAST OF THE EAST LINE OF BONITO STREET; THENCE NORTH AND PARALLEL WITH BONITO STREET 115 FEET; THENCE EAST 86 FEET 7 INCHES; THENCE SOUTH 115 FEET; THENCE WEST 86 FEET 7 INCHES TO THE PLACE OF BEGINNING.

SAID PLAT SHOWS THE LOCATION AND DIMENSIONS OF ALL BUILDING IMPROVEMENTS.

NOVEMBER 18, 1950

Lloyd L. Jensen
COUNTY SURVEYOR 9-170