

PLAT OF SURVEY

Of Outlot 93, Assessors
Plat, Village of Walworth,
Walworth Co., Wisconsin

Chisel cross on
South Line
of 20' Roadway

N

Scale 1"=30'

Legend

- Iron Rod Set 1/2" x 24"
- Iron Rod Found
- X Chisel Mark

I certify that I have surveyed the
above described property and that
the plat shown hereon is an accurate
survey and a true representation
thereof and correctly shows the bound-
ary lines of said property and all
divisions thereof.

May 26, 1978


Thomas P. A. Jensen

Thomas P. A. Jensen
Jensen Surveying and Mapping
Elkhorn, Wisconsin

Owner: JEFF DIXON

2

MAIN ST.

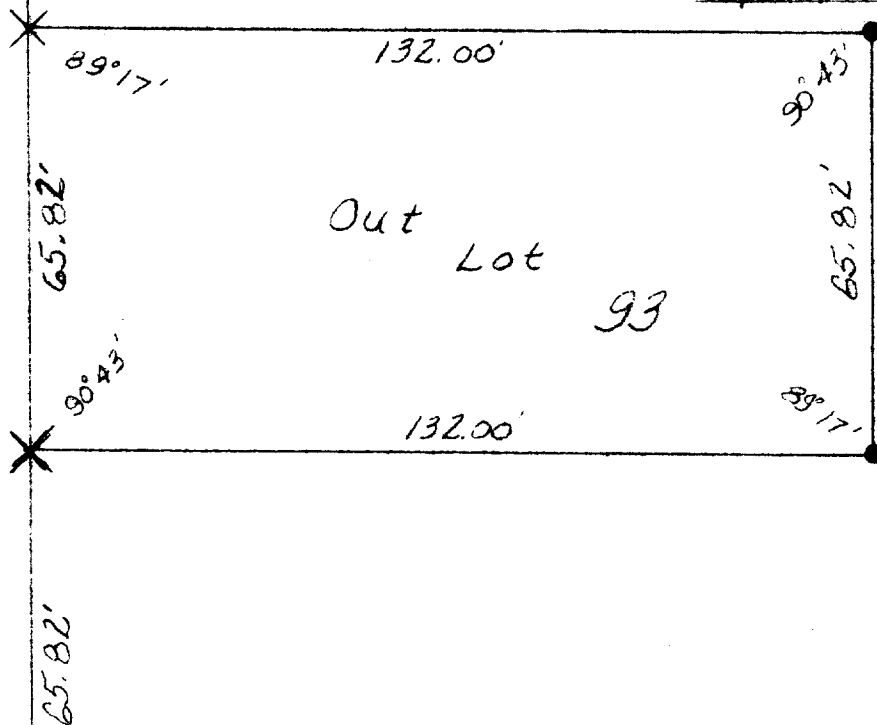

HOWARD ST.

Found Iron Rod,
North Line of Howard Street

