


PLAT OF SURVEY
FOR THE SUBDIVISION OF OUTLOT 104
OF THE ASSESSOR'S PLAT OF THE VIL.
OF WALWORTH, WALWORTH CO., WIS.

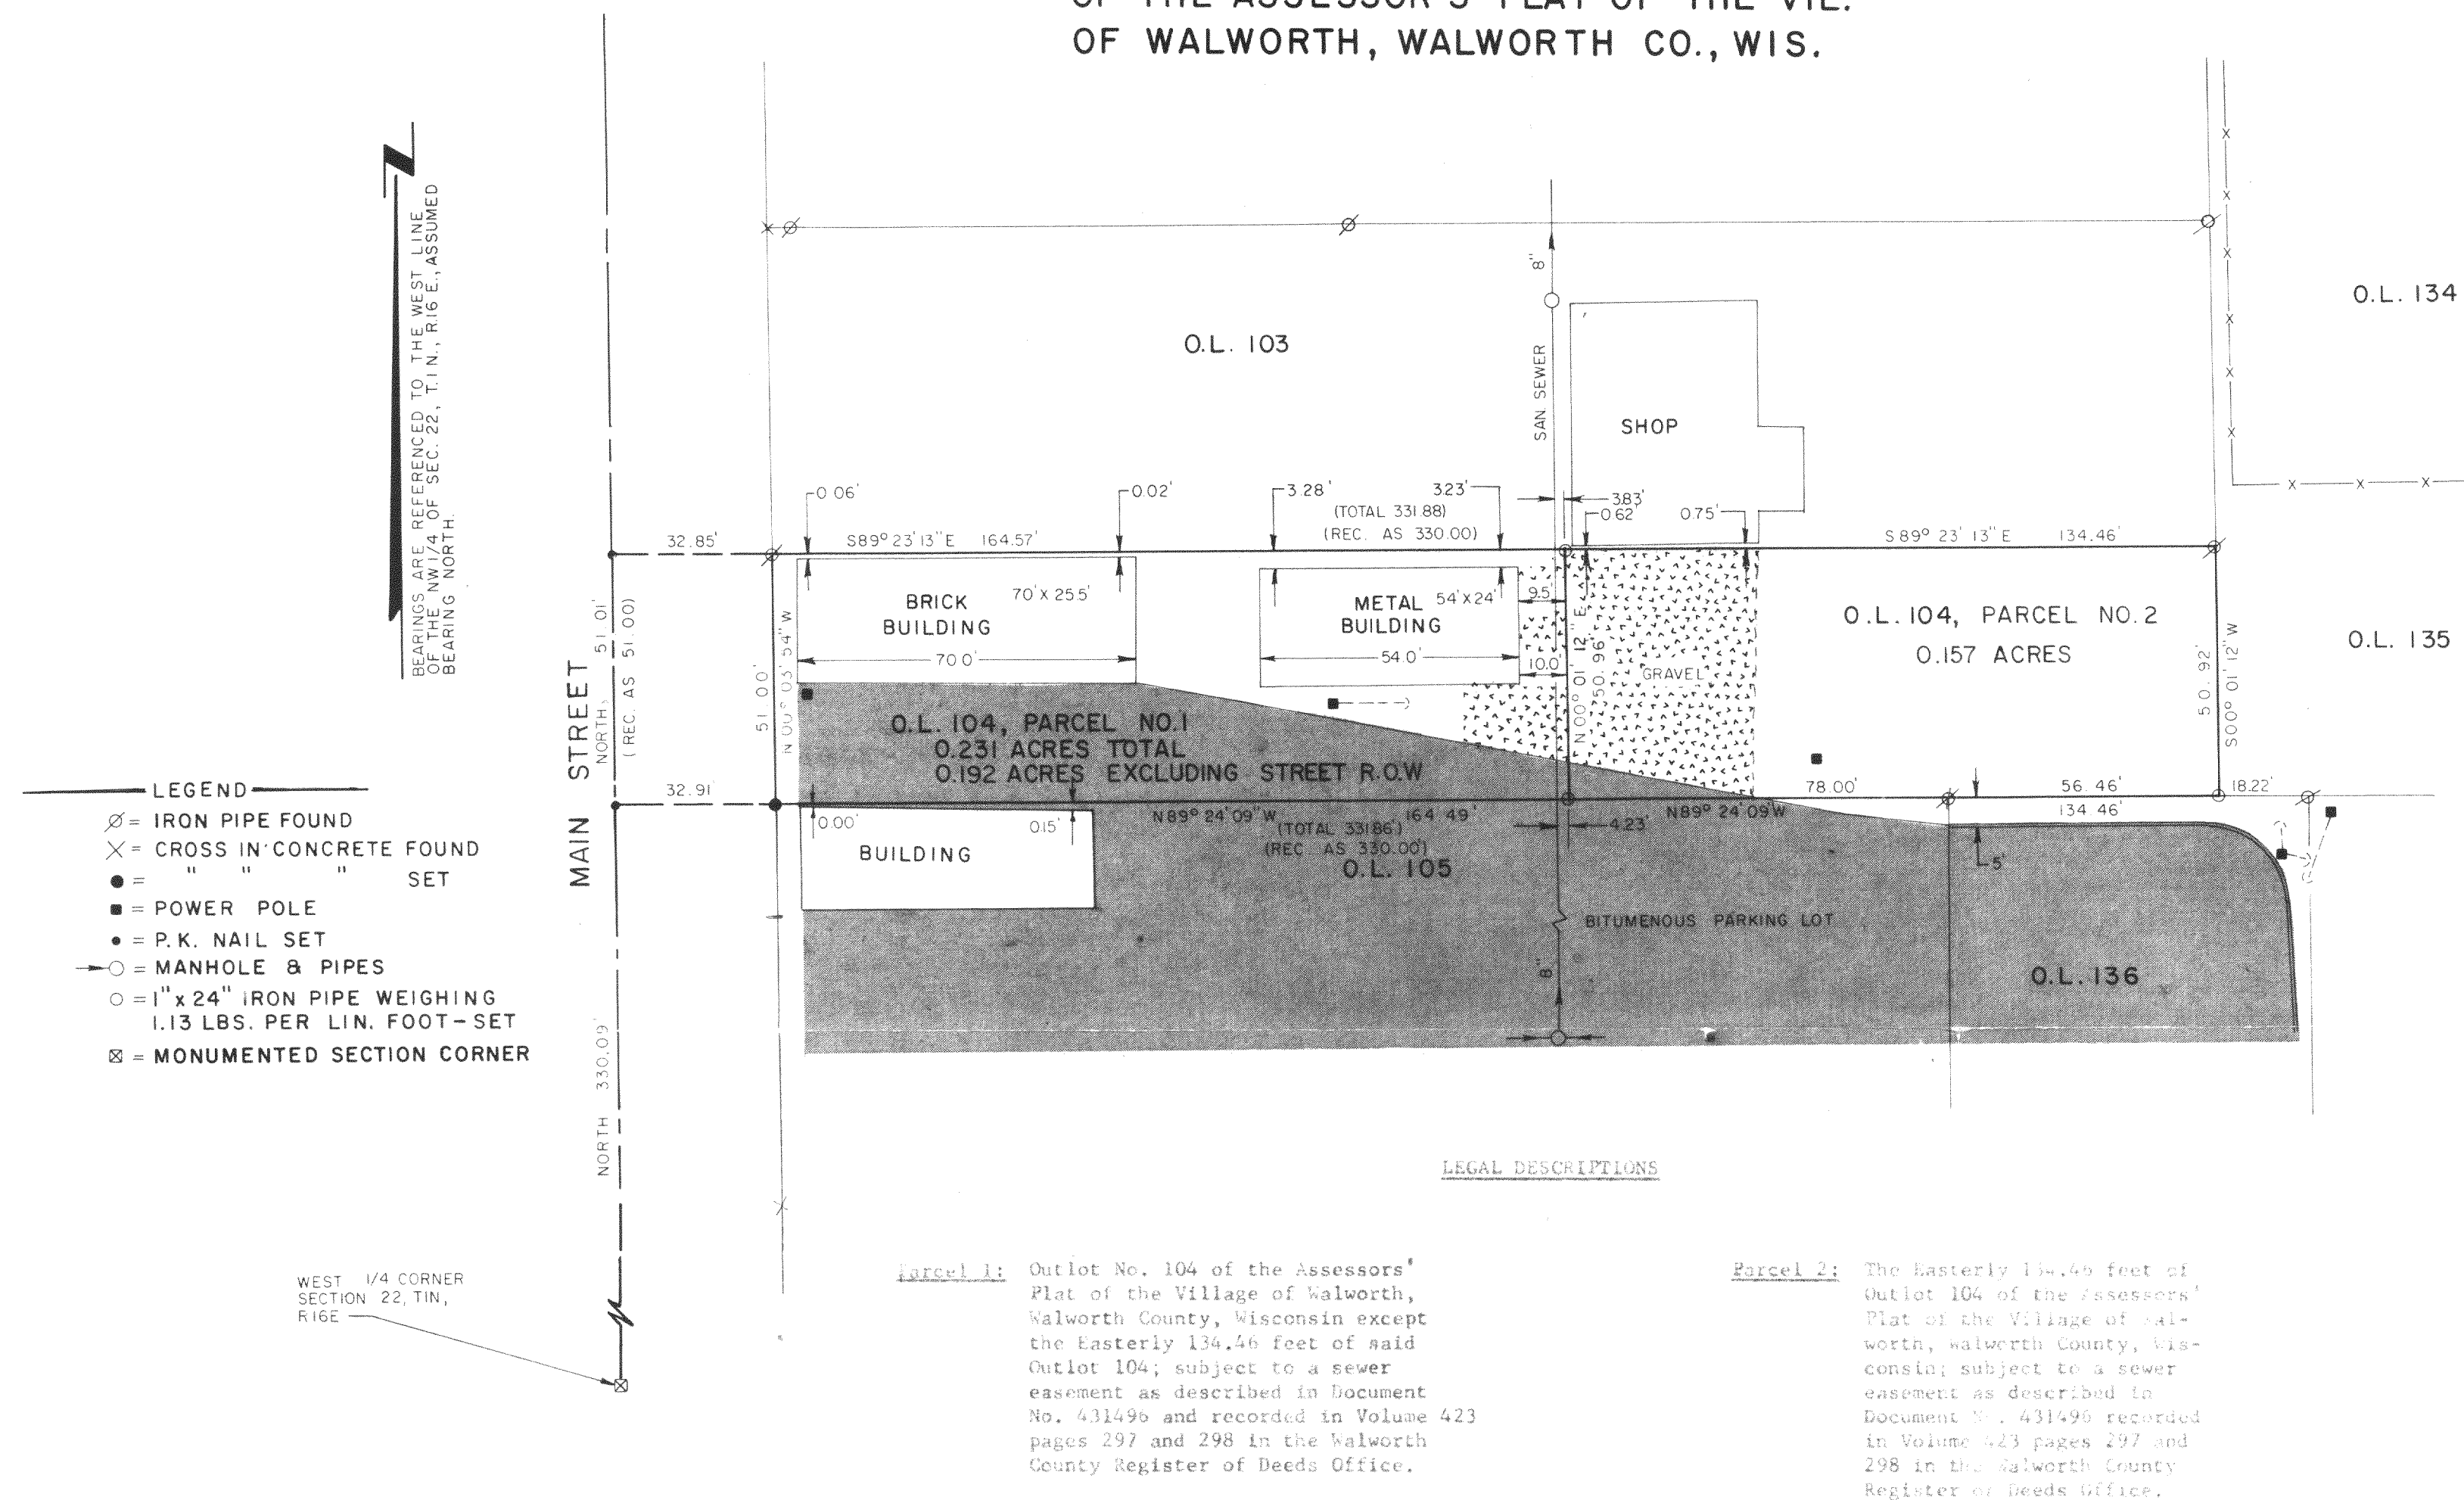

Surveyors Certificate

I, Donald E. Zenz, Registered Land Surveyor, do hereby certify that the plat shown hereon is a true and accurate survey and a true representation thereof and the exterior boundary lines and all divisions of said property have been surveyed under my direction and to the best of my knowledge and belief.

Dated This 16th day of May, 1979

Donald E. Zenz, R.L.S. S-1088

JENSEN & JOHNSON

ENGINEERS AND SURVEYORS

PO BOX 290, ELKHORN, WISCONSIN

414-723-3204

A Division of

Donohue & Associates, Inc.



Date

MAY 9, 1979

Scale

1" = 30'

Drawn By

J.S. KLARKOWSKI

Surveyed For

CHARLES PATTEN

Checked By

D. E. ZENZ

Project No.

10269.0