


NW CORNER OF THE SW 1/4
OF THE SW 1/4 OF SECTION
22, T1N R16E

SCALE 1"=20'
O=IRON PIPE

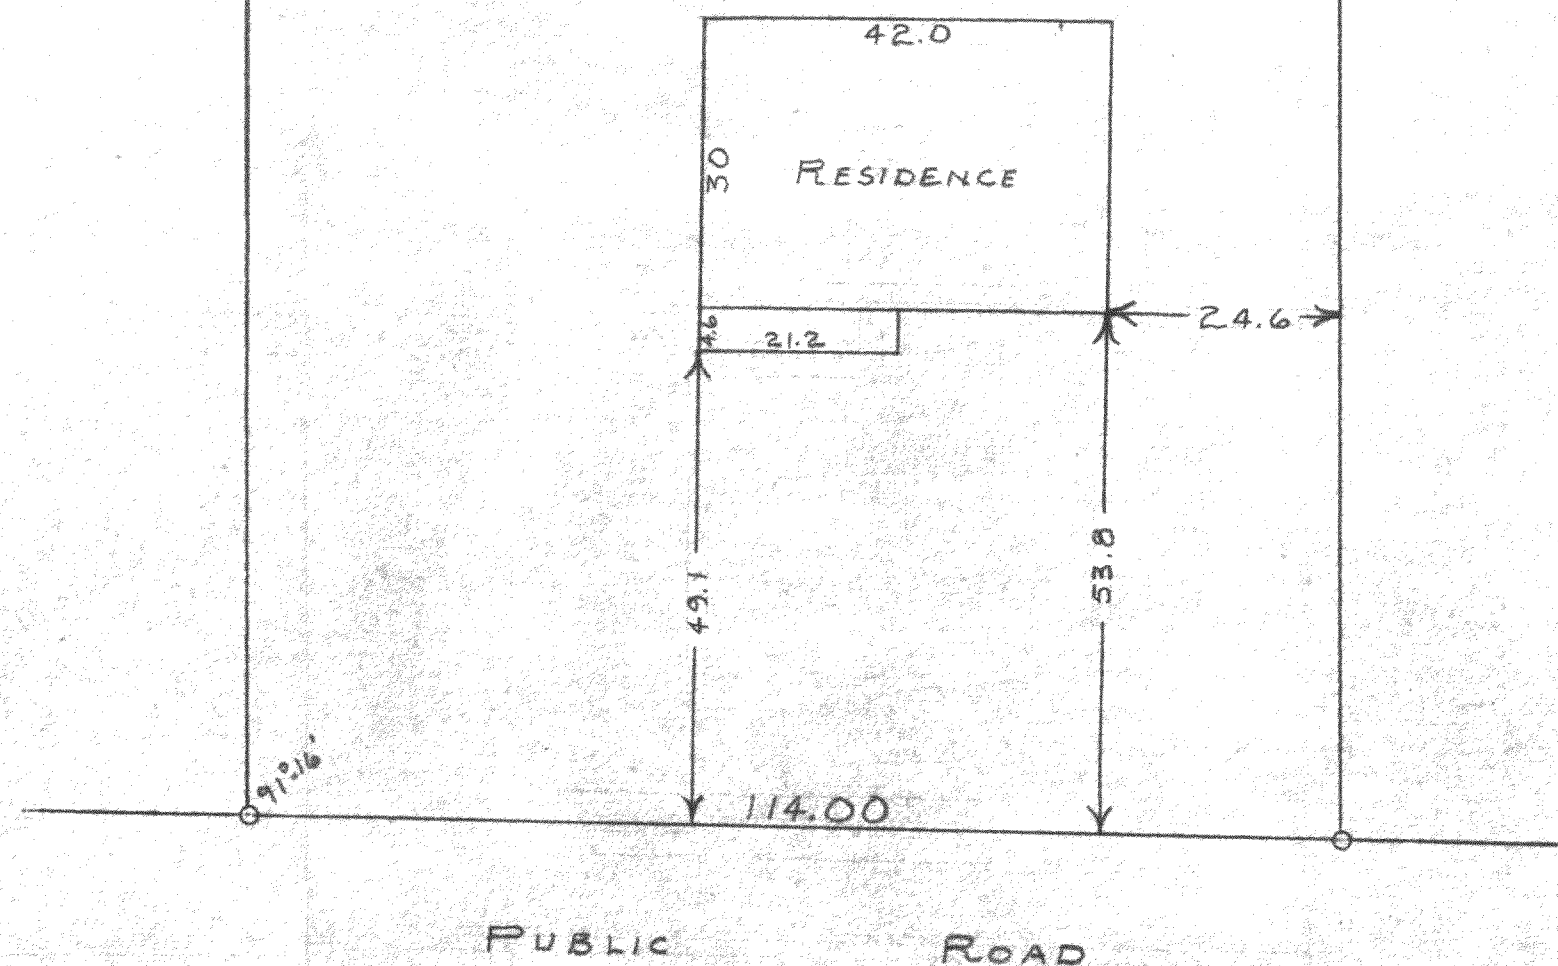

STATE OF WISCONSIN)
WALWORTH COUNTY)SS

I, GEORGE T. DUNHAM, DO HEREBY CERTIFY THAT I HAVE SURVEYED THE PROPERTY DESCRIBED
AS FOLLOWS:

A PARCEL OF LAND LOCATED IN OUTLOT 222 OF THE ASSESSORS PLAT OF THE VILLAGE OF
WALWORTH, WALWORTH COUNTY, WISCONSIN, OR ALSO DESCRIBED AS BEING LOCATED IN THE
SW 1/4 OF THE SW 1/4 OF SECTION 22, T1N R16E OF WALWORTH COUNTY WIS, DESCRIBED AS
FOLLOWS, TO WIT: COMMENCING AT THE NW CORNER OF SAID SW 1/4 OF THE SW 1/4 OF SAID
SECTION 22, THENCE SOUTH ALONG THE WEST LINE OF SAID SECTION 258.00 FEET; THENCE EAST
PARALLEL WITH THE EAST-WEST 1/8TH SECTION LINE OF SAID SW 1/4, 233.00 FEET TO THE PLACE
OF BEGINNING; THENCE SOUTH PARALLEL TO THE WEST LINE OF SAID SOUTHWEST 1/4, 200.00
FEET; THENCE EAST PARALLEL TO SAID EAST-WEST 1/8TH SECTION LINE 114.00 FEET; THENCE
NORTH PARALLEL TO THE WEST LINE OF SAID SOUTHWEST 1/4, 200.00 FEET; THENCE WEST PARALLEL
TO SAID EAST-WEST 1/8TH SECTION LINE 114.00 FEET TO THE PLACE OF BEGINNING.

AND THAT THE PLAT SHOWN ABOVE IS A CORRECT REPRESENTATION OF THE PROPERTY LINES AND OF THE
IMPROVEMENTS LOCATED THEREON
SEPT. 18, 1958

George T. Dunham
GEORGE T. DUNHAM, SURVEYOR
DELAVER, WISCONSIN

9-19

VWP-311