


Point described as being 503 feet South of the Northwest corner of the Southwest 1/4 of the Southwest 1/4 of Section 22, T1N, R16E, Walworth County, Wisconsin.

DUNHAM SURVEYING, S.C.
SURVEYING & SUBDIVIDING
DELAVER, WISCONSIN 53115

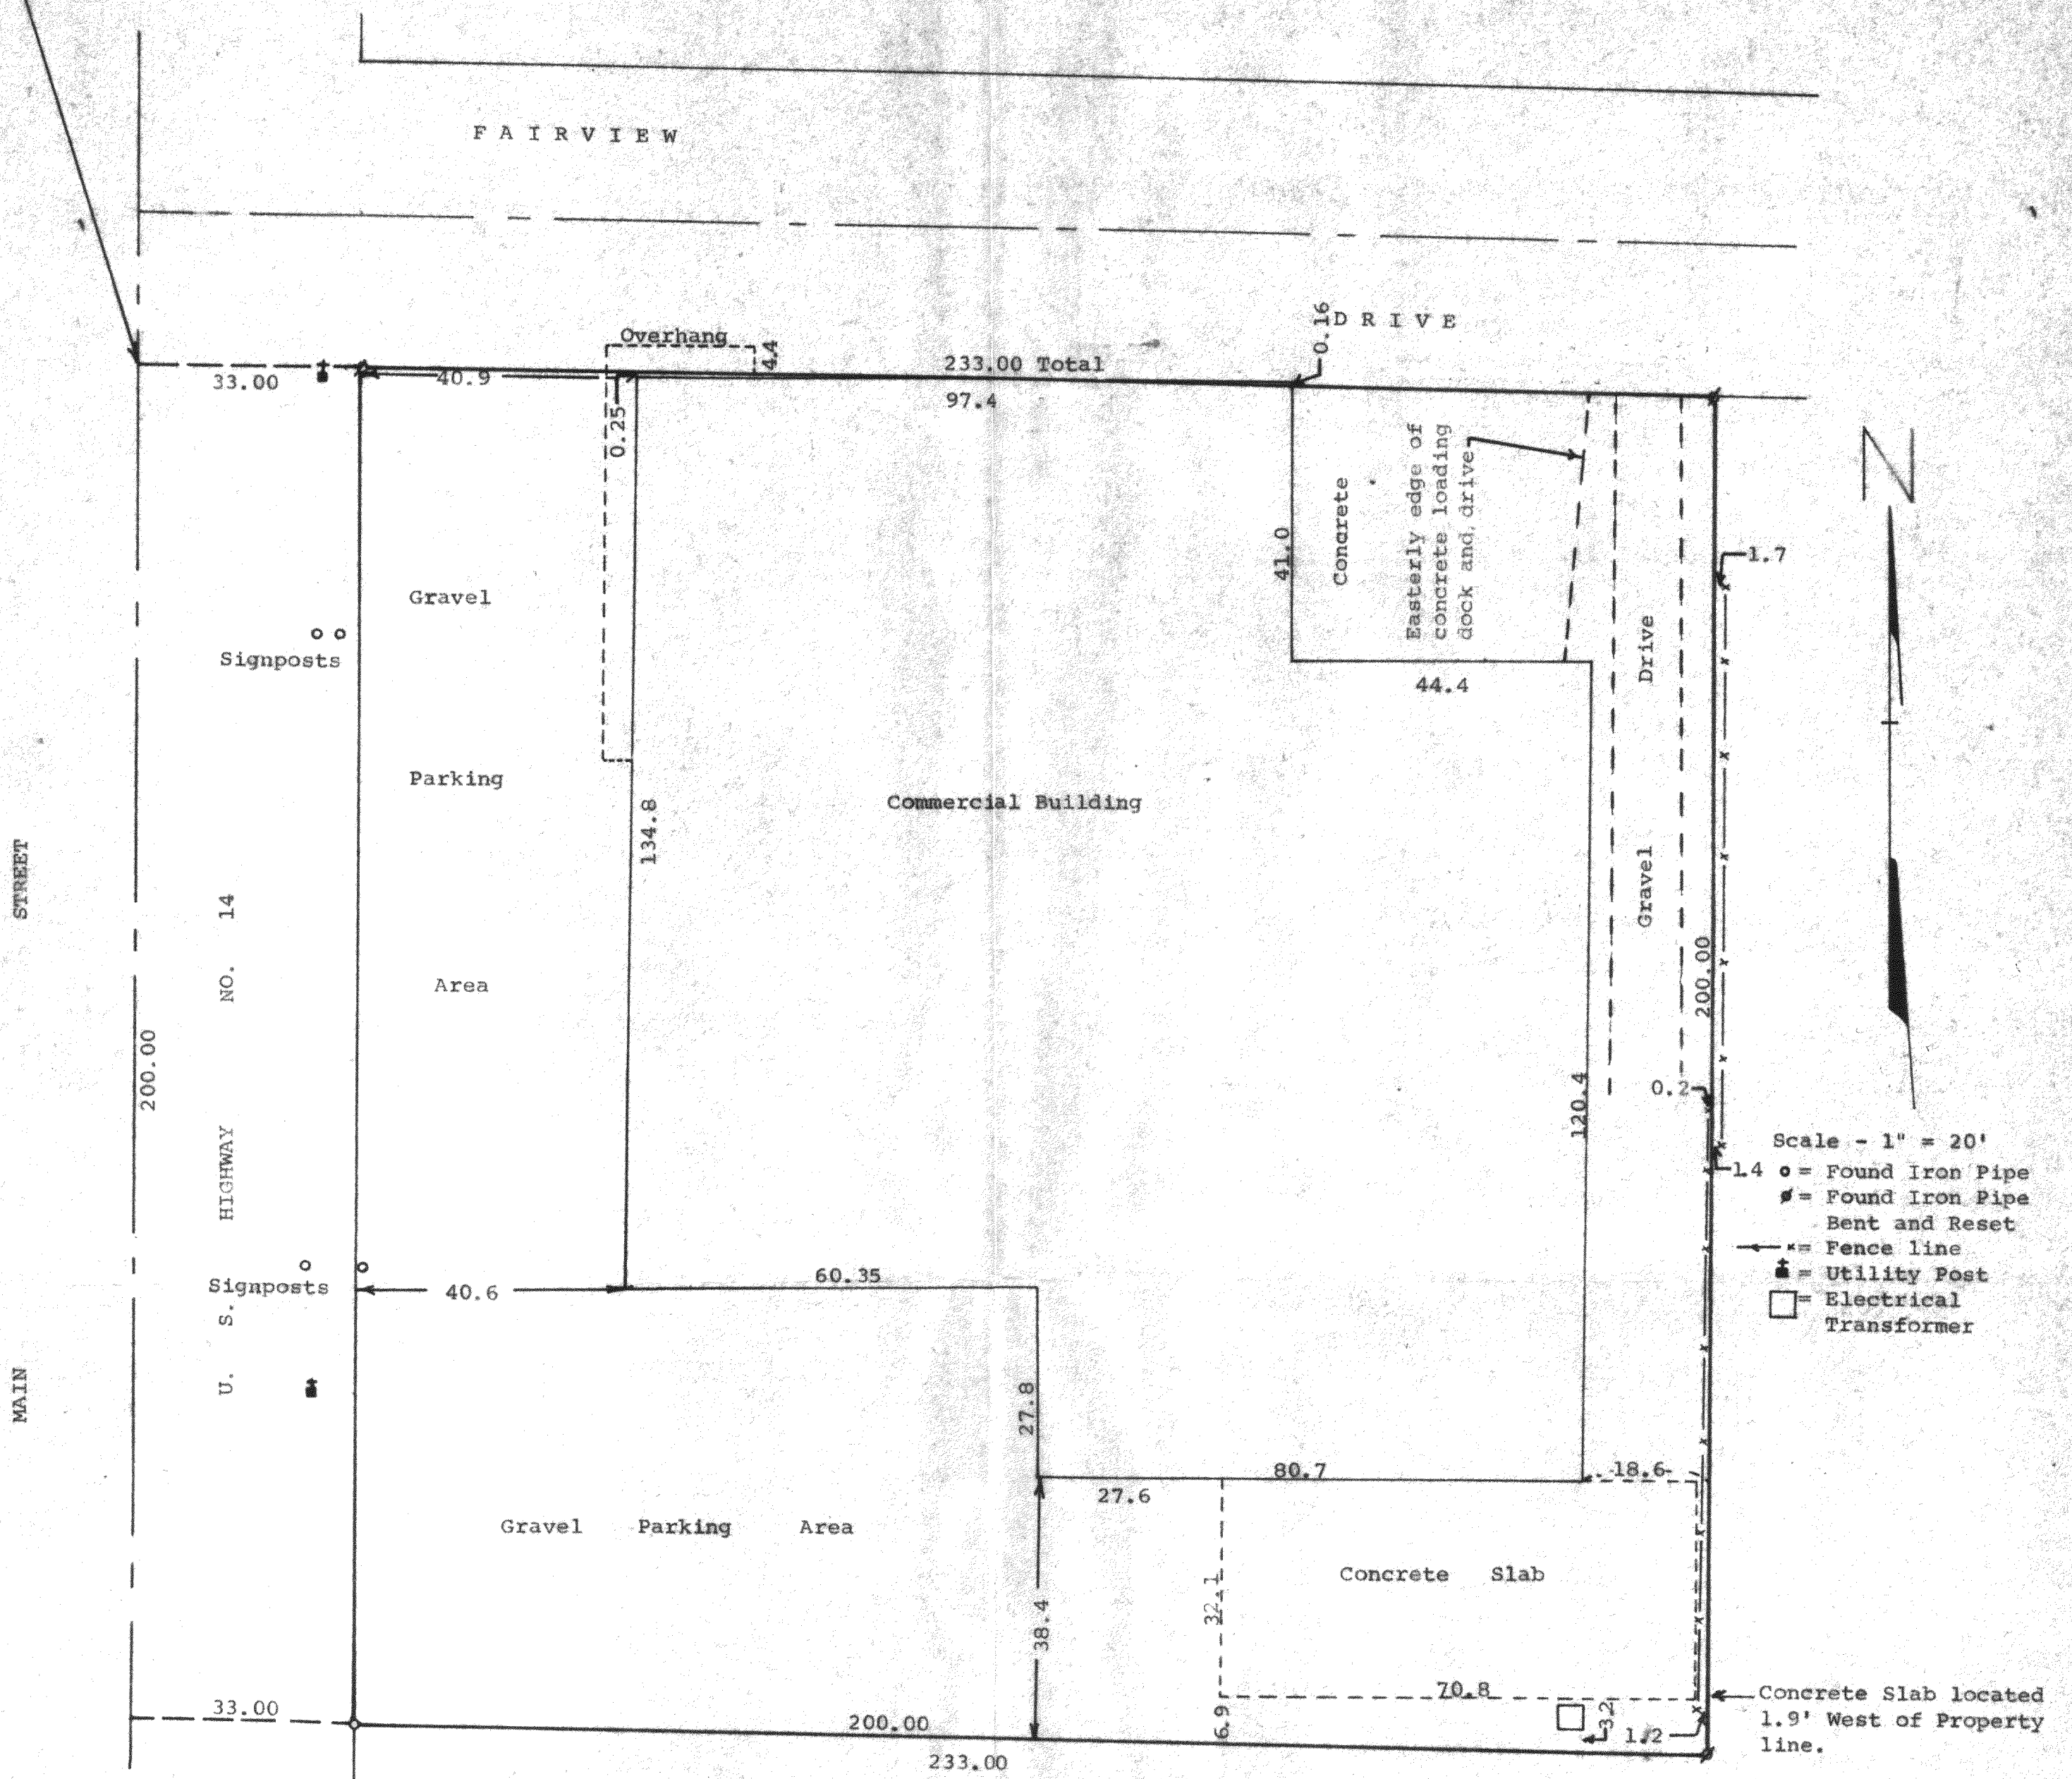

STATE OF WISCONSIN)
COUNTY OF WALWORTH) SS

I, George T. Dunham, Surveyor, certify that I have surveyed the property described as follows,

A parcel of land located in the Southwest 1/4 of the Southwest 1/4 of Section 22, T1N, R16E, Walworth County, Wisconsin, described as follows: Beginning at a point in the West line of said Section which point is located 503 feet South of the Northwest corner of the Southwest 1/4 of the Southwest 1/4 of said Section; thence East parallel to the East-West 1/8 Section line in said Southwest 1/4, 233.00 feet to an iron pipe; thence South parallel to the West line of said Section 200.00 feet to an iron pipe; thence West parallel to said 1/8 Section line 233.00 feet to the West line of said Section; thence North along the west line of said Section 200.00 feet to the place of beginning, said land being located in the Village of Walworth,

and that the above map is a true representation thereof and shows the size and location of the property, its exterior boundaries, the location of all visible structures and dimensions of all principal buildings thereon, boundary fences, apparent easements, roadways and visible encroachments, if any.

This survey is made for the use of the present owners of the property, and also those who purchase, mortgage, or guarantee the title thereto within one (1) year from date hereof.

January 18, 1980

George T. Dunham
George T. Dunham, Surveyor

