


SURVEYING & SUBDIVIDING
DELAN, WISCONSIN 53115

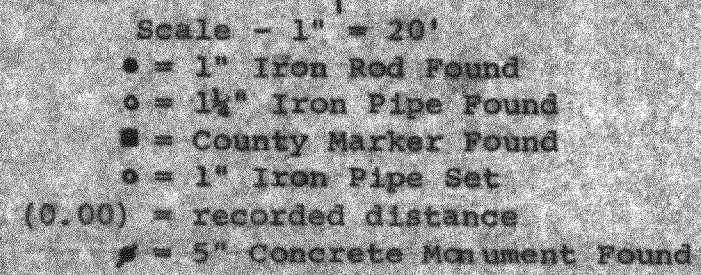

STATE OF WISCONSIN)
COUNTY OF WALWORTH) SS

Outlet 203 of the Assessor's Plat of the Village of Walworth,
Walworth County, Wisconsin EXCEPTING the East 65.00 feet of
said Outlet.

and that the plat shown above is a true representation thereof and shows the size and location of the property, its exterior boundaries, the location of all visible structures and dimensions of all principal buildings thereon, boundary fences, apparent easements, roadways and visible encroachments, if any, and that I have surveyed the property hereon described according to the official records, to the best of my knowledge and belief.

April 9, 1984

George T. Dunham
George T. Dunham, Surveyor