


KOLB LAND CONSULTING, INC.
LAND SURVEYING • SUBDIVIDING • LAND PLANNING

LAKE GENEVA, WISCONSIN 53147

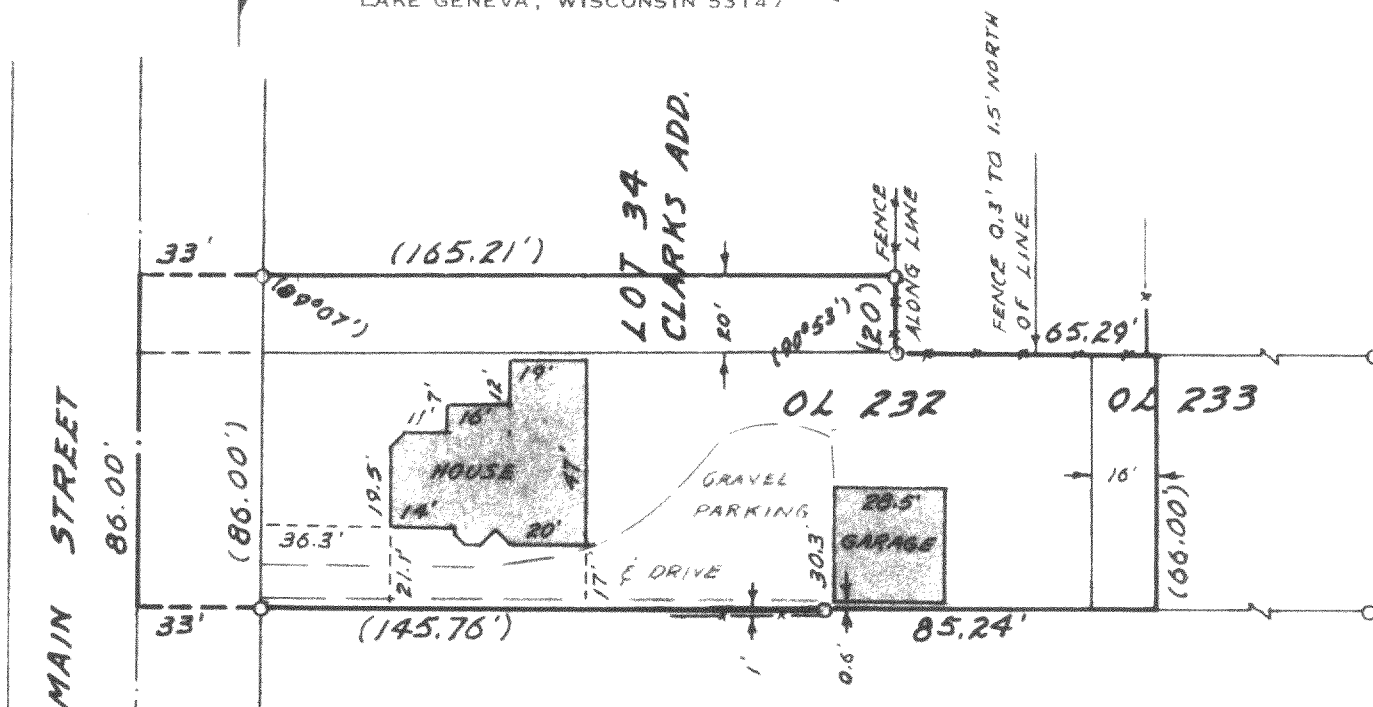

MORTGAGE INSPECTION OF


OUTLOT 232, THE WEST 16 FEET OF OUTLOT 233,
ASSESSOR'S PLAT, AND THE SOUTH 20 FEET OF LOT
34 CLARK'S ADDITION, ALL IN THE VILLAGE OF
WALWORTH, WALWORTH COUNTY, WISCONSIN.

ORDERED BY: ANCHOR SAVINGS & LOAN ASSOCIATION
500 E. WALWORTH AVE.
DELAVAN, WI. 53115

BUYER: KENT A. & MARTHA A. JOHNSON

TAX PARCELS: VCA-46, VWP-338 & VWP 339

NOTE: COMPLIANCE WITH A-E 3, 5(F), 6(A), (B), (C), (D), AND 7 HAS
BEEN WAIVED BY THE CLIENT, IN AGREEMENT WITH THE SURVEYOR,
AS PERMITTED IN A-E 5.01(B).

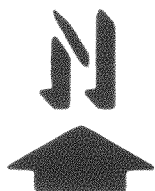

SCALE: 1"=50'

LEGEND
○ IRON PIPE FOUND
(5.7') AS SHOWN ON RECORDED
SURVEYS
-x- FENCE

Harold H. Kolb
HAROLD H. KOLB

WISCONSIN REGISTERED LAND SURVEYOR, S- 187
DATE MARCH 20, 1984

VWP-338 + 339

VCA-46

9-231✓