



ANDERSON LAND SURVEYING

DELAVAL, WIS. 53115

728-2525

PLAT OF SURVEY

PREPARED FOR: *Citizen's Bank of
Delavan, WI*


PREPARED BY: *Anderson Land
Surveying
Delavan, WI*

SCALE: 1" EQUALS 40'

O=IRON PIPE FOUND

●=IRON ROD W/CAP SET

X=CHISEL CROSS SET

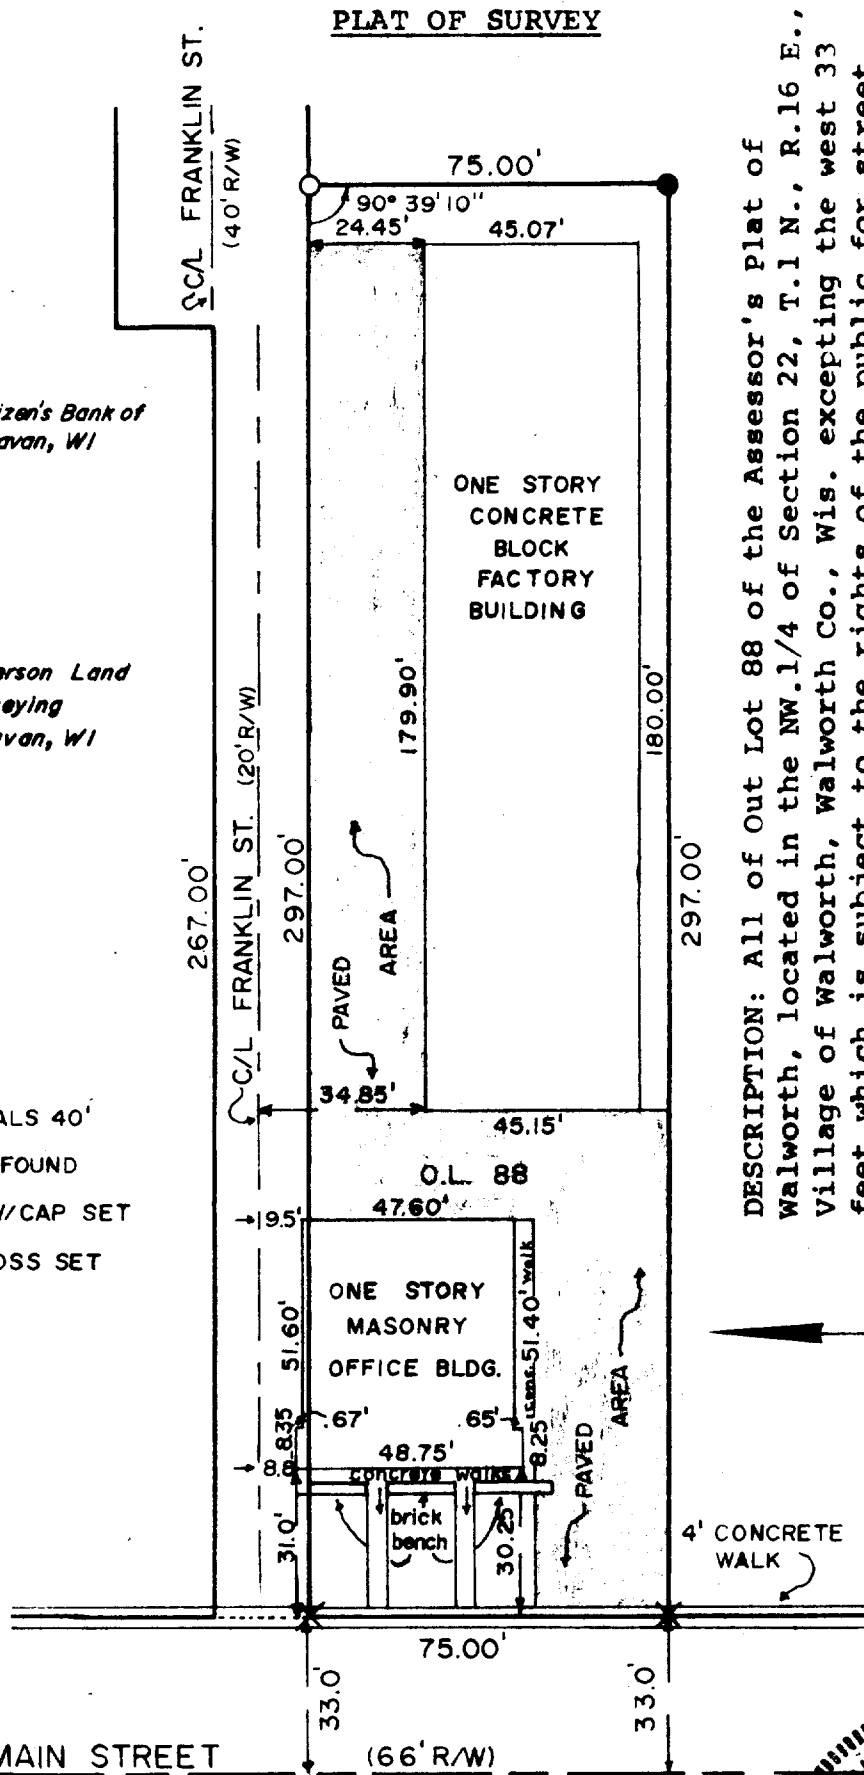

DESCRIPTION: All of Out Lot 88 of the Assessor's Plat of Walworth, located in the NW.1/4 of Section 22, T.1 N., R.16 E., Village of Walworth, Walworth Co., Wis. excepting the west 33 feet which is subject to the rights of the public for street purposes.



SURVEYOR'S CERTIFICATE

I HEREBY CERTIFY THAT I HAVE SURVEYED THE ABOVE DESCRIBED PROPERTY AND THE ABOVE MAP IS A TRUE REPRESENTATION THEREOF AND SHOWS THE SIZE AND LOCATION OF THE PROPERTY, ITS EXTERIOR BOUNDARIES, THE LOCATION AND DIMENSIONS OF ALL VISIBLE STRUCTURES THEREON. THIS SURVEY IS MADE FOR THE EXCLUSIVE USE OF THE PRESENT OWNERS OF THE PROPERTY, AND ALSO THOSE WHO PURCHASE, MORTGAGE, OR GUARANTEE THE TITLE THERETO WITHIN ONE (1) YEAR FROM DATE HEREOF.

DATE 27 Aug. 1984

SURVEYOR Ralph L. Anderson

JOB NO. 23384

DLW

VWP-101

9-233✓