

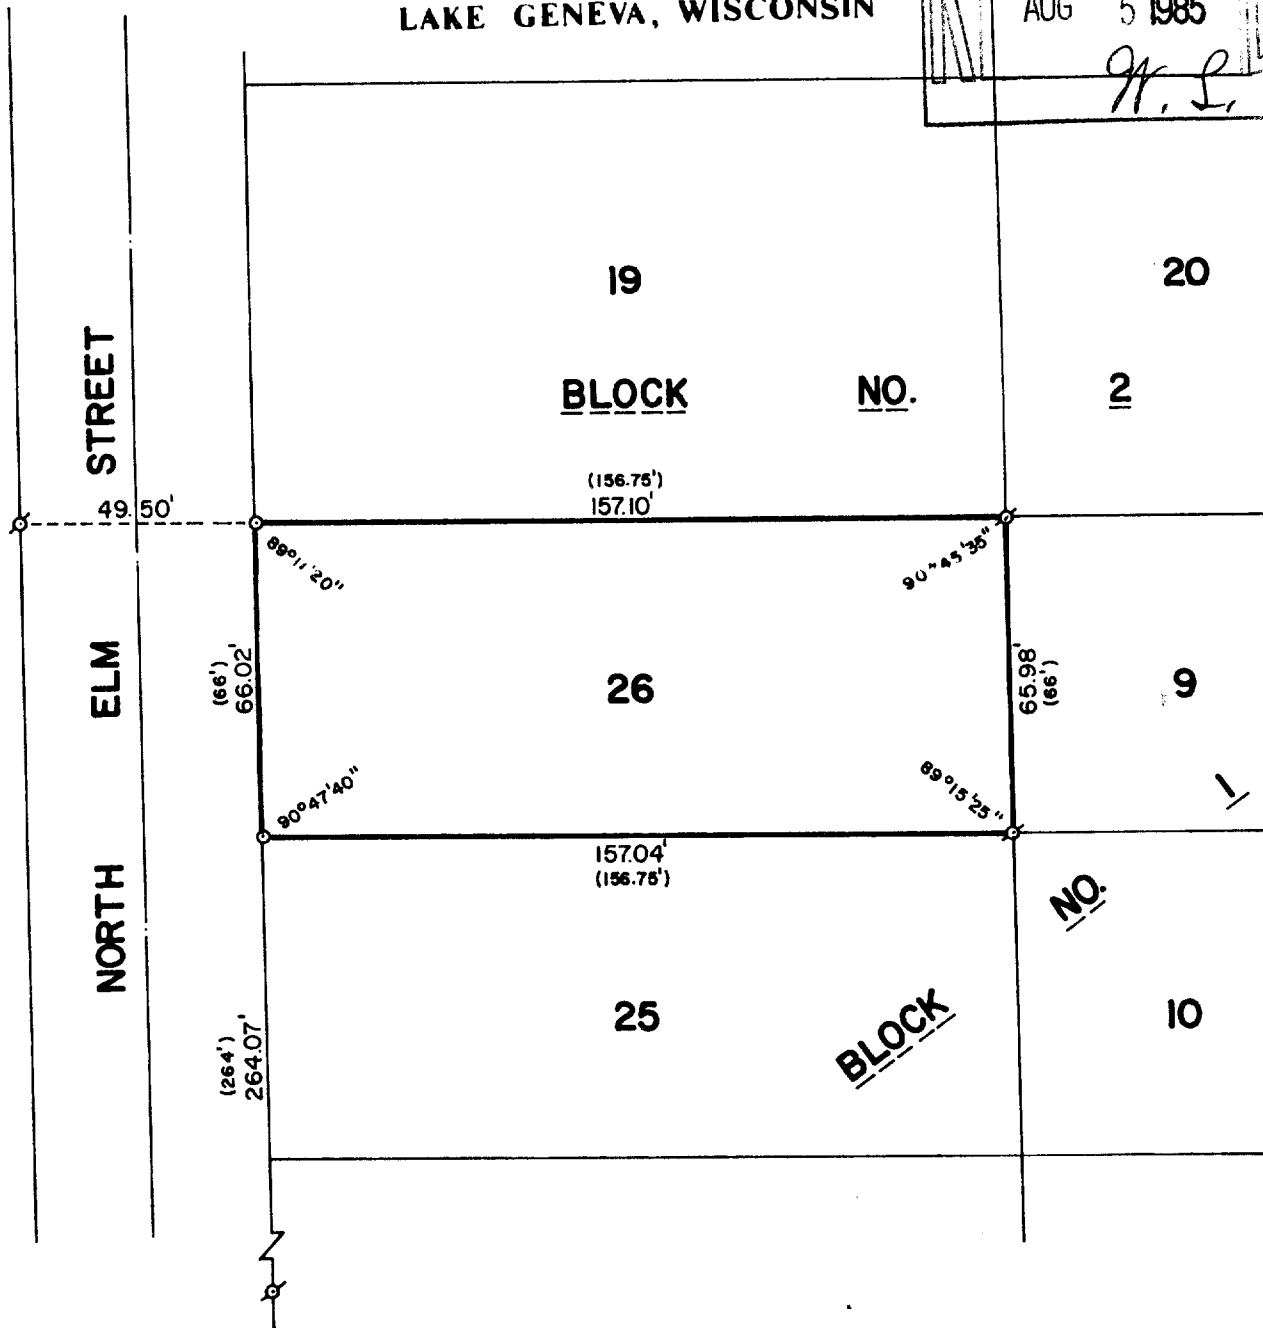


WALWORTH COUNTY
SURVEYING & MAPPING
LAKE GENEVA, WISCONSIN

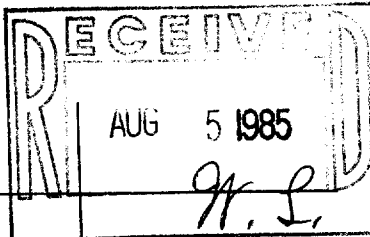

PLAT OF SURVEY OF

LOT 26, BLOCK 1 OF CRANDALL AND
SWINNEY'S ADDITION TO THE VILLAGE
OF WALWORTH, WALWORTH COUNTY,
WISCONSIN.

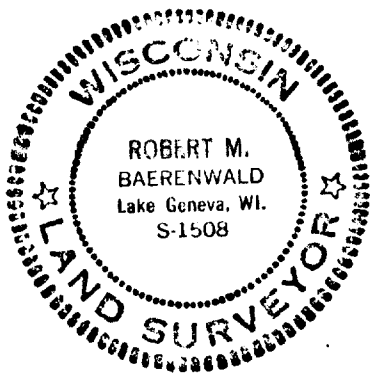

ORDERED BY: PAT BROMELAND
P. O. BOX 293
WALWORTH, WISCONSIN 53184



SCALE: 1"=40'

⊙ - IRON PIPE FOUND
○ - IRON PIPE PLACED
() - RECORDED AS

I, ROBERT M. BAERENWALD, DO HEREBY CERTIFY THAT I
HAVE SURVEYED THE PROPERTY HEREON DESCRIBED ACCORDING
TO THE OFFICIAL RECORDS AND THAT THE PLAT HEREON IS A
CORRECT REPRESENTATION OF THE PROPERTY LINES TO THE
BEST OF MY KNOWLEDGE AND BELIEF.

Robert M. Baerenwald
ROBERT M. BAERENWALD
WISCONSIN REGISTERED LAND SURVEYOR, S-1508

May 8, 1985
DATE JOB NO. 0274