
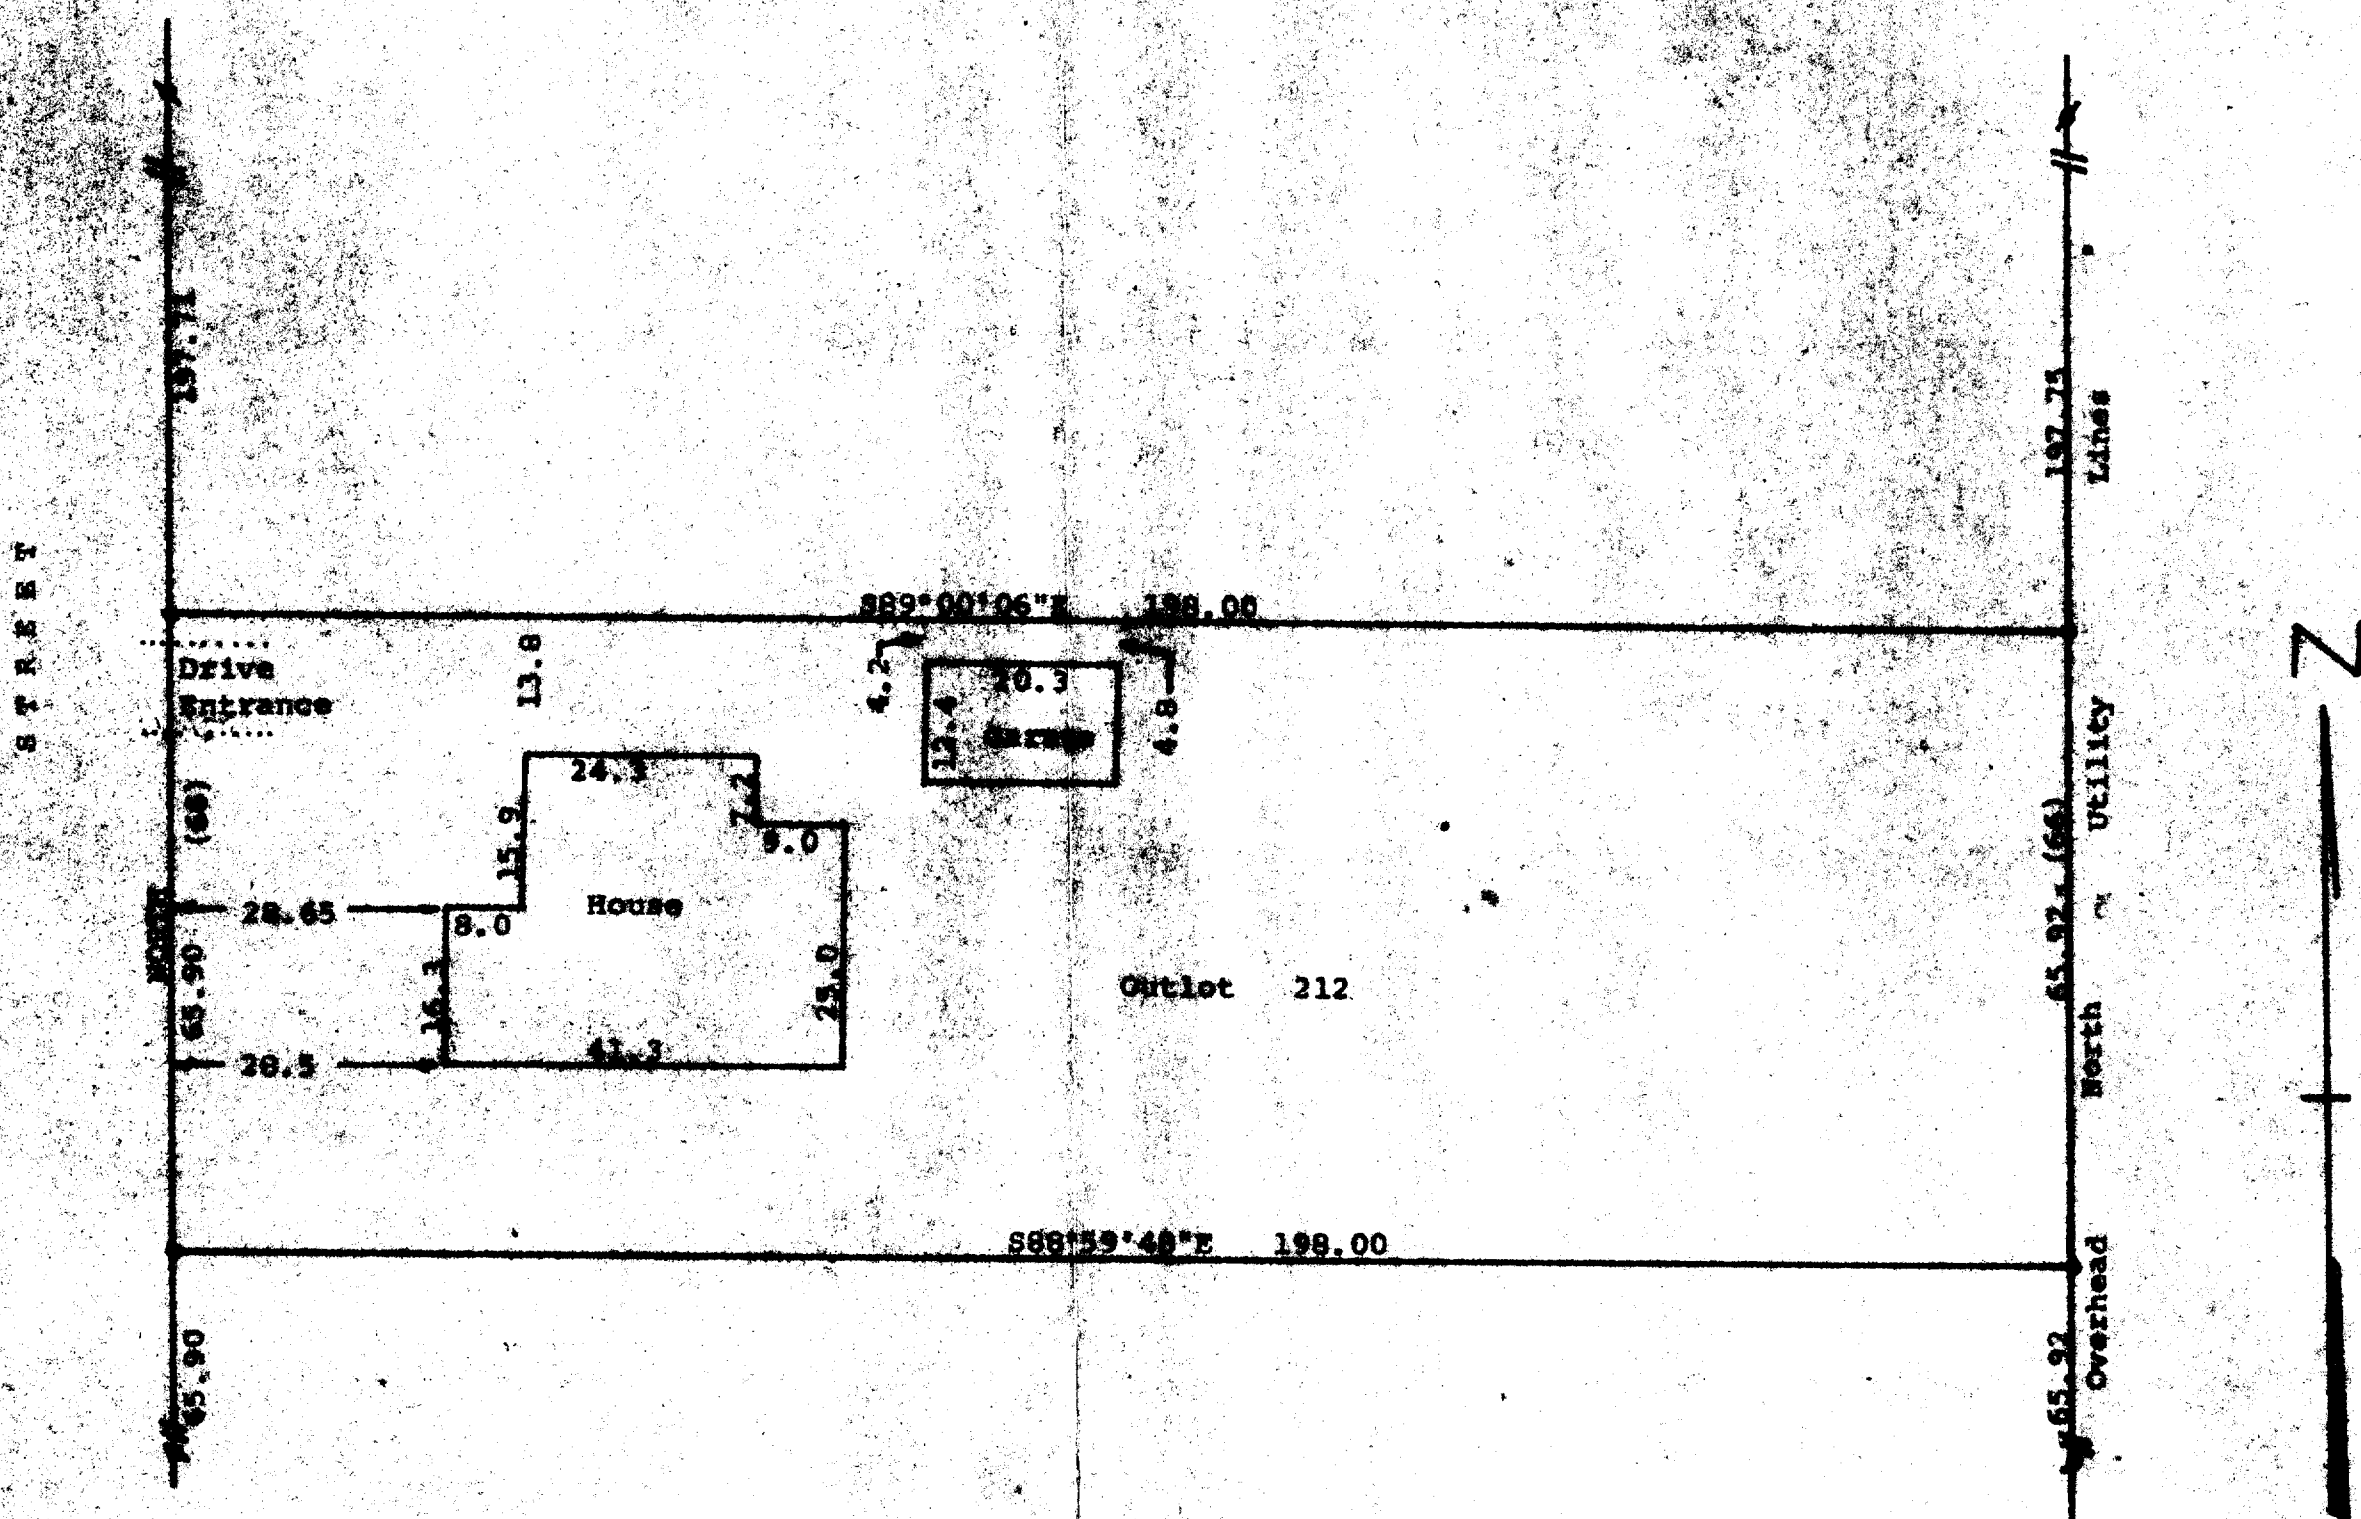


DUNHAM SURVEYING, S.C.
SURVEYING & ENGINEERING
DELAWARE, WISCONSIN 53115

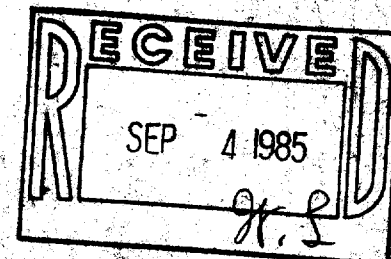

Scale - 1" = 20'
 p = 1/4" Iron Pipe Found
 q = 1" Iron Pipe Found
 o = 3/4" X 24" Iron
 Pipe Set

(0.00) = retruded distance
 Bearings referenced to the east
 line of Wood Street with the assumed
 bearing of North
 Survey ordered by:
 Churchill Real Estate
 327 Park Street
 Walworth, WI 53184

STATE OF WISCONSIN)
 COUNTY OF WALWORTH)

I, George T. Dunham, Surveyor, certify that I have surveyed
 the property described as follows:

Outlot 212 of the Assessor's Plat of the Village of Walworth,
 Walworth County, Wisconsin,

and that the map shown above is a true representation thereof and shows
 the size and location of the property, its exterior boundaries, the
 location of all visible structures and dimensions of all principal
 buildings thereon, boundary fences, easements, roadways and
 visible encroachments, if any, and that I have surveyed the property
 hereon described according to the official records, to the best of my
 knowledge and belief.

June 10, 1985

George T. Dunham
 George T. Dunham, Surveyor

