


N



SCALE 1"=20'
O=IRON PIPE

FIFTH

AVENUE

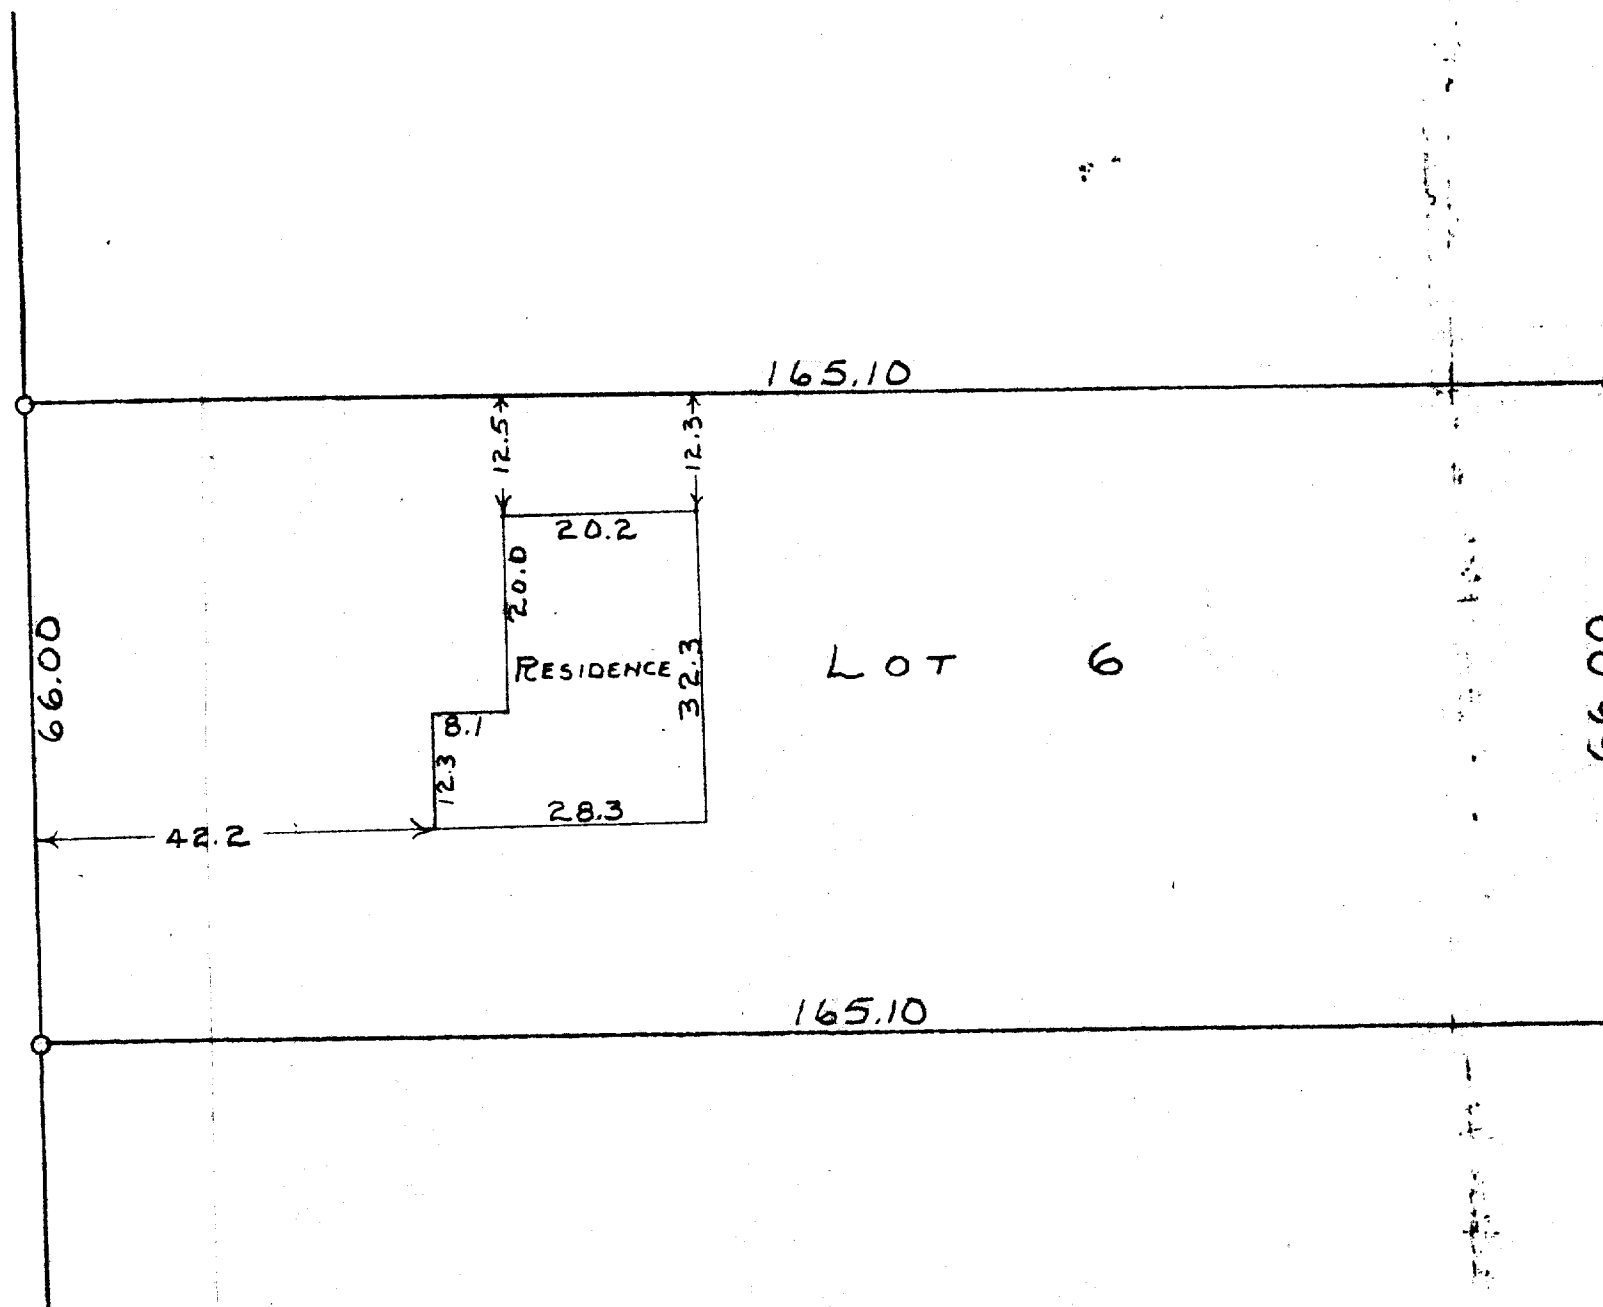

STATE OF WISCONSIN)
WALWORTH COUNTY)

I, GEORGE T. DUNHAM, DO HEREBY CERTIFY THAT I HAVE SURVEYED
THE PROPERTY DESCRIBED AS FOLLOWS:

LOT 6, BLOCK 1 OF E.W. CRUMB'S ADDITION TO THE VILLAGE OF
WALWORTH, WALWORTH COUNTY, WISCONSIN, EXCEPTING THEREFROM

A STRIP OF LAND 3 INCHES WIDE OFF THE EAST SIDE OF SAID LOT.

AND THAT THE PLAT SHOWN ABOVE IS A CORRECT REPRESENTATION OF THE PROPERTY
LINES AND OF THE IMPROVEMENTS LOCATED THEREON.

DEC. 9, 1959

REVISED FEB. 9, 1960

George T. Dunham
GEORGE T. DUNHAM, SURVEYOR
DELAVER, WISCONSIN

~~9-26~~ 9-26