
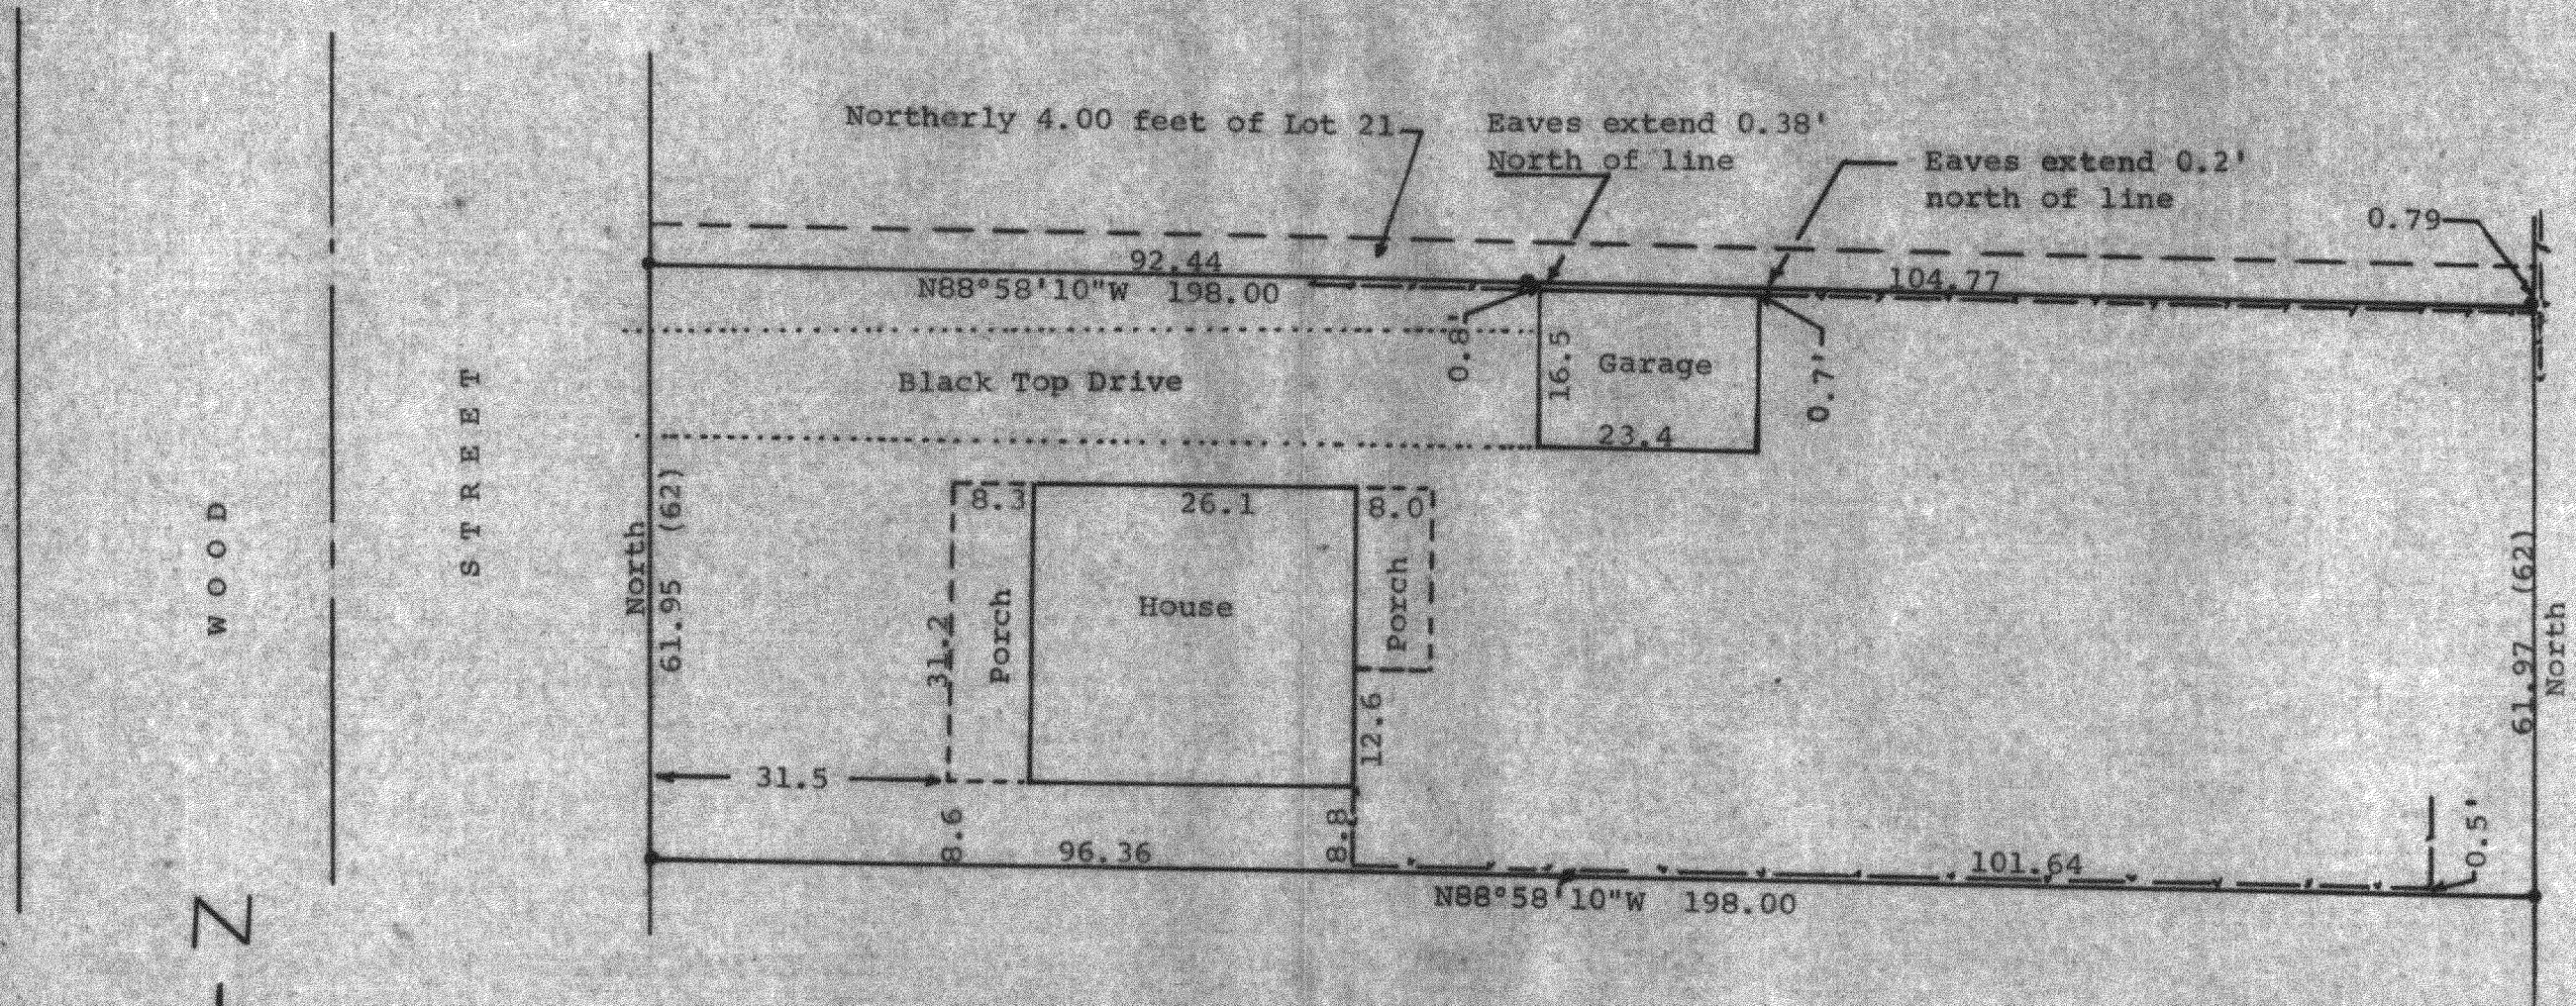


DUNHAM SURVEYING, S.C.
SURVEYING & SUBDIVIDING
DELAVER, WISCONSIN 53115

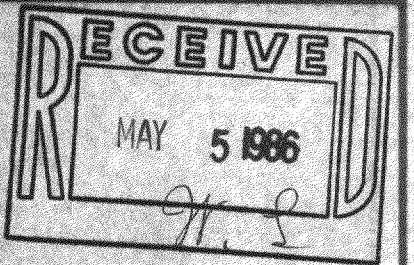

Scale - 1" = 20'

- = 1/2" Iron Pipe Found
- = 3/4" Iron Pipe Found
- = 1" Iron Pipe Found
- - - = Fence Line

Bearings referenced to the east line of Wood Street with the assumed bearing of North

Survey ordered by: The Rauland Agency
Walworth, WI 53184

(0.00) = Recorded distance

STATE OF WISCONSIN)
COUNTY OF WALWORTH) ss


I, George T. Dunham, Surveyor, certify that I have surveyed the property described as follows:

Beginning 4 feet south of the northwest corner of Lot 21 in Clarks Addition to the Village of Walworth, Walworth County, Wisconsin, thence South 62 feet; thence East 198 feet; thence North 62 feet; thence West 198 feet to the place of beginning, all being in T 1 N, R 16 E, Village of Walworth, Walworth County, Wisconsin,

and that the map shown above is a true representation thereof and shows the size and location of the property, its exterior boundaries, the location of all visible structures and dimensions of all principal buildings thereon, boundary fences, apparent easements, roadways and visible encroachments, if any, and that I have surveyed the property hereon described according to the official records to the best of my knowledge and belief.

December 3, 1985

George T. Dunham
George T. Dunham, Surveyor

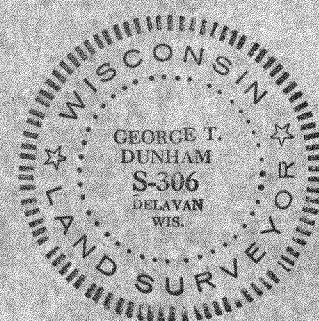

VCA-00027

9-264