
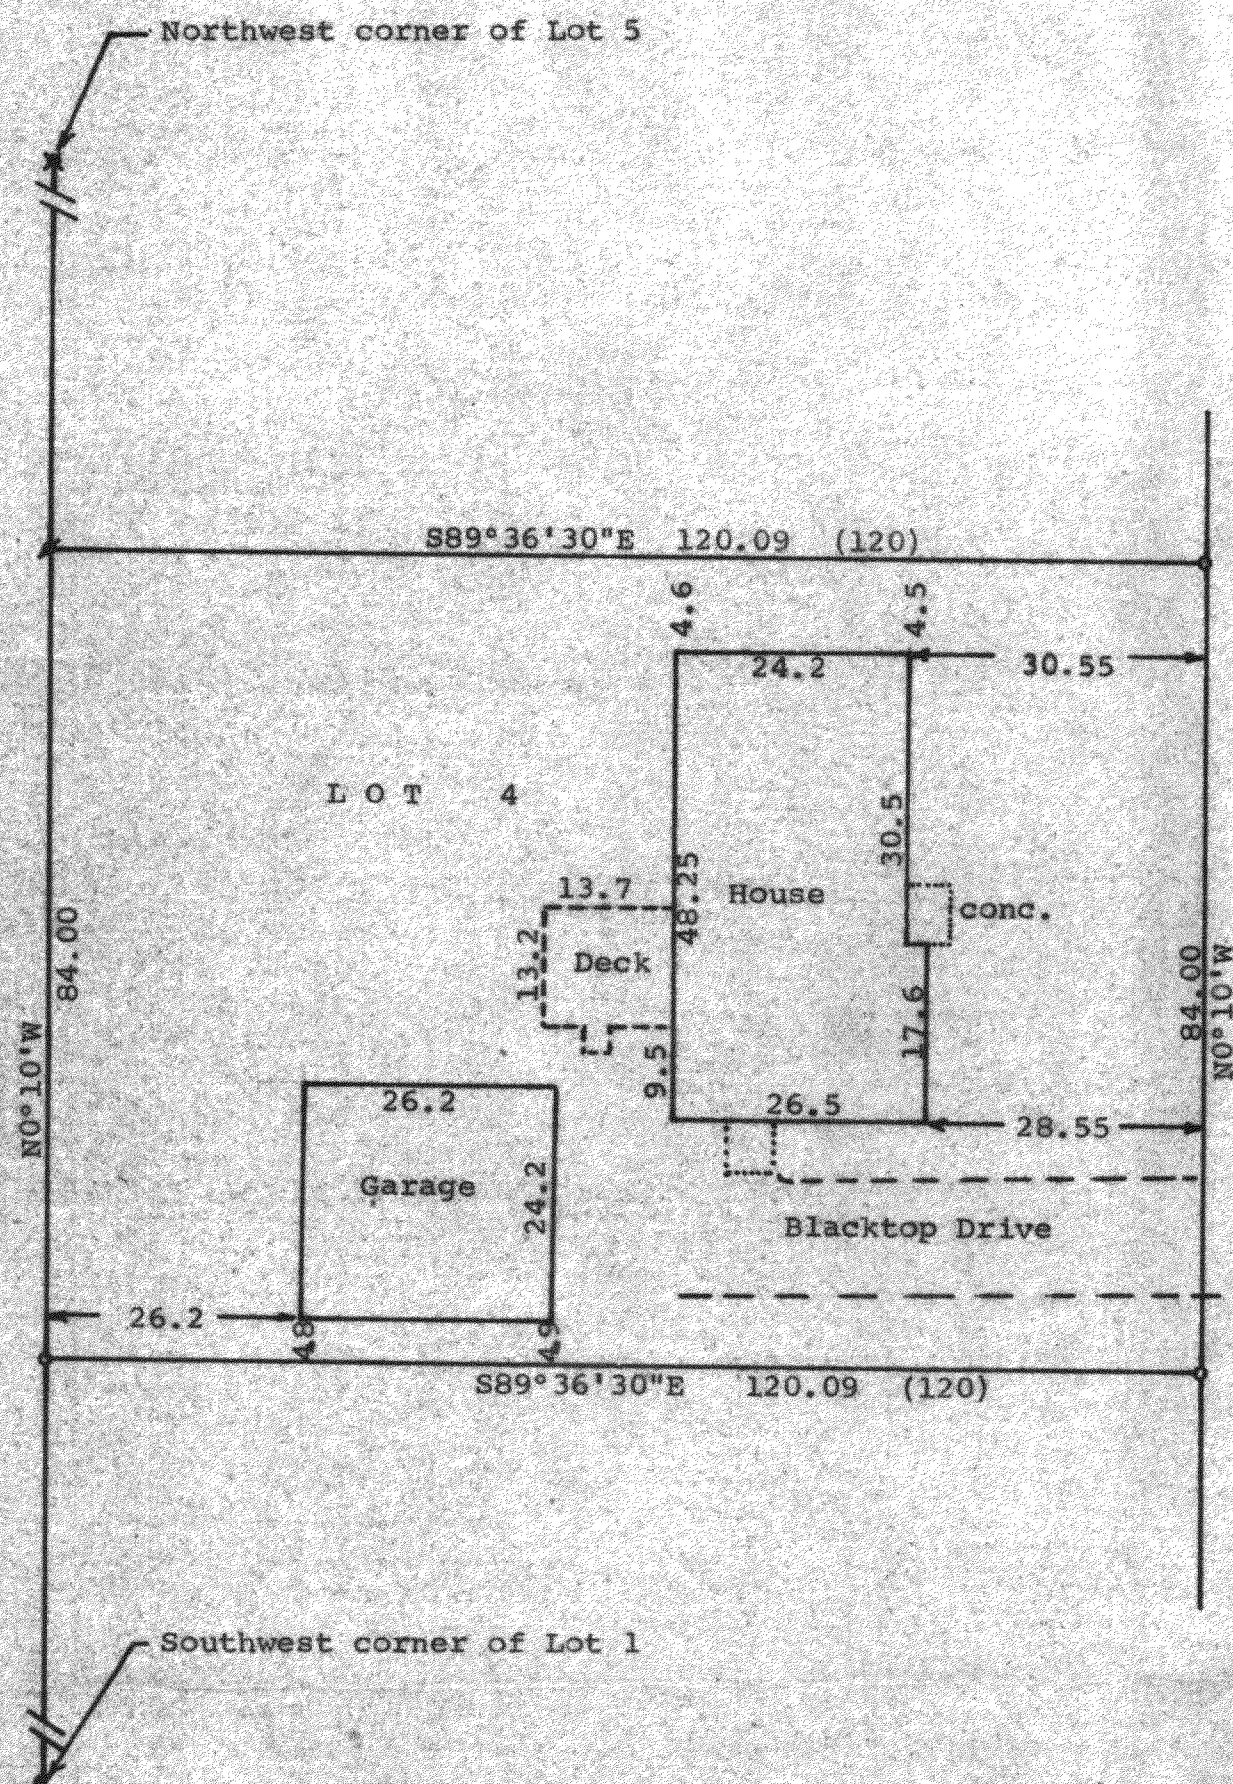


DUNHAM SURVEYING, S.C.
SURVEYING & SUBDIVIDING
DELAVAN, WISCONSIN 53115

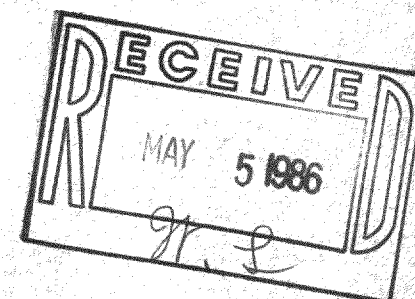

Scale - 1" = 20'

- = Concrete Monument Found
- = 1 1/4" Iron Pipe Found
- = 1 1/4" Iron Pipe Found bent and reset
- (0.00) = recorded distance

Bearings used are those as shown on the recorded plat of the subdivision

Survey ordered by: Stephen D. Powell
Box 766
Walworth WI 53184

X = 2" Iron Pipe Found

STATE OF WISCONSIN)
COUNTY OF WALWORTH)

I, George T. Dunham, Surveyor, certify that I have surveyed the property described as follows:

Lot 4 in Glenn T. Johnson Subdivision located in the Village of Walworth, Walworth County, Wisconsin, and that the above map is a true representation thereof and shows the size and location of the property, its exterior boundaries, the location of all visible structures and dimensions of all principal buildings thereon, boundary fences, apparent easements, roadways and visible encroachments, if any, and that I have surveyed the property hereon described according to the official records, to the best of my knowledge and belief.

April 1, 1986

George T. Dunham
George T. Dunham, Surveyor

