
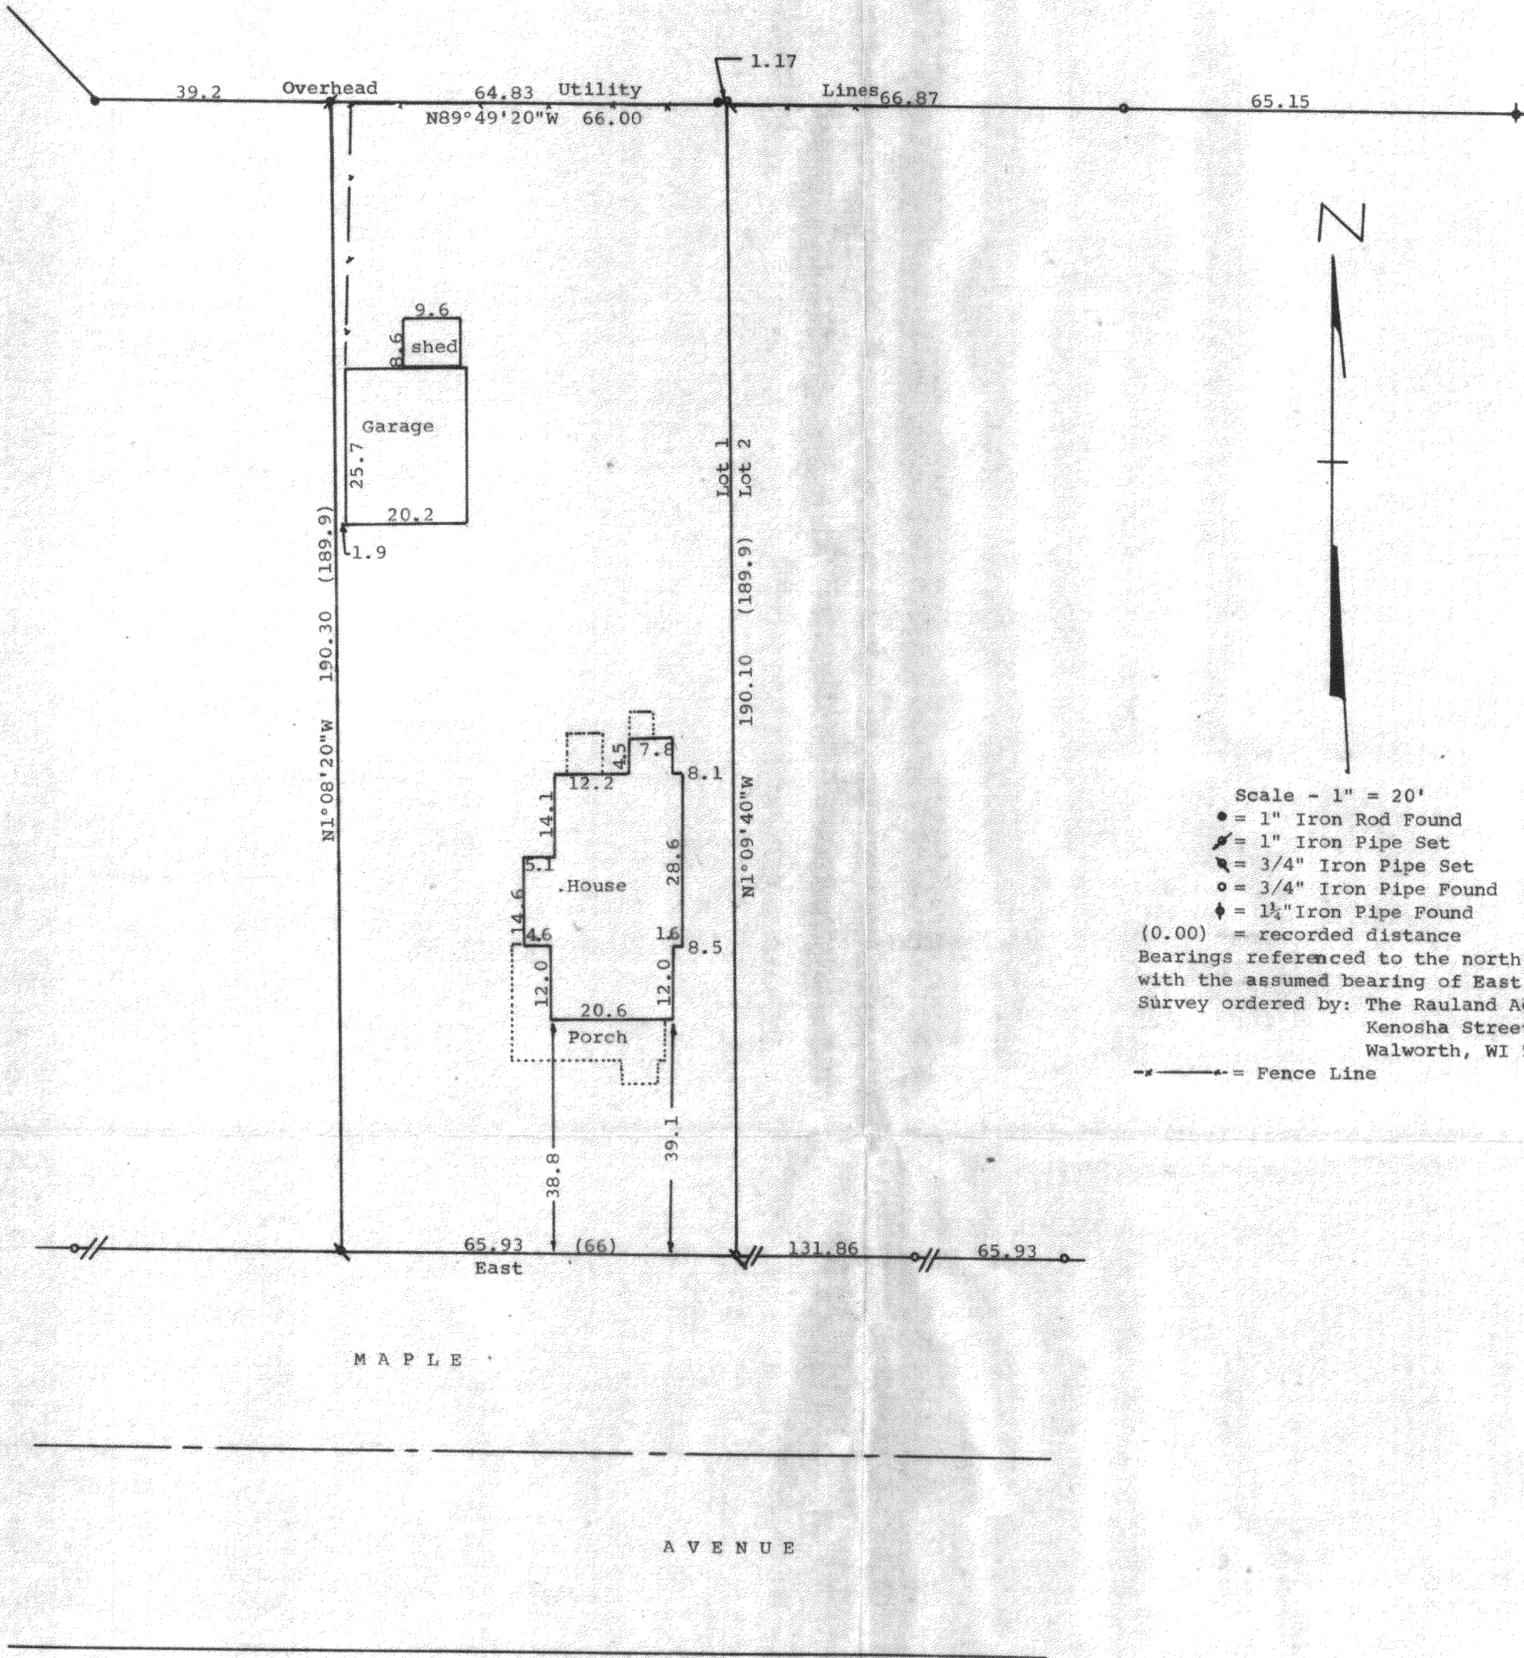


DUNHAM SURVEYING, S.C.
 SURVEYING & SUBDIVIDING
 DELAVAN, WISCONSIN 53115

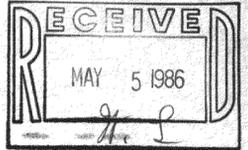

N

Scale - 1" = 20'

- = 1" Iron Rod Found
- = 1" Iron Pipe Set
- = 3/4" Iron Pipe Set
- = 3/4" Iron Pipe Found
- ◆ = 1 1/2" Iron Pipe Found

(0.00) = recorded distance
 Bearings referenced to the north line of Maple Avenue
 with the assumed bearing of East.
 Survey ordered by: The Rauland Agency
 Kenosha Street
 Walworth, WI 53184


--- = Fence Line

STATE OF WISCONSIN)
 COUNTY OF WALWORTH) SS

I, George T. Dunham, Surveyor, certify that I have surveyed the property described as follows:

The East 66 feet of Lot 1 of Clarke's Addition to the Village of Walworth, Walworth County, Wisconsin,
 and that the map shown above is a true representation thereof and shows the size and location of the property, its exterior boundaries, the location of all visible structures and dimensions of all principal buildings thereon, boundary fences, apparent easements, roadways, and visible encroachments, if any and that I have surveyed the property hereon described according to the official records to the best of my knowledge and belief.
 December 27, 1985

George T. Dunham
 George T. Dunham, Surveyor

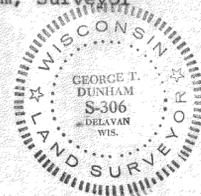

VCA-4

9-267✓