



**ABELL
SURVEYING & MAPPING
DELAVER, WISCONSIN 53115
414-728-6737**

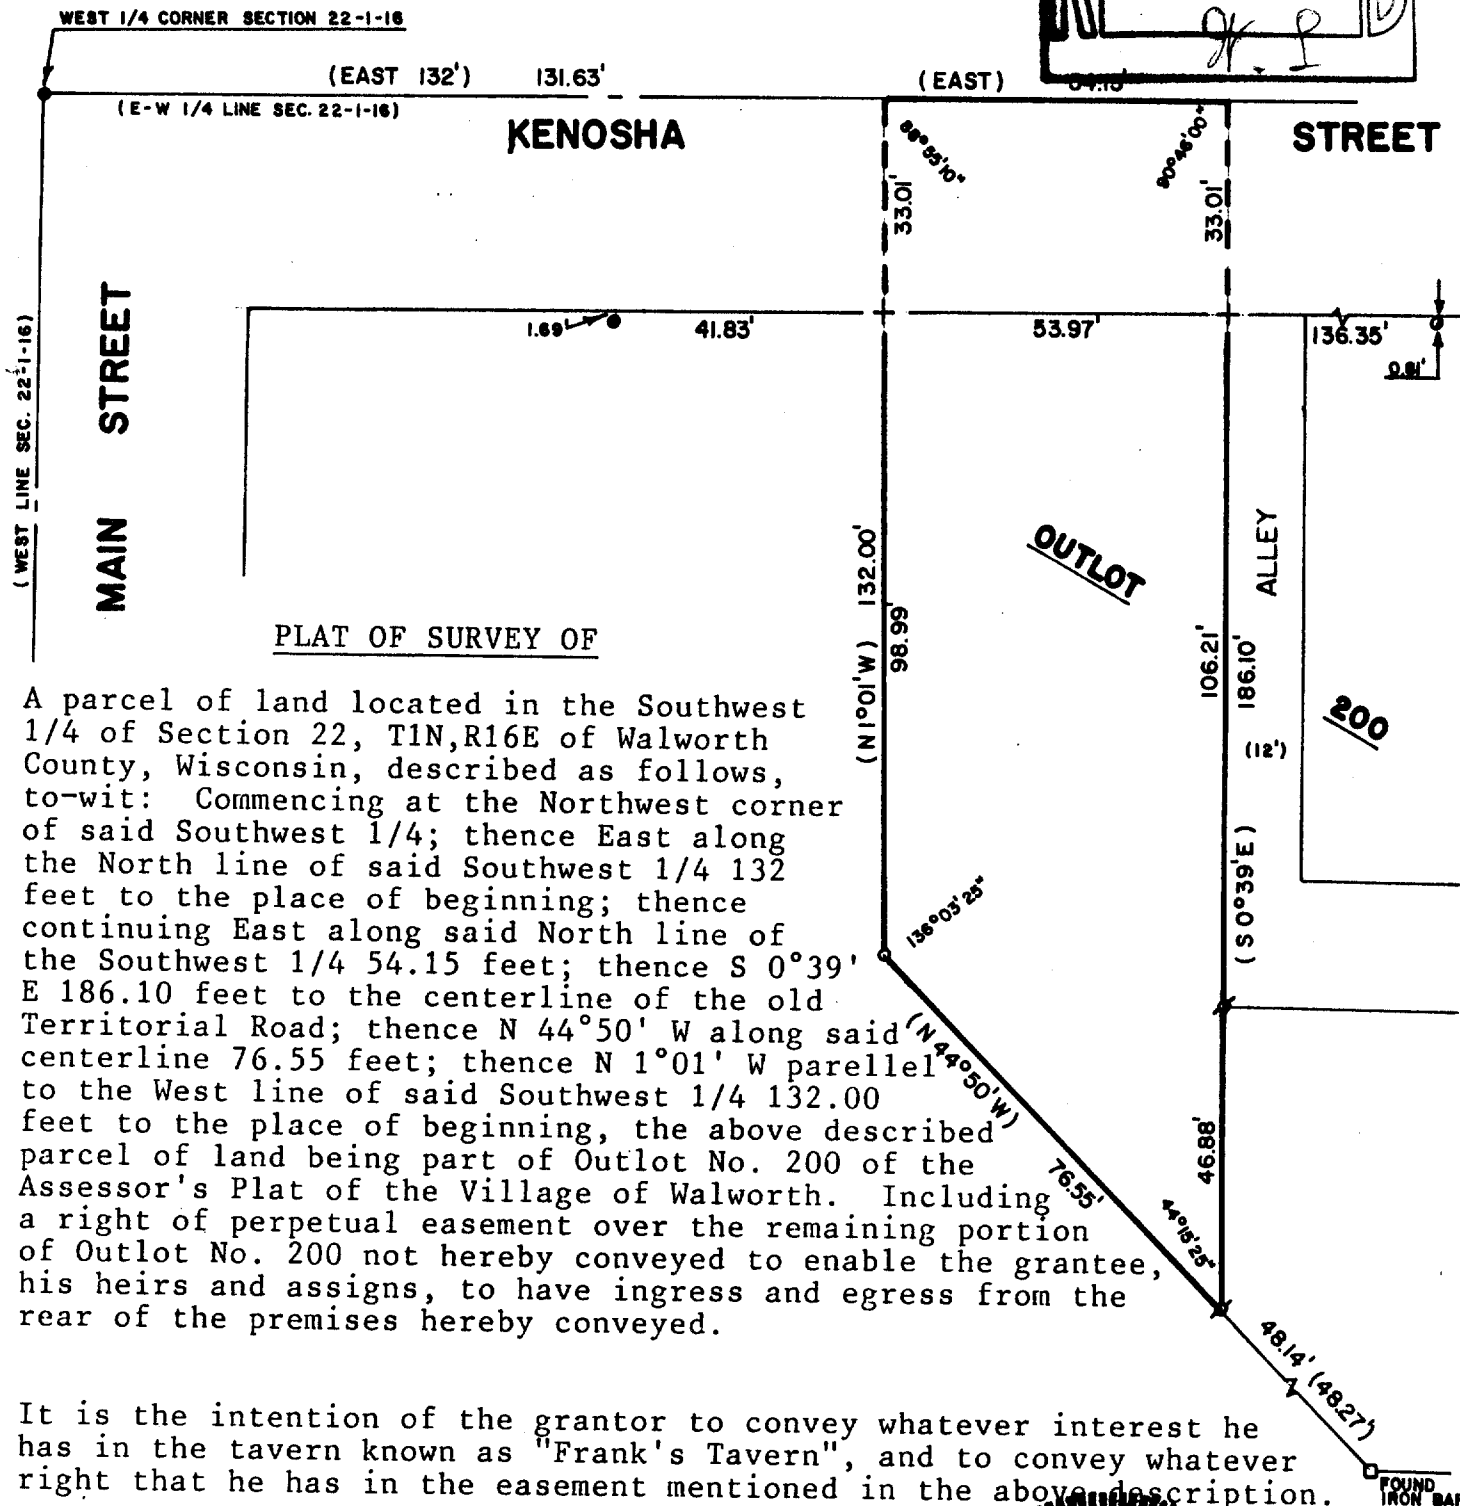

Ordered By: Le Roy Roltsch
114 Read St., Route 1, Box 1E
Walworth, Wisconsin 53184

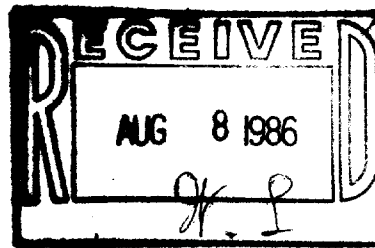

SCALE - 1"=30'

LEGEND

- ∘ - IRON PIPE FOUND
- - 3/4 DIA. IRON ROD SET
- - IRON ROD FOUND
- - CONCRETE MONUMENT FOUND
- () - RECORDED AS
- + - CUT CROSS IN CONCRETE

I, DAVID F. ABELL, DO HEREBY CERTIFY THAT I HAVE SURVEYED THE PROPERTY HEREON DESCRIBED ACCORDING TO THE OFFICIAL RECORDS, AND THAT THE PLAT HEREON IS A CORRECT REPRESENTATION OF THE PROPERTY LINES TO THE BEST OF MY KNOWLEDGE AND BELIEF.

David F. Abell
DAVID F. ABELL
WISCONSIN REGISTERED LAND SURVEYOR, S-1596

DATE *August 1, 1986* JOB NUMBER - 86029

