
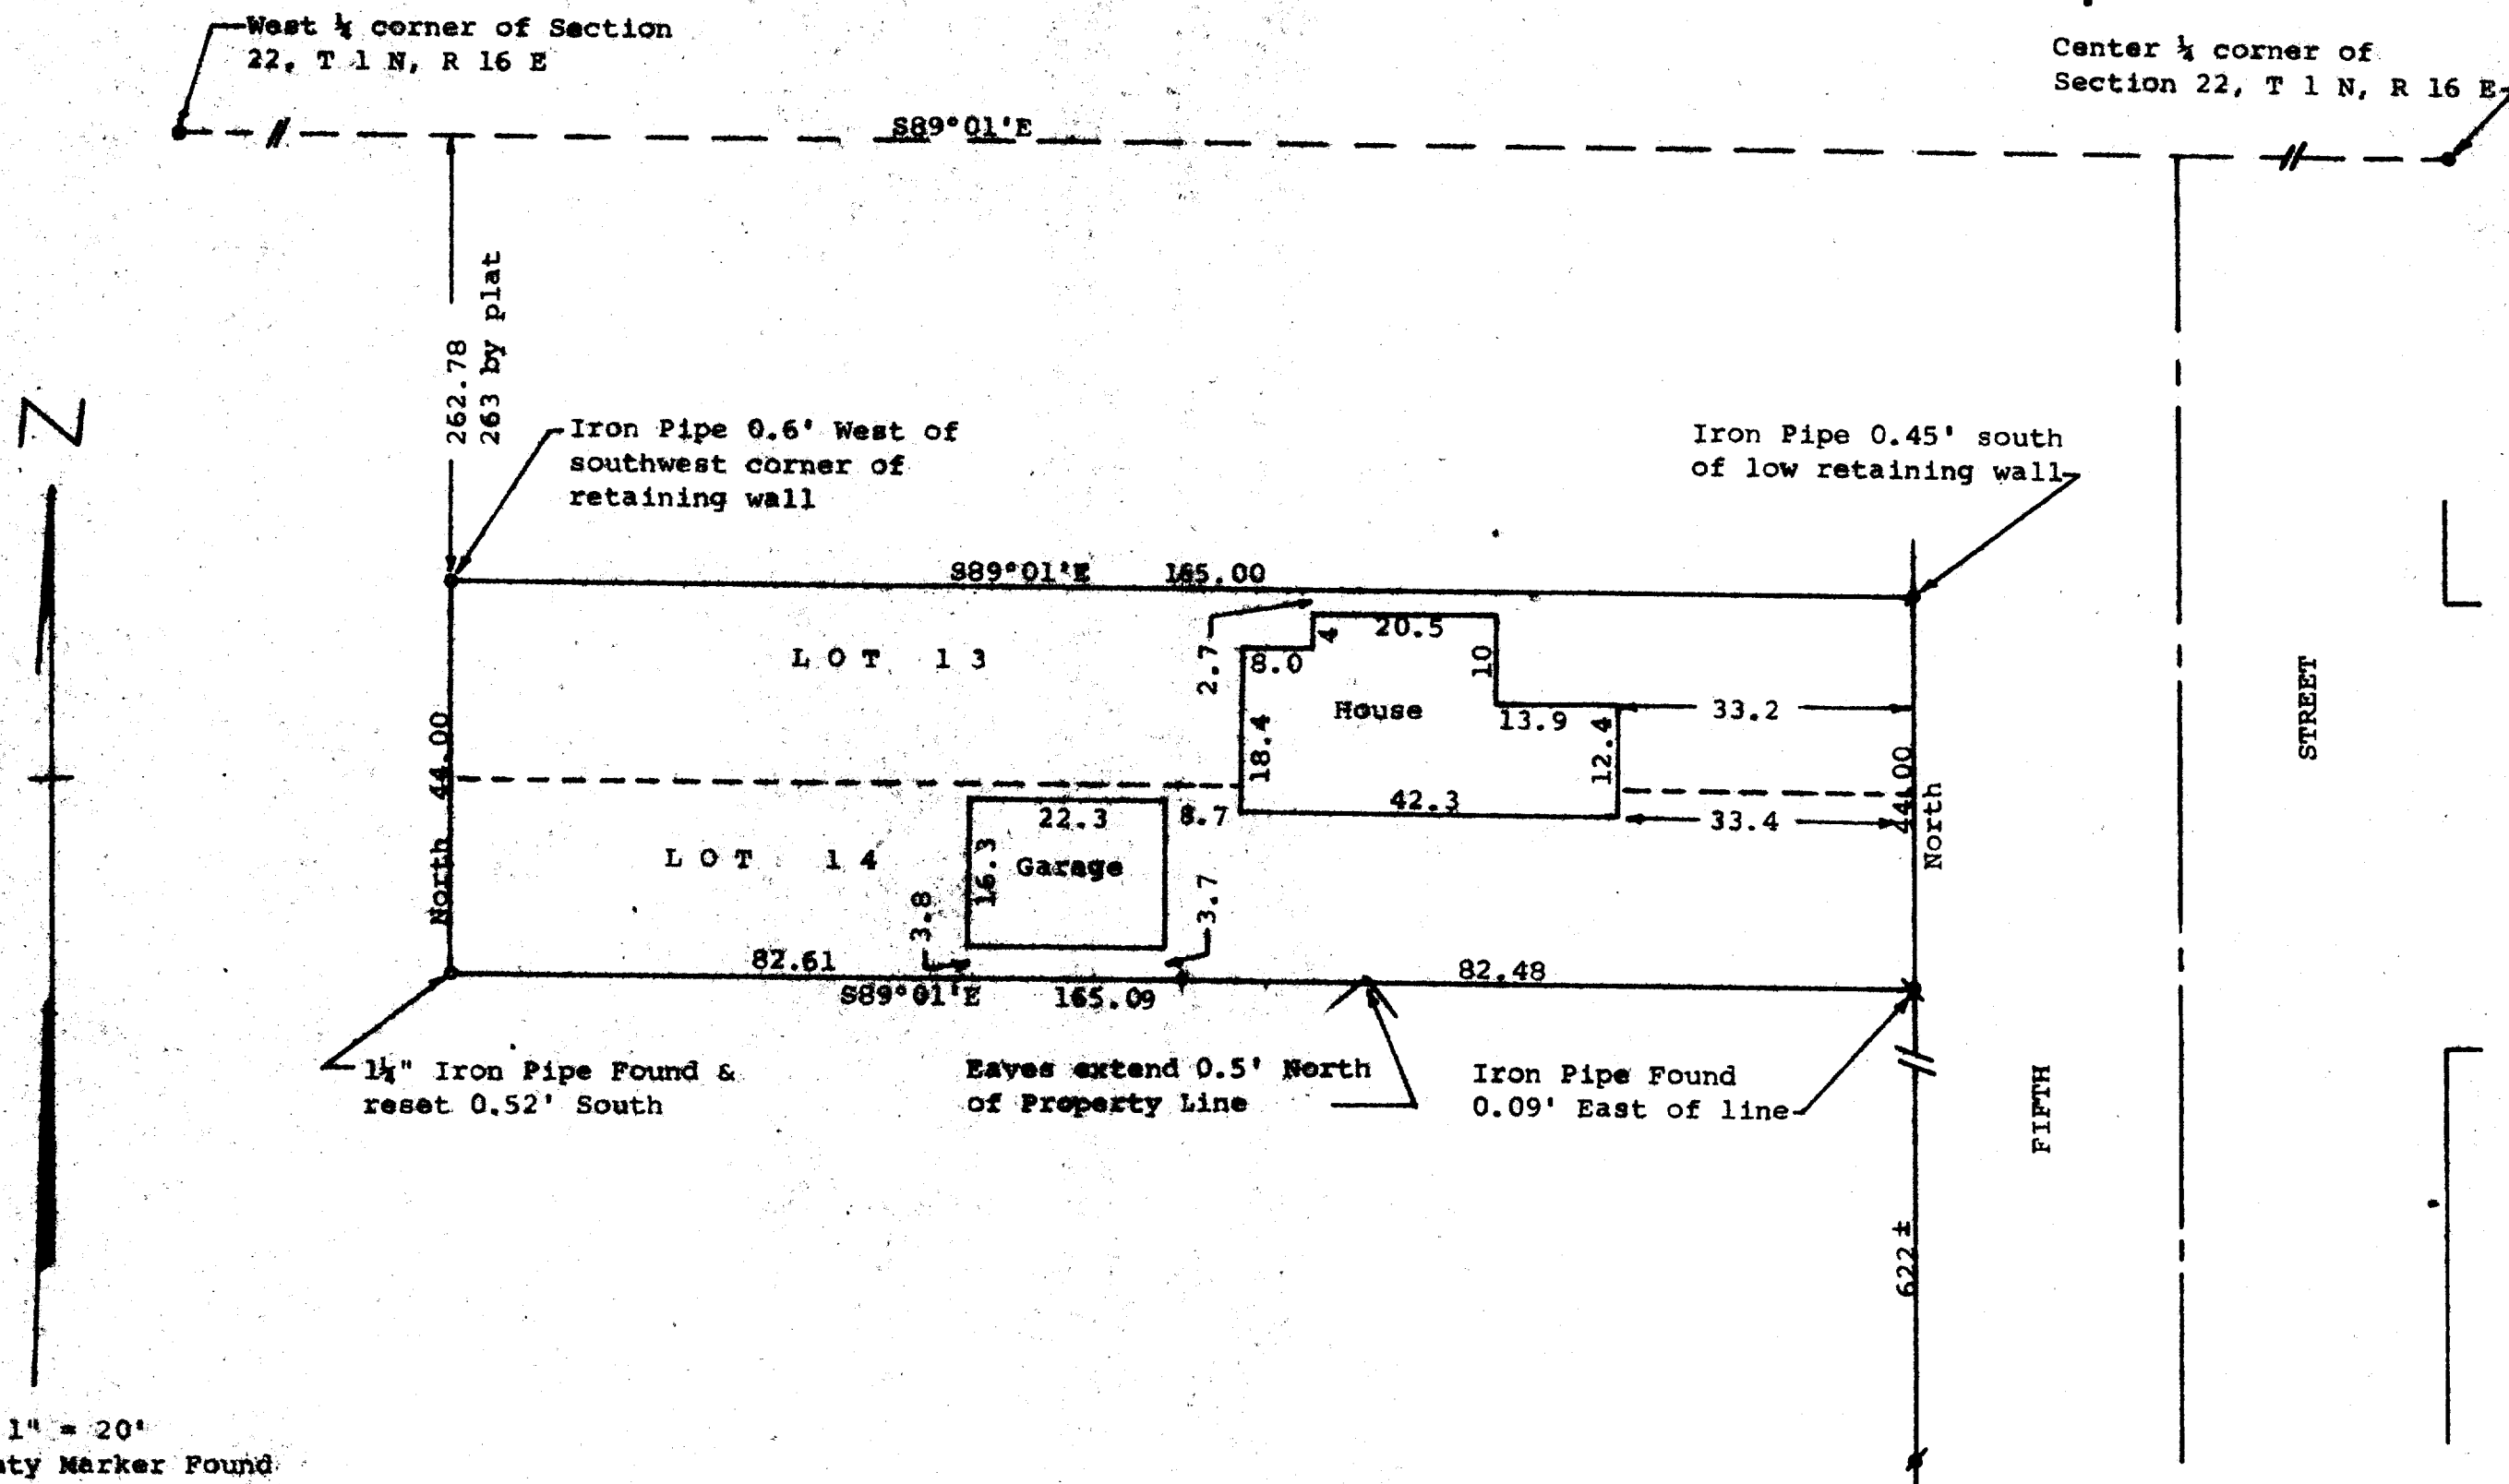


DUNHAM SURVEYING, S.C.
SURVEYING & SUBDIVIDING
DELAVER, WISCONSIN 53115

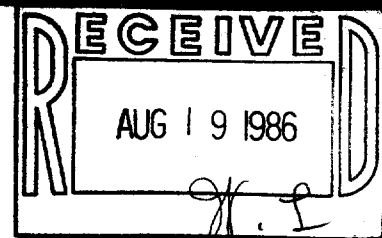

Scale - 1" = 20'

- = County Marker Found
- o = 3/4" Iron Pipe Set
- # = 1" Iron Pipe Found
- u = 1 1/4" Iron Pipe Found 15" below ground with 1/2" Iron Pipe inserted in top

Bearings referenced to the assumed bearing of North along the west line of Fifth Street

Owner: Marie C. Beringer
201 South 5th Street
Walworth, WI 53184

STATE OF WISCONSIN) SS
COUNTY OF WALWORTH)

I, George T. Dunham, Surveyor, certify that I have surveyed the property described as follows:

Lots 13 and 14, Block 1, East Side Addition, located in the Village of Walworth, Walworth County, Wisconsin,

and that the map shown above is a true representation thereof and shows the size and location of the property, its exterior boundaries, the location of all visible structures and dimensions of all principal buildings thereon, boundary fences, apparent easements, roadways and visible encroachments, if any, and that I have surveyed the property hereon described according to the official records, to the best of my knowledge and belief.

October 5, 1984

George T. Dunham
George T. Dunham, Surveyor

