
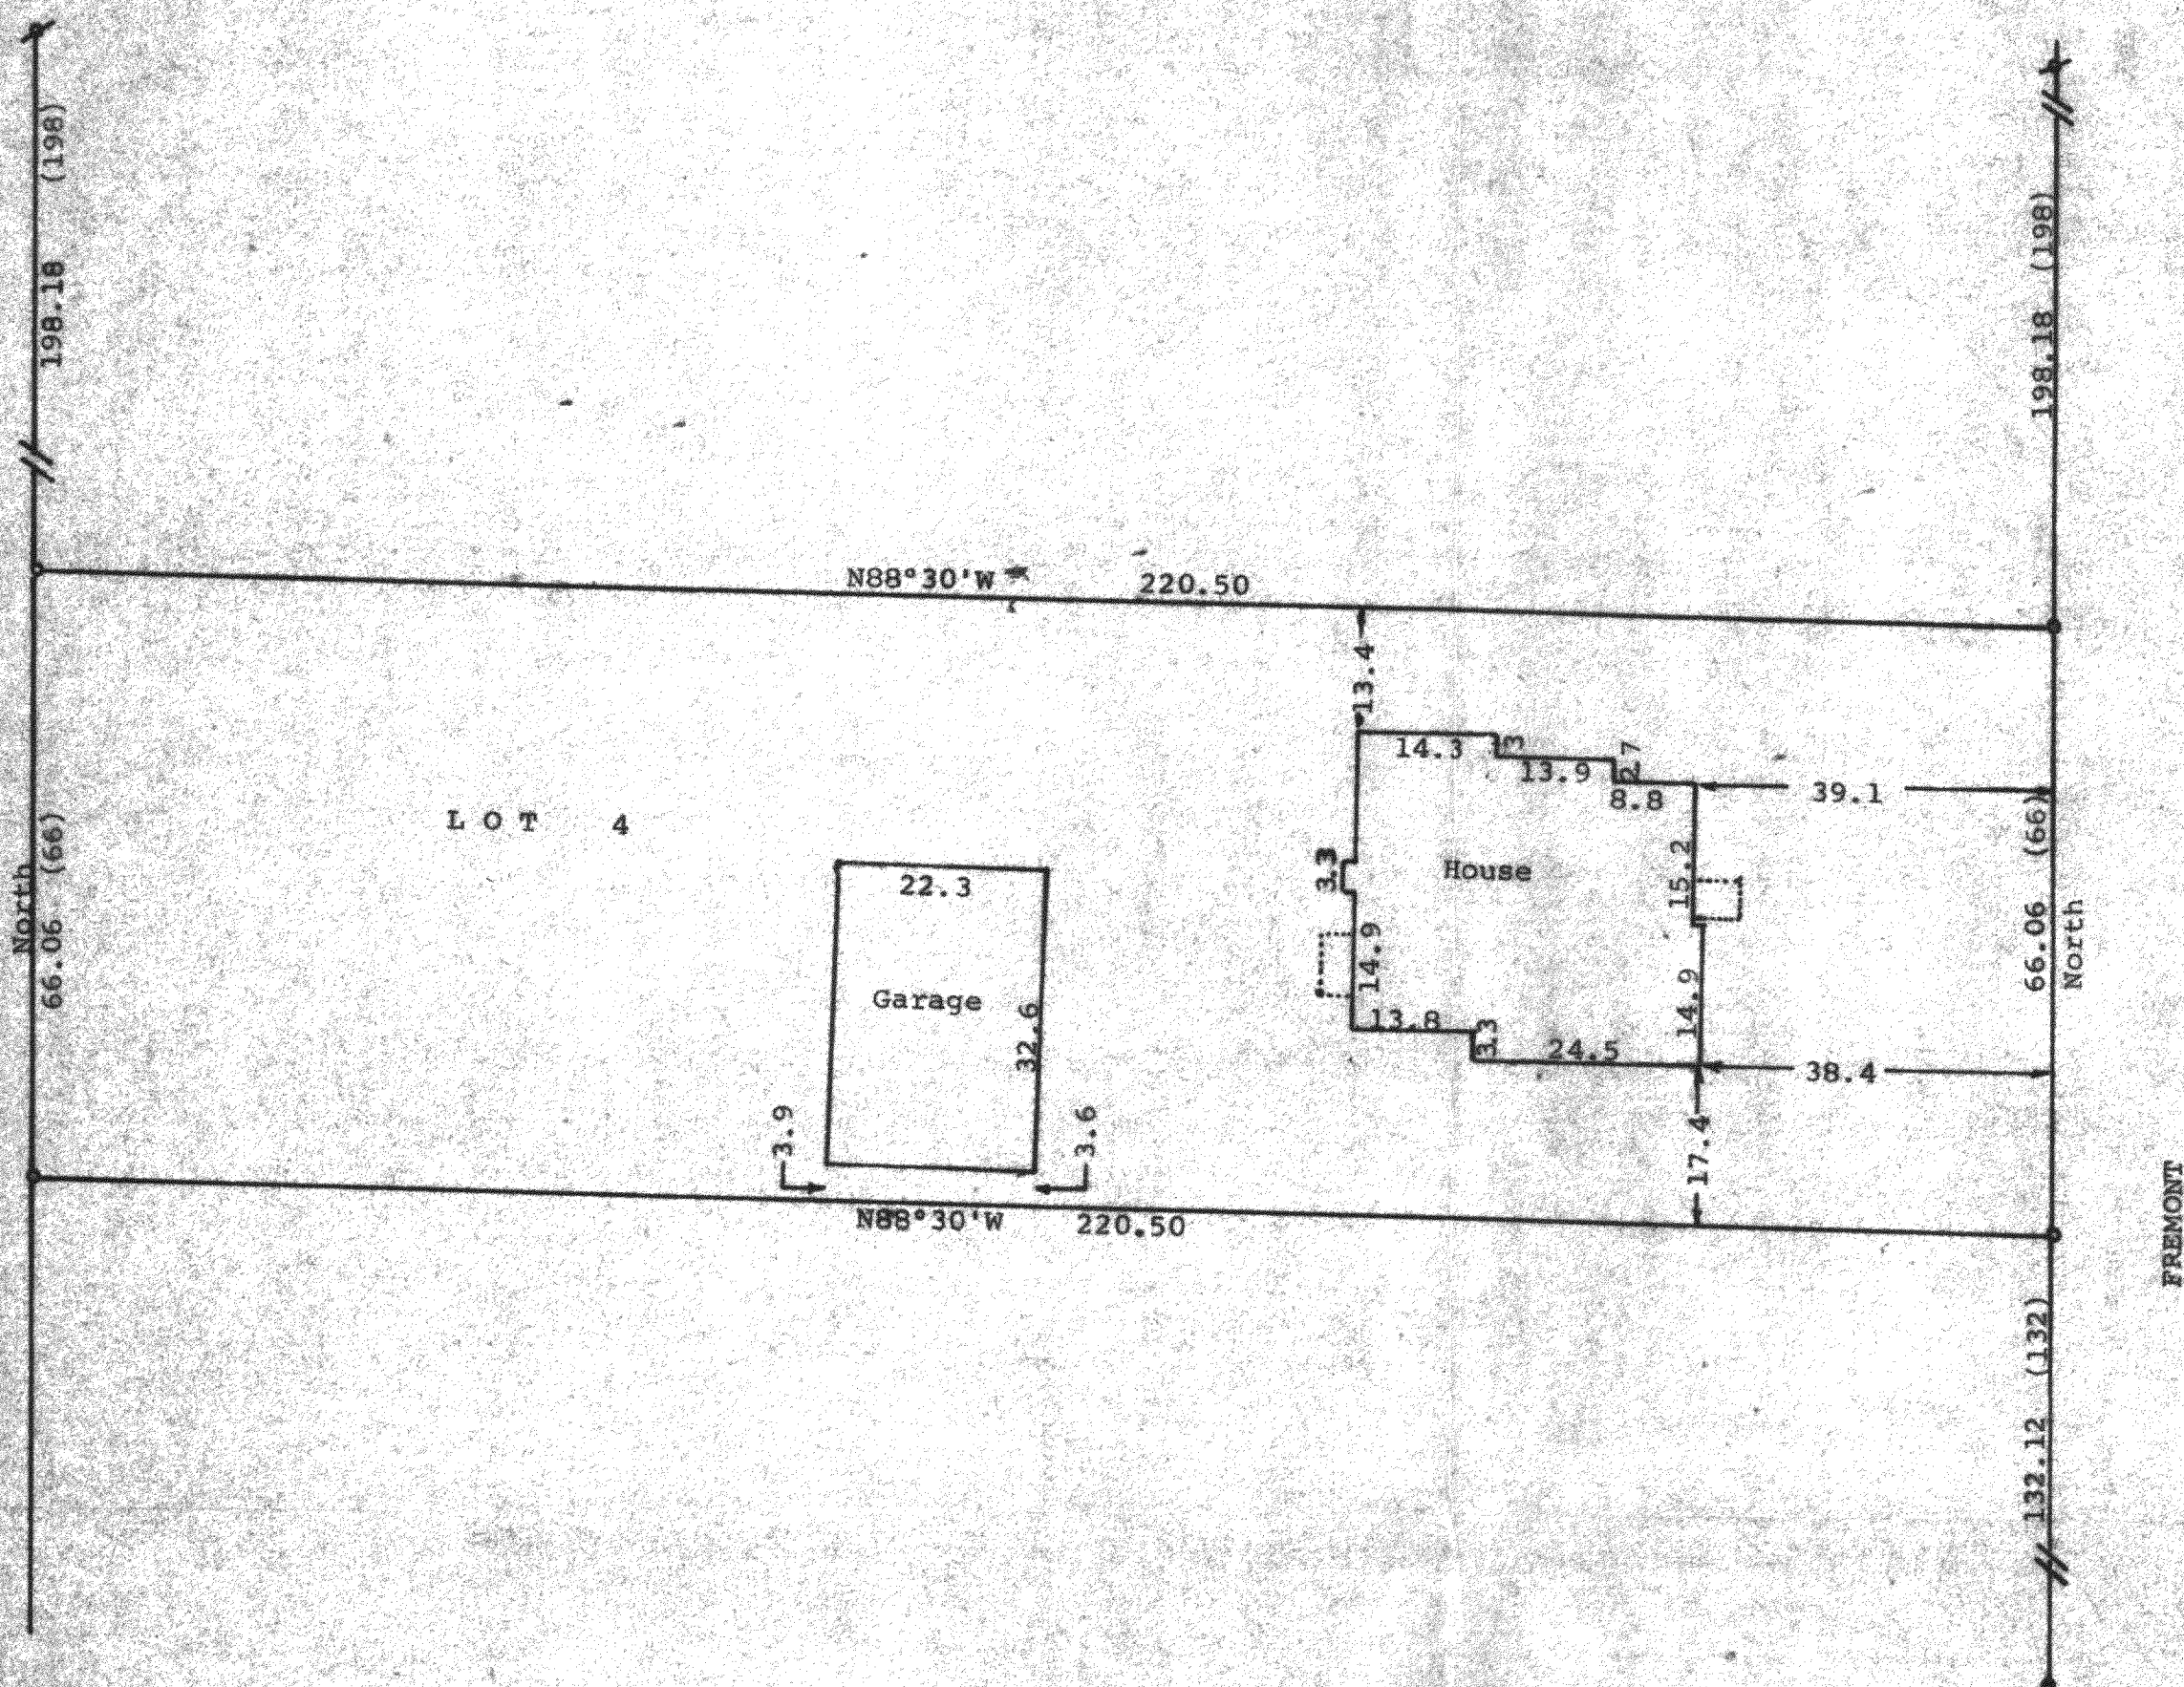


DUNHAM SURVEYING, S.C.  
SURVEYING & SUBDIVIDING  
DELAVER, WISCONSIN 53115

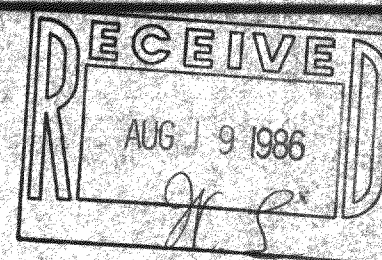

Scale - 1" = 20'

- = 1" Iron Pipe Found
- = 1" X 24" Iron Pipe Set
- = Concrete Monument Found
- (0.00) = recorded distance

Survey ordered by:  
Churchill Real Estate  
322 Park  
Walworth, WI 53184

Bearings are referenced to  
the West line of Fremont  
Street, assumed bearing of  
North.

STATE OF WISCONSIN)  
COUNTY OF WALWORTH) SS

I, George T. Dunham, Surveyor, certify that I have surveyed the  
property described as follows:

Lot 4 in Phillips Addition to the Village of Walworth, Walworth  
County, Wisconsin,

and that the above map is a true representation thereof and shows the size  
and location of the property, its exterior boundaries, the location of all  
visible structures and dimensions of all principal buildings thereon,  
boundary fences, apparent easements, roadways and visible encroachments,  
if any, and that I have surveyed the property hereon described according  
to the official records to the best of my knowledge and belief.

August 5, 1986

*George T. Dunham*  
George T. Dunham, Surveyor

