
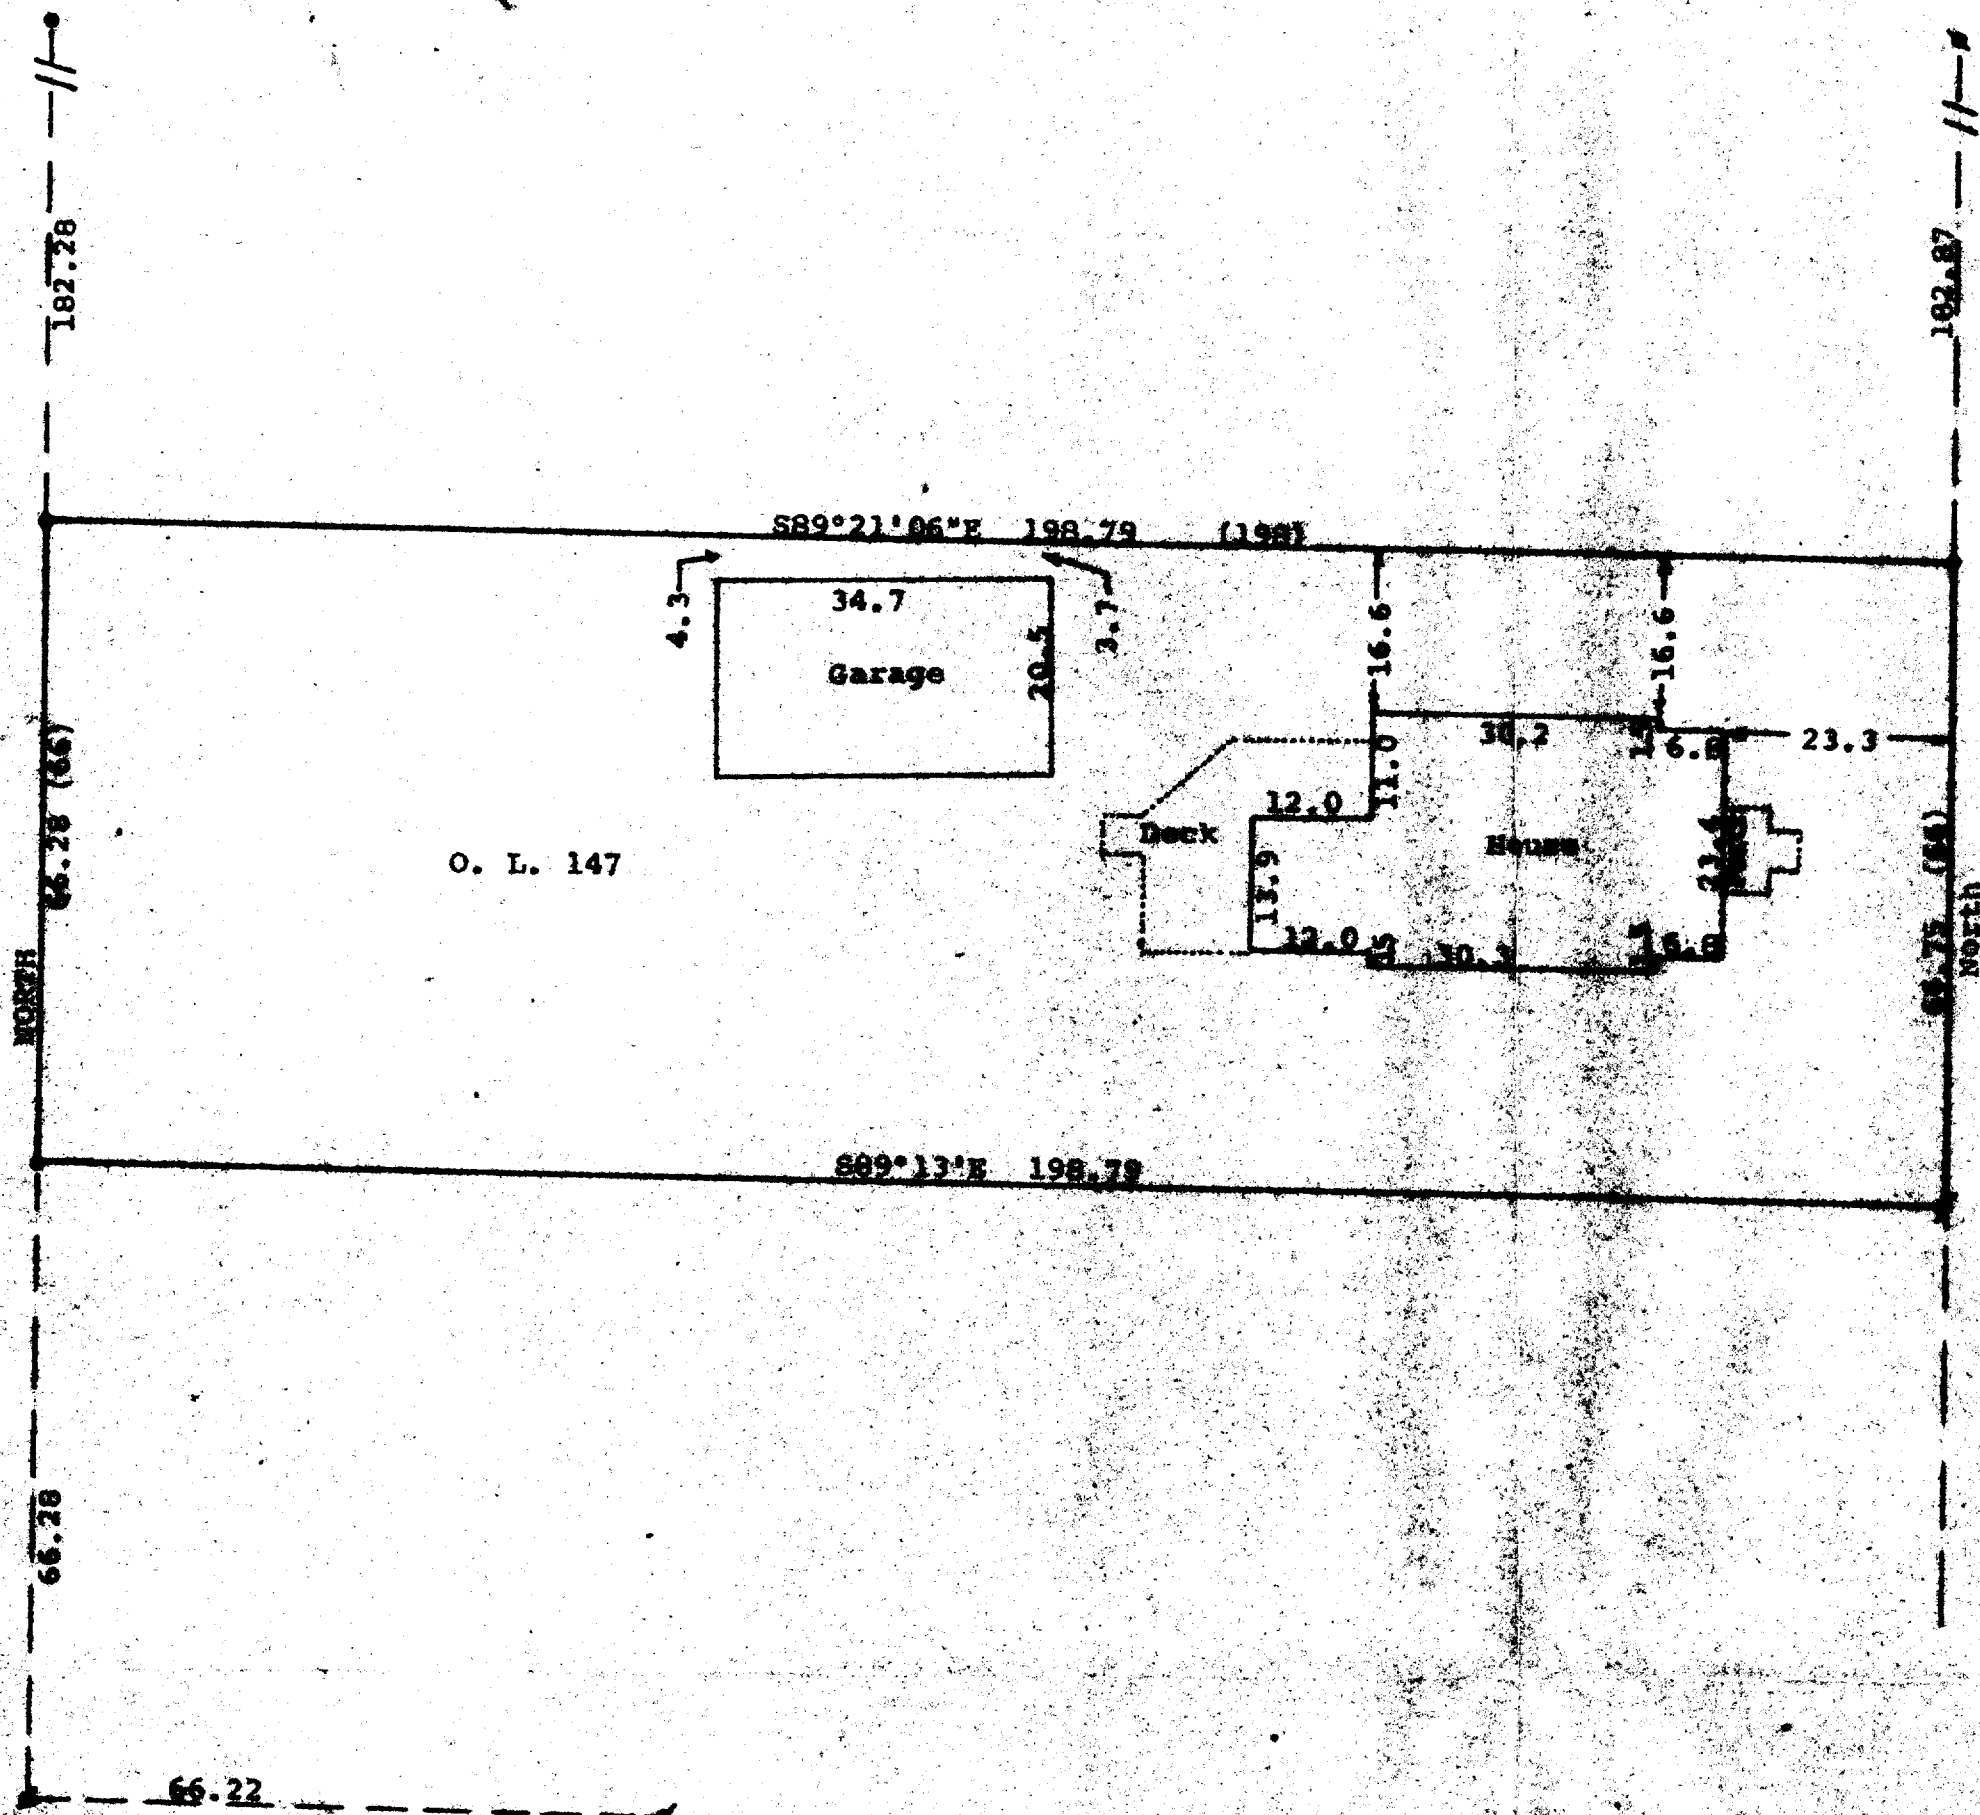


DUNHAM SURVEYING, S.C.
SURVEYING & SUBDIVIDING
DELAVER, WISCONSIN 53115

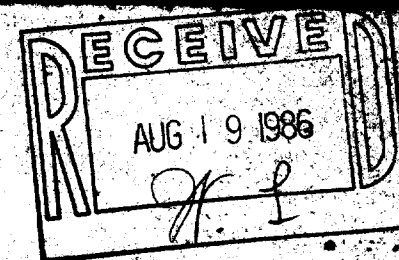

Scale - 1" = 20'
 1" 1/4" Iron Pipe Found
 1" Iron Pipe Found
 1 1/2" Iron Pipe Found
 1 1/2" x 24" Iron Pipe Found
 (D.O.) = recorded distance
 Bearings referenced to the point
 line of Pecks Court Street with the
 bearing of North
 Survey ordered by: The Railroad Agency
 115 Kansas
 Walworth, WI

STATE OF WISCONSIN)
 COUNTY OF WALWORTH)

I, George F. Dunham, Surveyor, certify that I have surveyed
 the property described as follows:
 Outlot 147 of the Applicant's Plat of the Village of Walworth,
 Walworth County, Wisconsin,
 and that the map shown above is a true representation thereof and shows
 the size and location of the property, its exterior boundaries, the location
 of all visible structures and dimensions of all principal buildings thereon,
 boundary fences, apparent easements, easements, and visible encroachments, if
 any, and that I have surveyed the property herein described according to the
 official records to the best of my knowledge and belief.
 June 10, 1986

George F. Dunham
 George F. Dunham, Surveyor

