


RECEIVED
AUG 19 1986
H. S.

K E N O S H A

S T R E E T

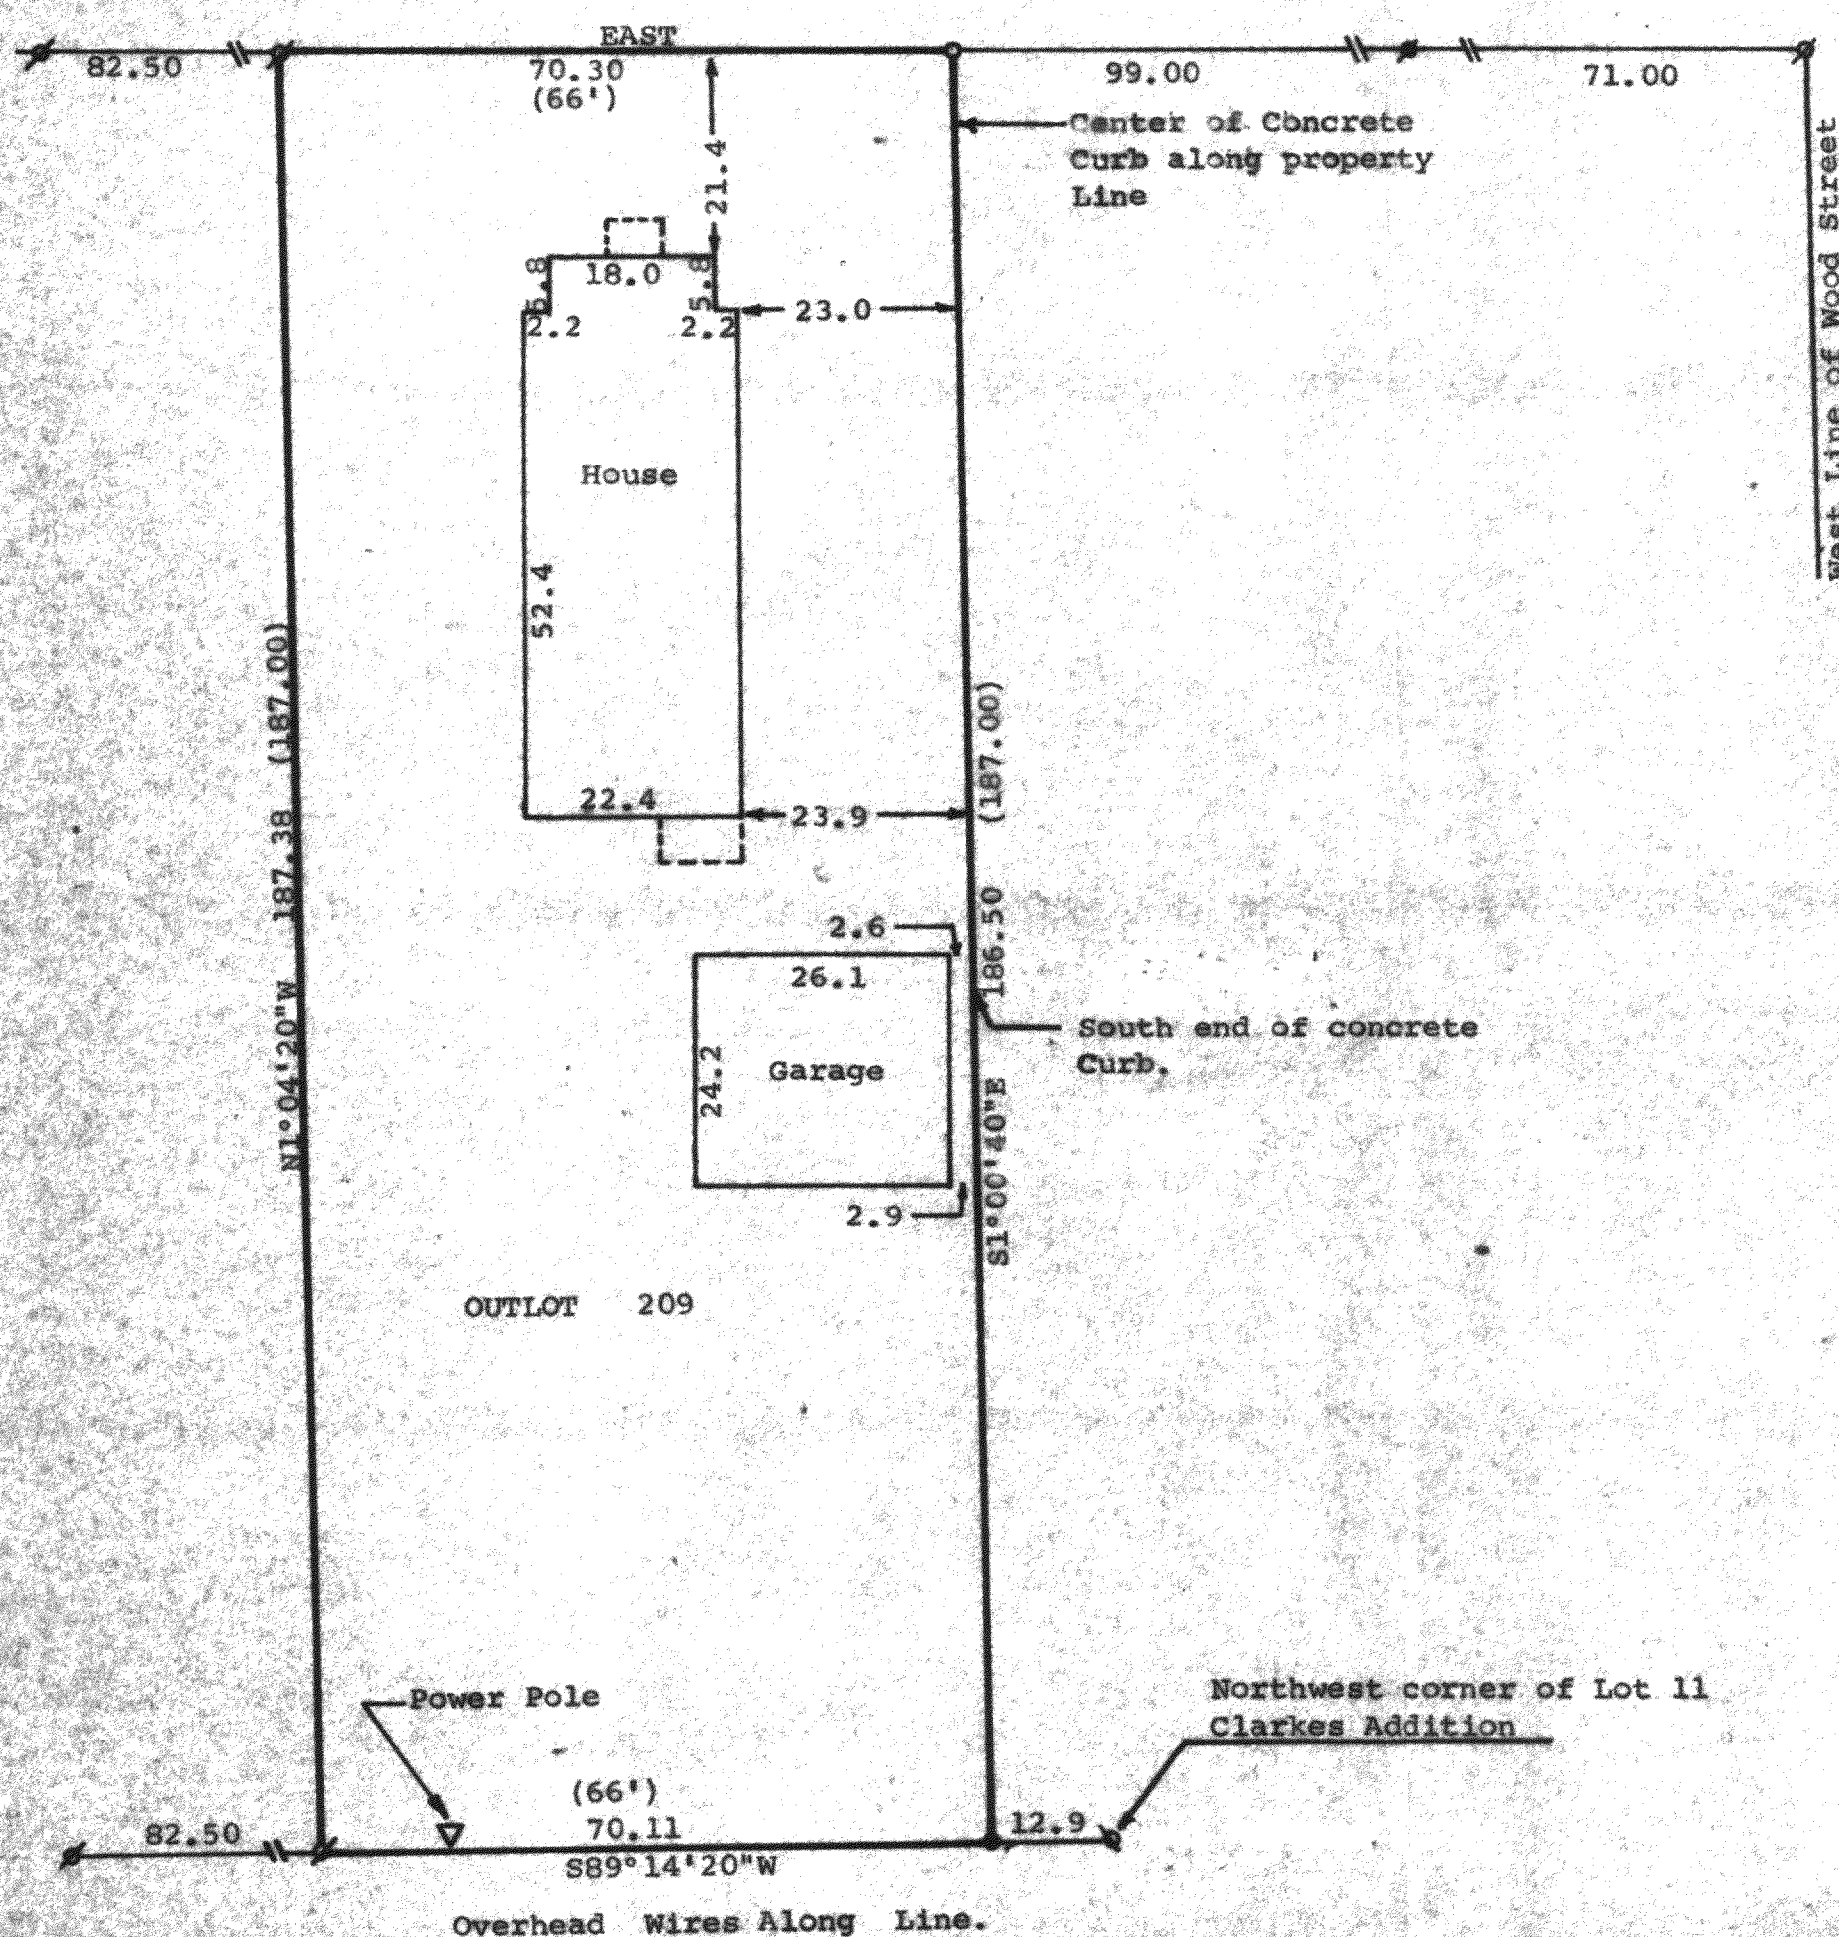

Scale - 1" = 20'

Scale - 1" = 20'

Ø = 3/4" Iron Pipe Found

• = 3/4" Iron Pipe Foun

Q = 1" Iron Pipe Found

● = 1 1/4" Iron Pipe Found

Δ = 3/4" x 24" Iron Pipe Set
= recorded distance

Bearings referenced to the south line of

Kenosha Street with the assumed bearing of East

Survey ordered by: Churchill Real Estate
323 East

322 Park
Walworth, WI 53184

Ø = 1/2" Iron Pipe Found

George F. Dunham
George F. Dunham, Surveyor

