
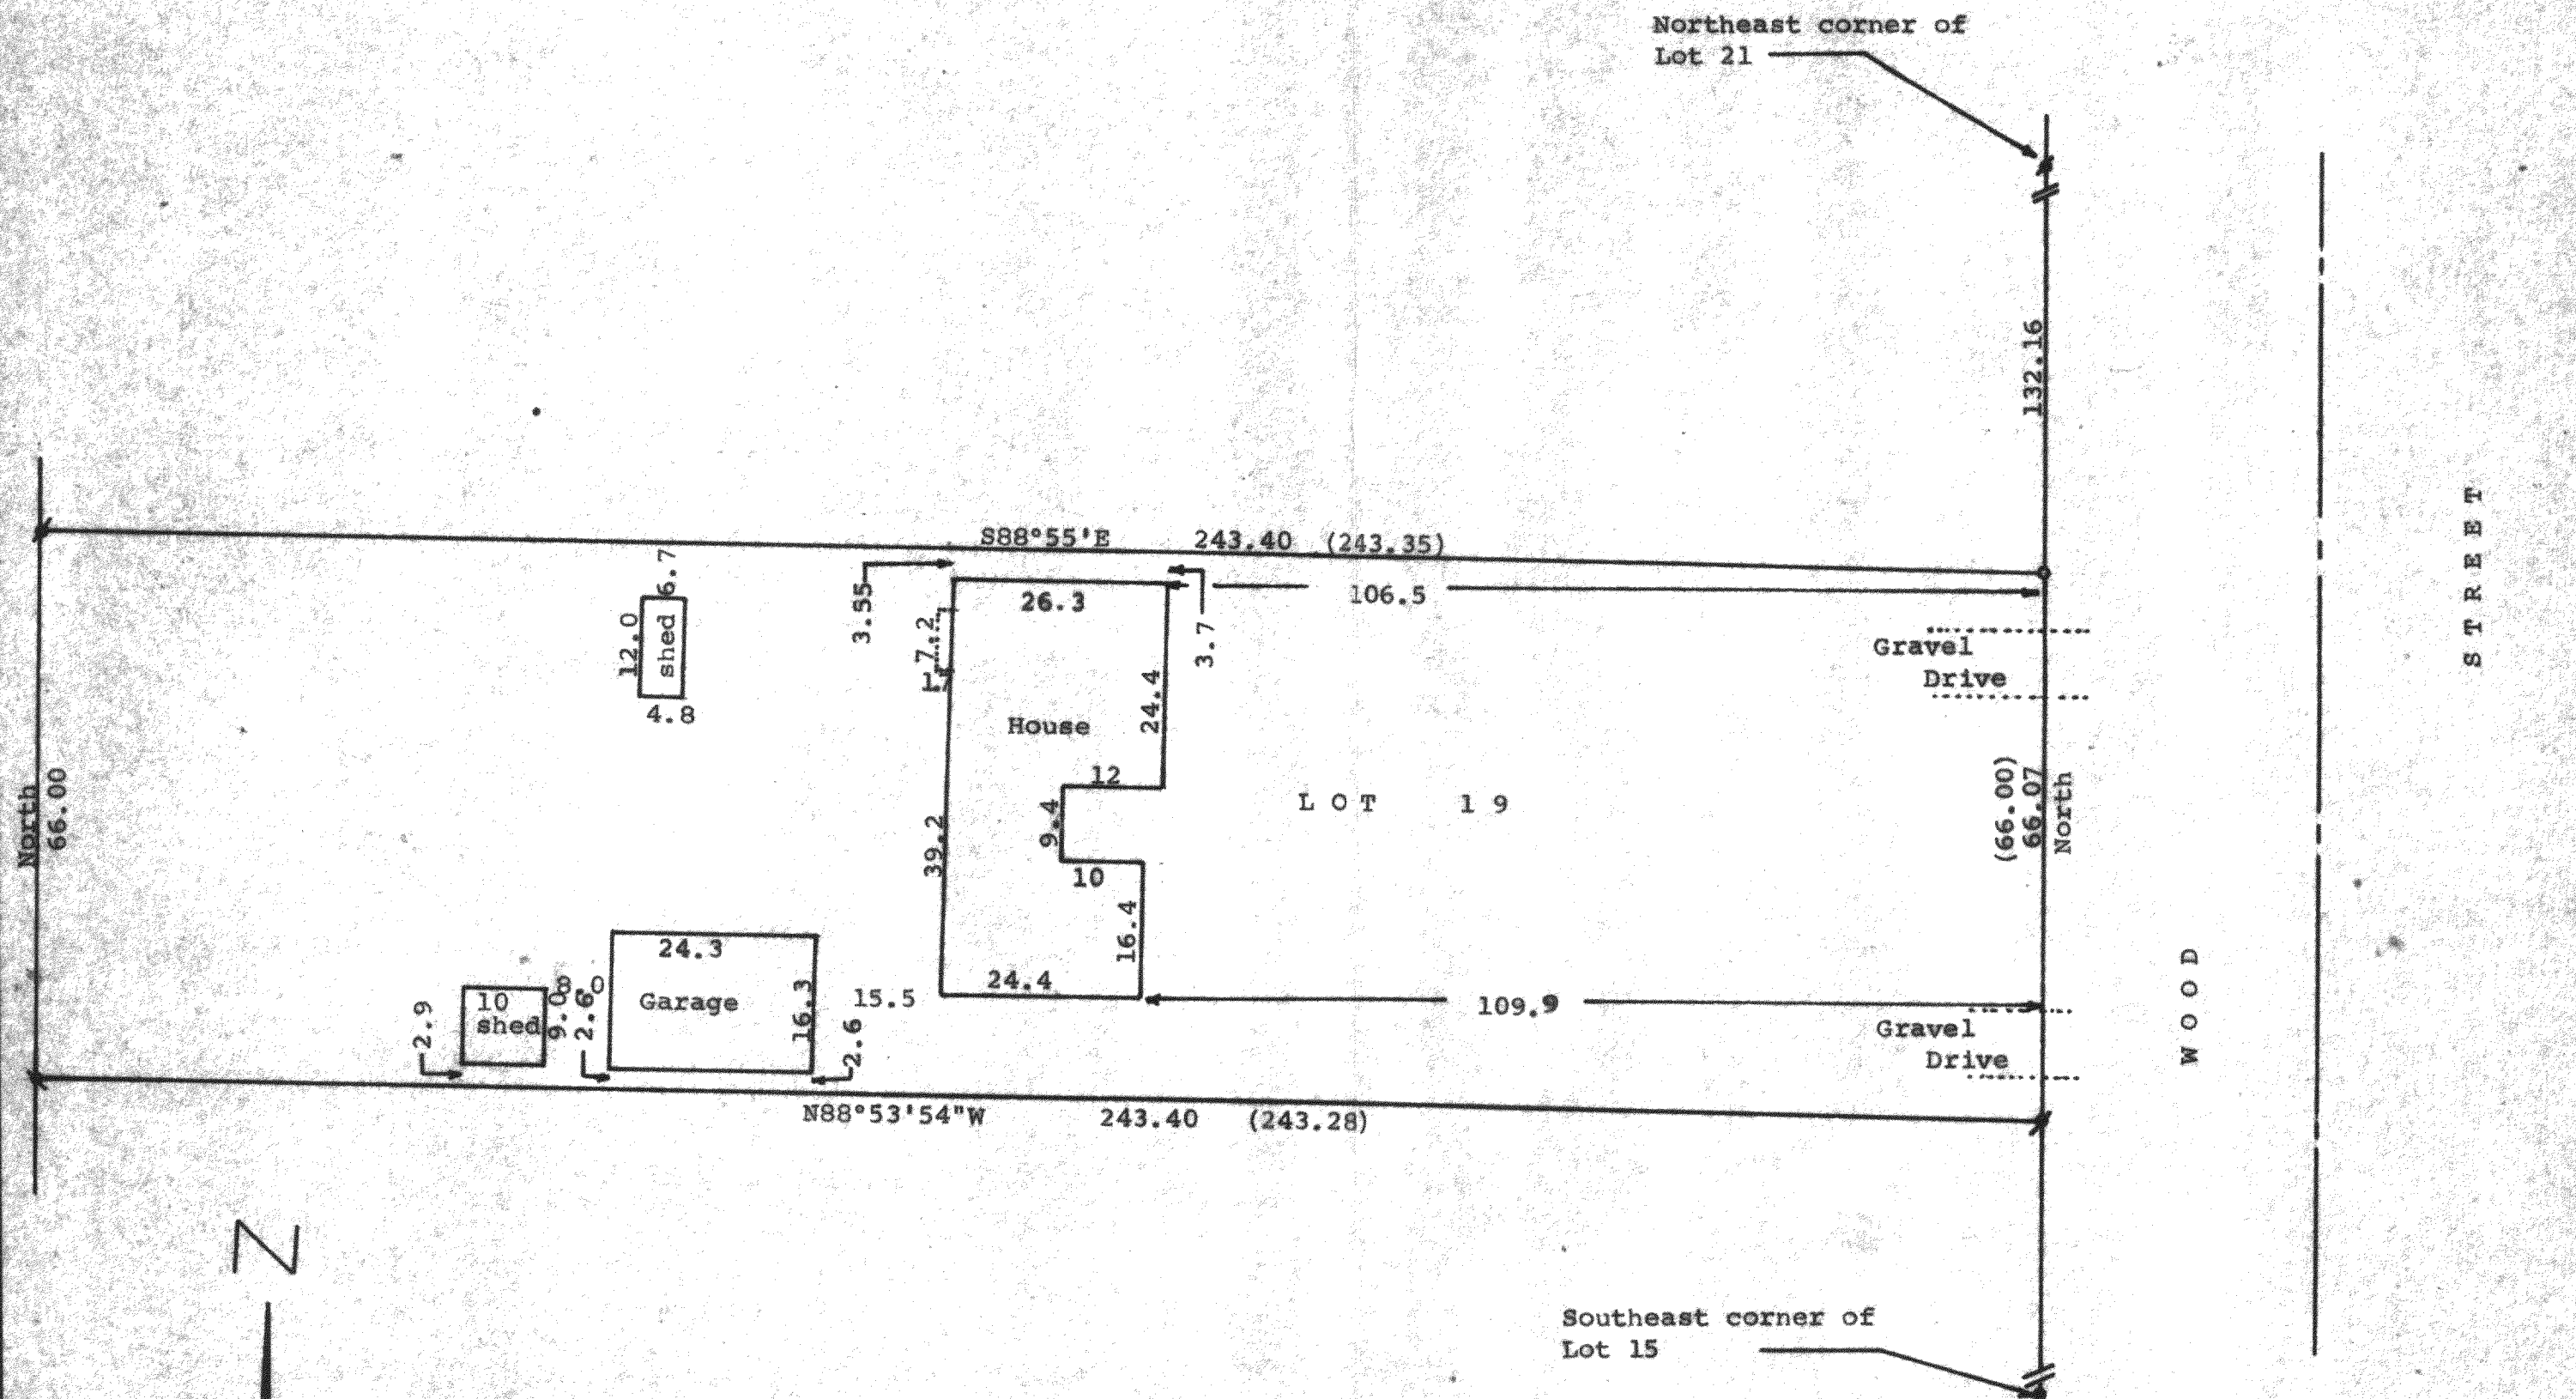


DUNHAM SURVEYING, S. C.
SURVEYING & SUBDIVIDING
DELAVER, WISCONSIN 53115

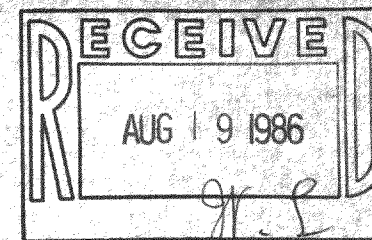

Scale - 1" = 20'
 * = 1" Iron Pipe Found
 / = 1" Iron Rod Found
 • = Concrete Monument Found
 o = 3/4" Iron Pipe Set
 \ = 3/4" Iron Pipe Found
 (0.00) = recorded distance
 Bearings referenced to the west line of
 Wood Street with the assumed bearing of
 North
 Survey ordered by:
 Churchill Real Estate
 322 Park Street
 Walworth, WI 53184

STATE OF WISCONSIN)
 COUNTY OF WALWORTH)

I, George T. Dunham, Surveyor, certify that I have surveyed the
 property described as follows:

Lot 19 of Clarke's 2nd Addition to the Village of Walworth,
 Walworth County, Wisconsin,
 and that the map shown above is a true representation thereof and shows the
 size and location of the property, its exterior boundaries, the location of
 all visible structures and dimensions of all principal buildings thereon,
 boundary fences, apparent easements, roadways and visible encroachments,
 if any, and that I have surveyed the property hereon described according to
 the official records to the best of my knowledge and belief.
 September 10, 1984

George T. Dunham
 George T. Dunham, Surveyor

