


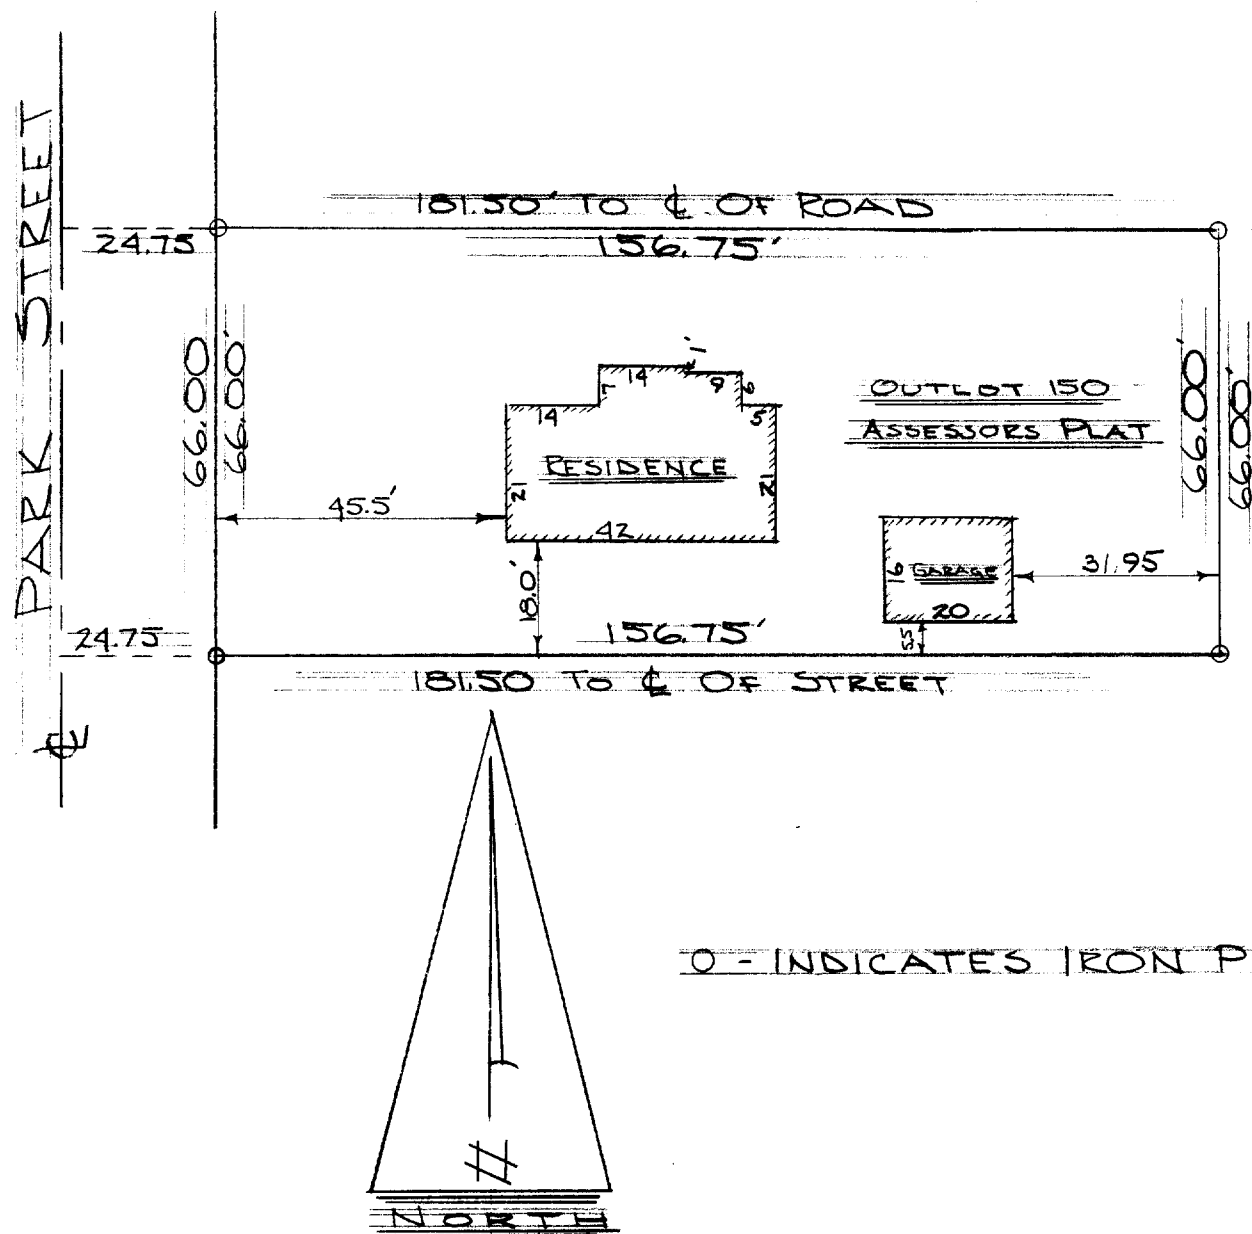


DESCRIPTION:

Outlot #150, Assessor's Plat, Village of Walworth, Walworth County Wisconsin.

CERTIFICATE:

I, hereby certify that I have surveyed the above mentioned property and that the hereon portrayed is an accurate survey and a true representation thereof and correctly shows the exterior boundary lines and the location of buildings and other improvements thereof.

Dated December 2nd 1965.

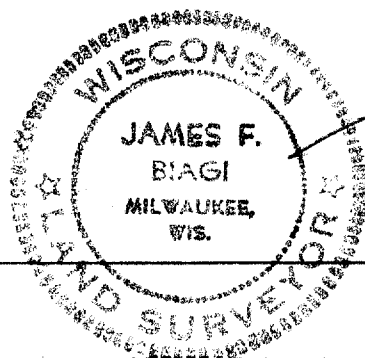

James F. Biagi. RLS 272
Elkhorn, Wisconsin.

9-2B