


CP

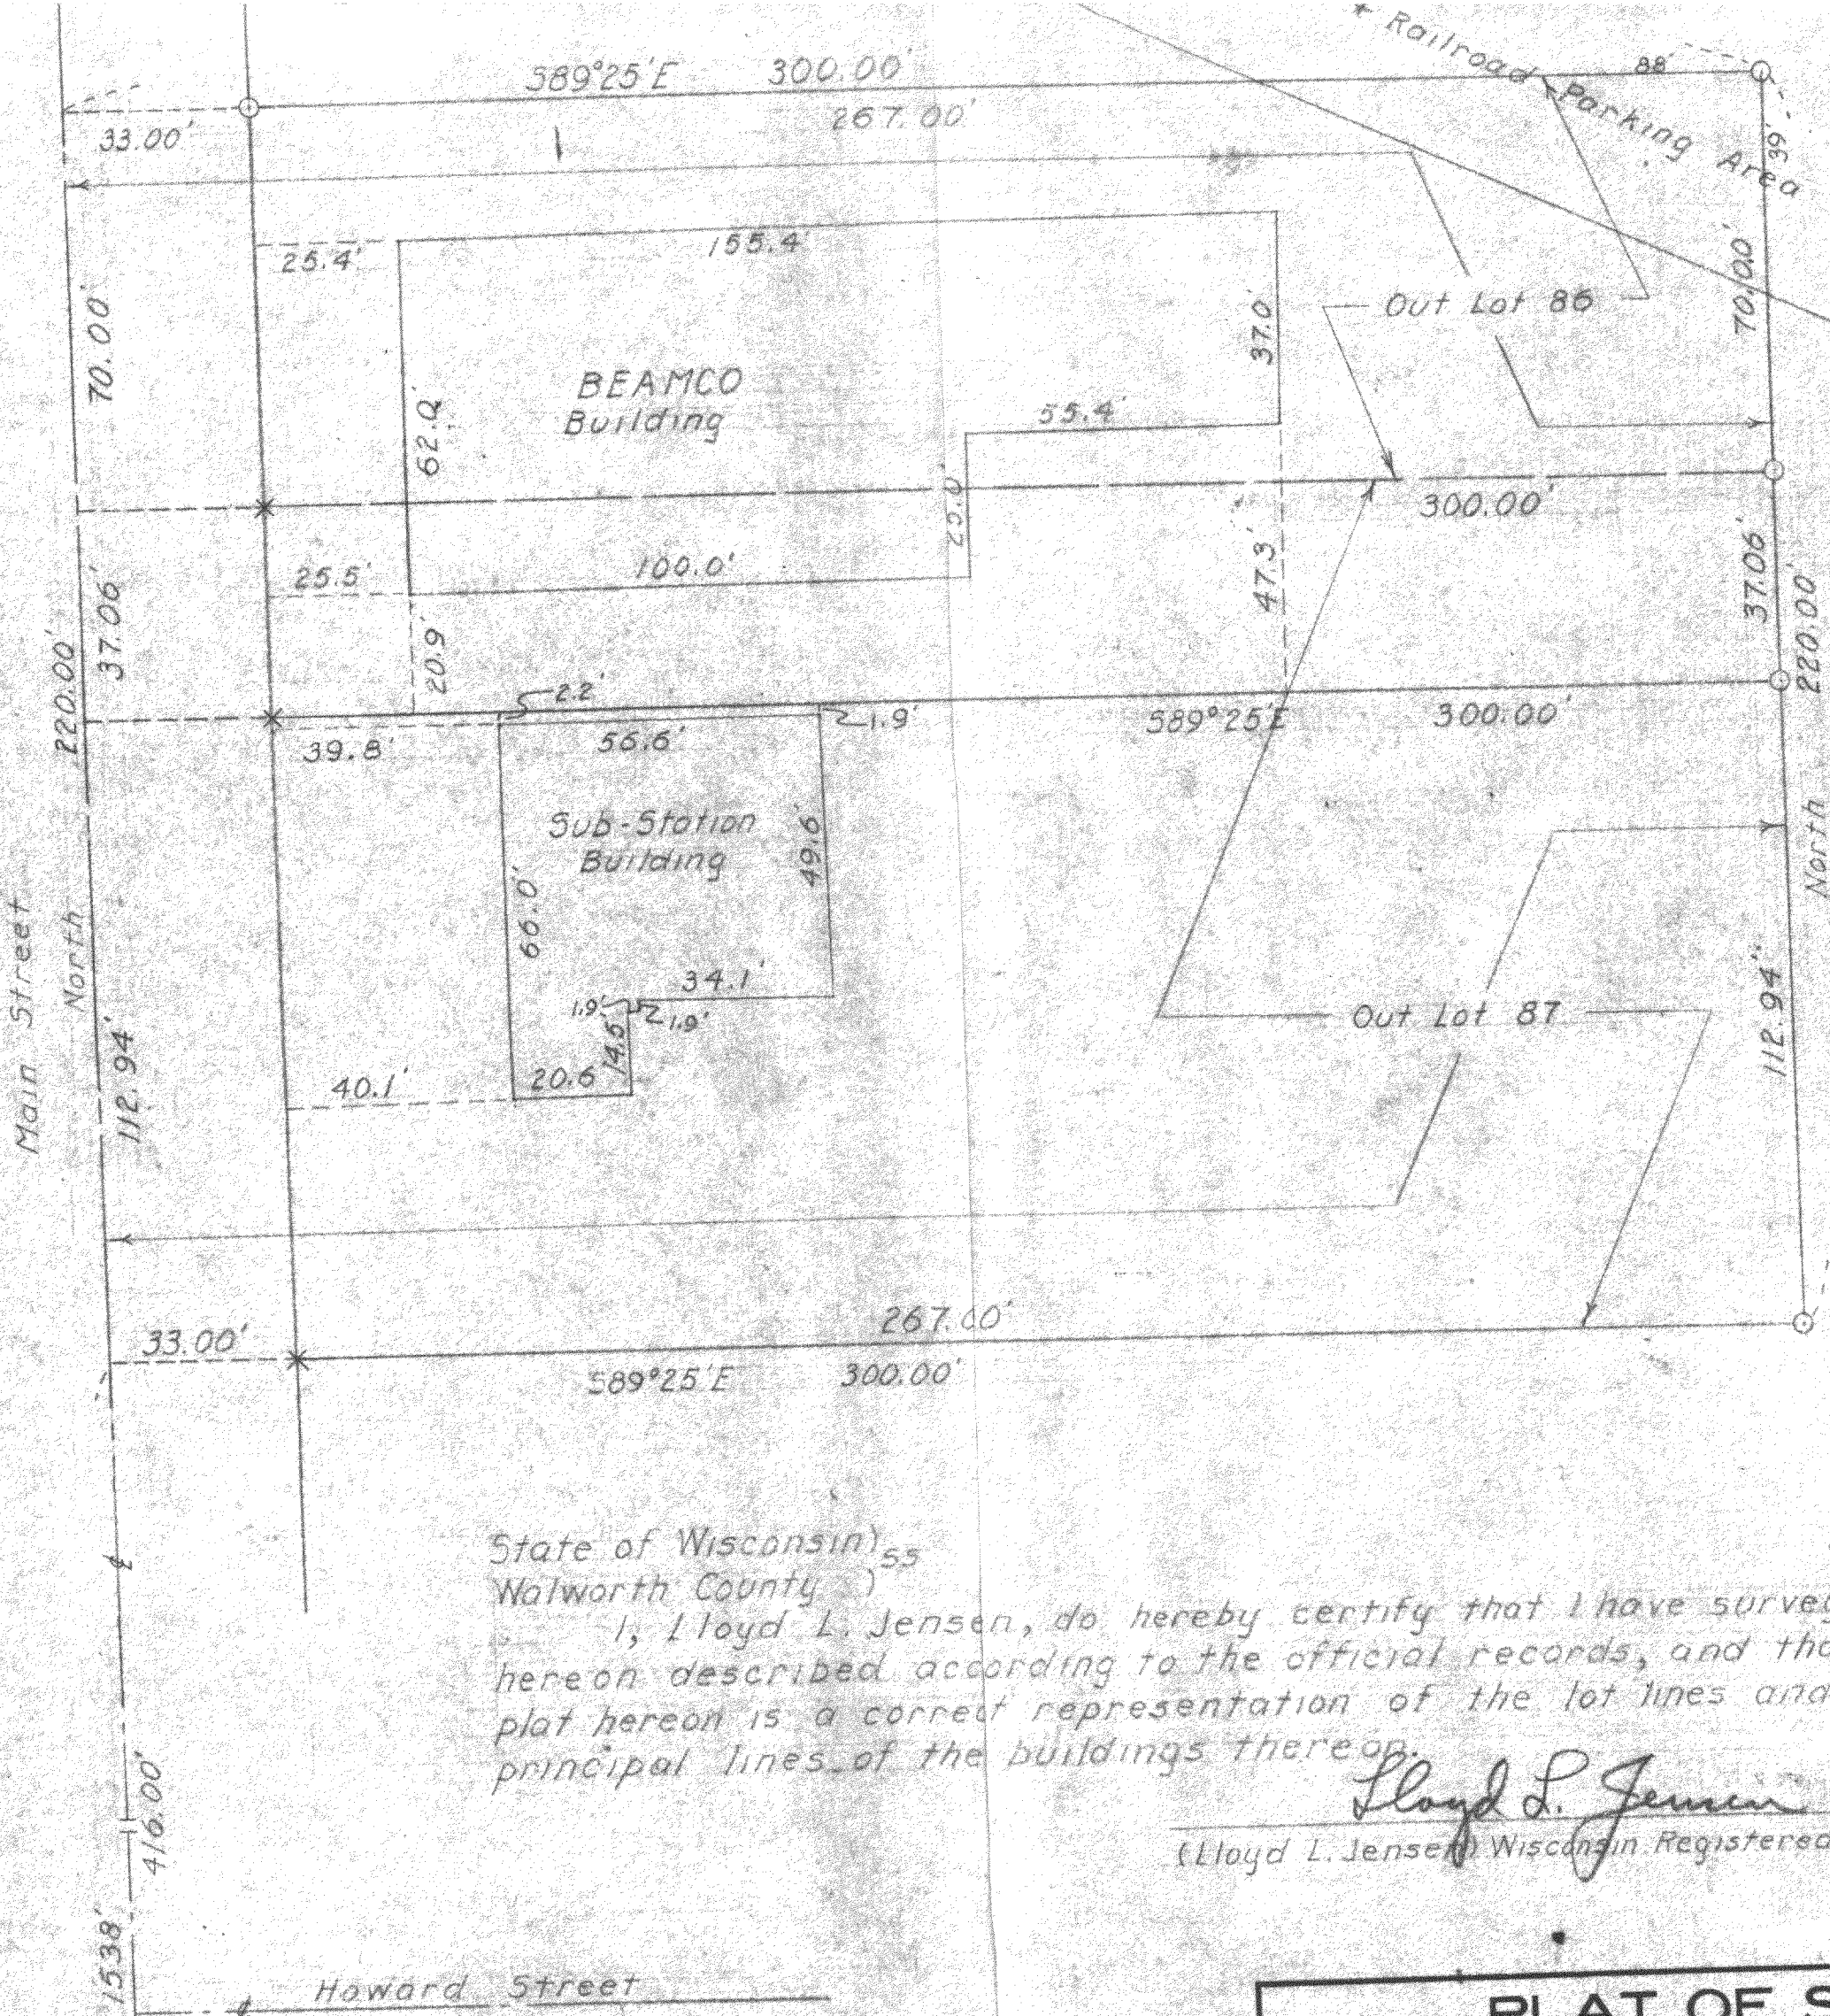

State of Wisconsin)⁵⁵
Walworth County)

I, Lloyd L. Jensen, do hereby certify that I have surveyed the property hereon described according to the official records, and that the plat hereon is a correct representation of the lot lines and the principal lines of the buildings thereon.

Lloyd L. Jensen

(Lloyd L. Jensen) Wisconsin Registered Land Surveyor 5-211

Legend
O - Iron Pipe
X - Cross Cut in Concrete

West 1/4 corner of
Section 22, T1N, R16E



PLAT OF SURVEY OF

Out Lots 86 + 87 - Located in the Southwest 1/4 of Section 22, T1N, R16E, Village of Walworth, Walworth County, Wisconsin

Lloyd L. Jensen
SURVEYOR

DATE March, 1958

9-30

SCALE 1" = 30'