


SURVEYING • MODULAR ZONES

PLAT OF SURVEY OF WEST 1/2 OF SOUTH
1/2 OF OUTLOT 216 OF ASSESSORS PLAT
LOCATED IN NW1/4 OF SW1/4 OF SEC 22
T1N R16E VILLAGE OF WALWORTH
WALWORTH COUNTY WISCONSIN

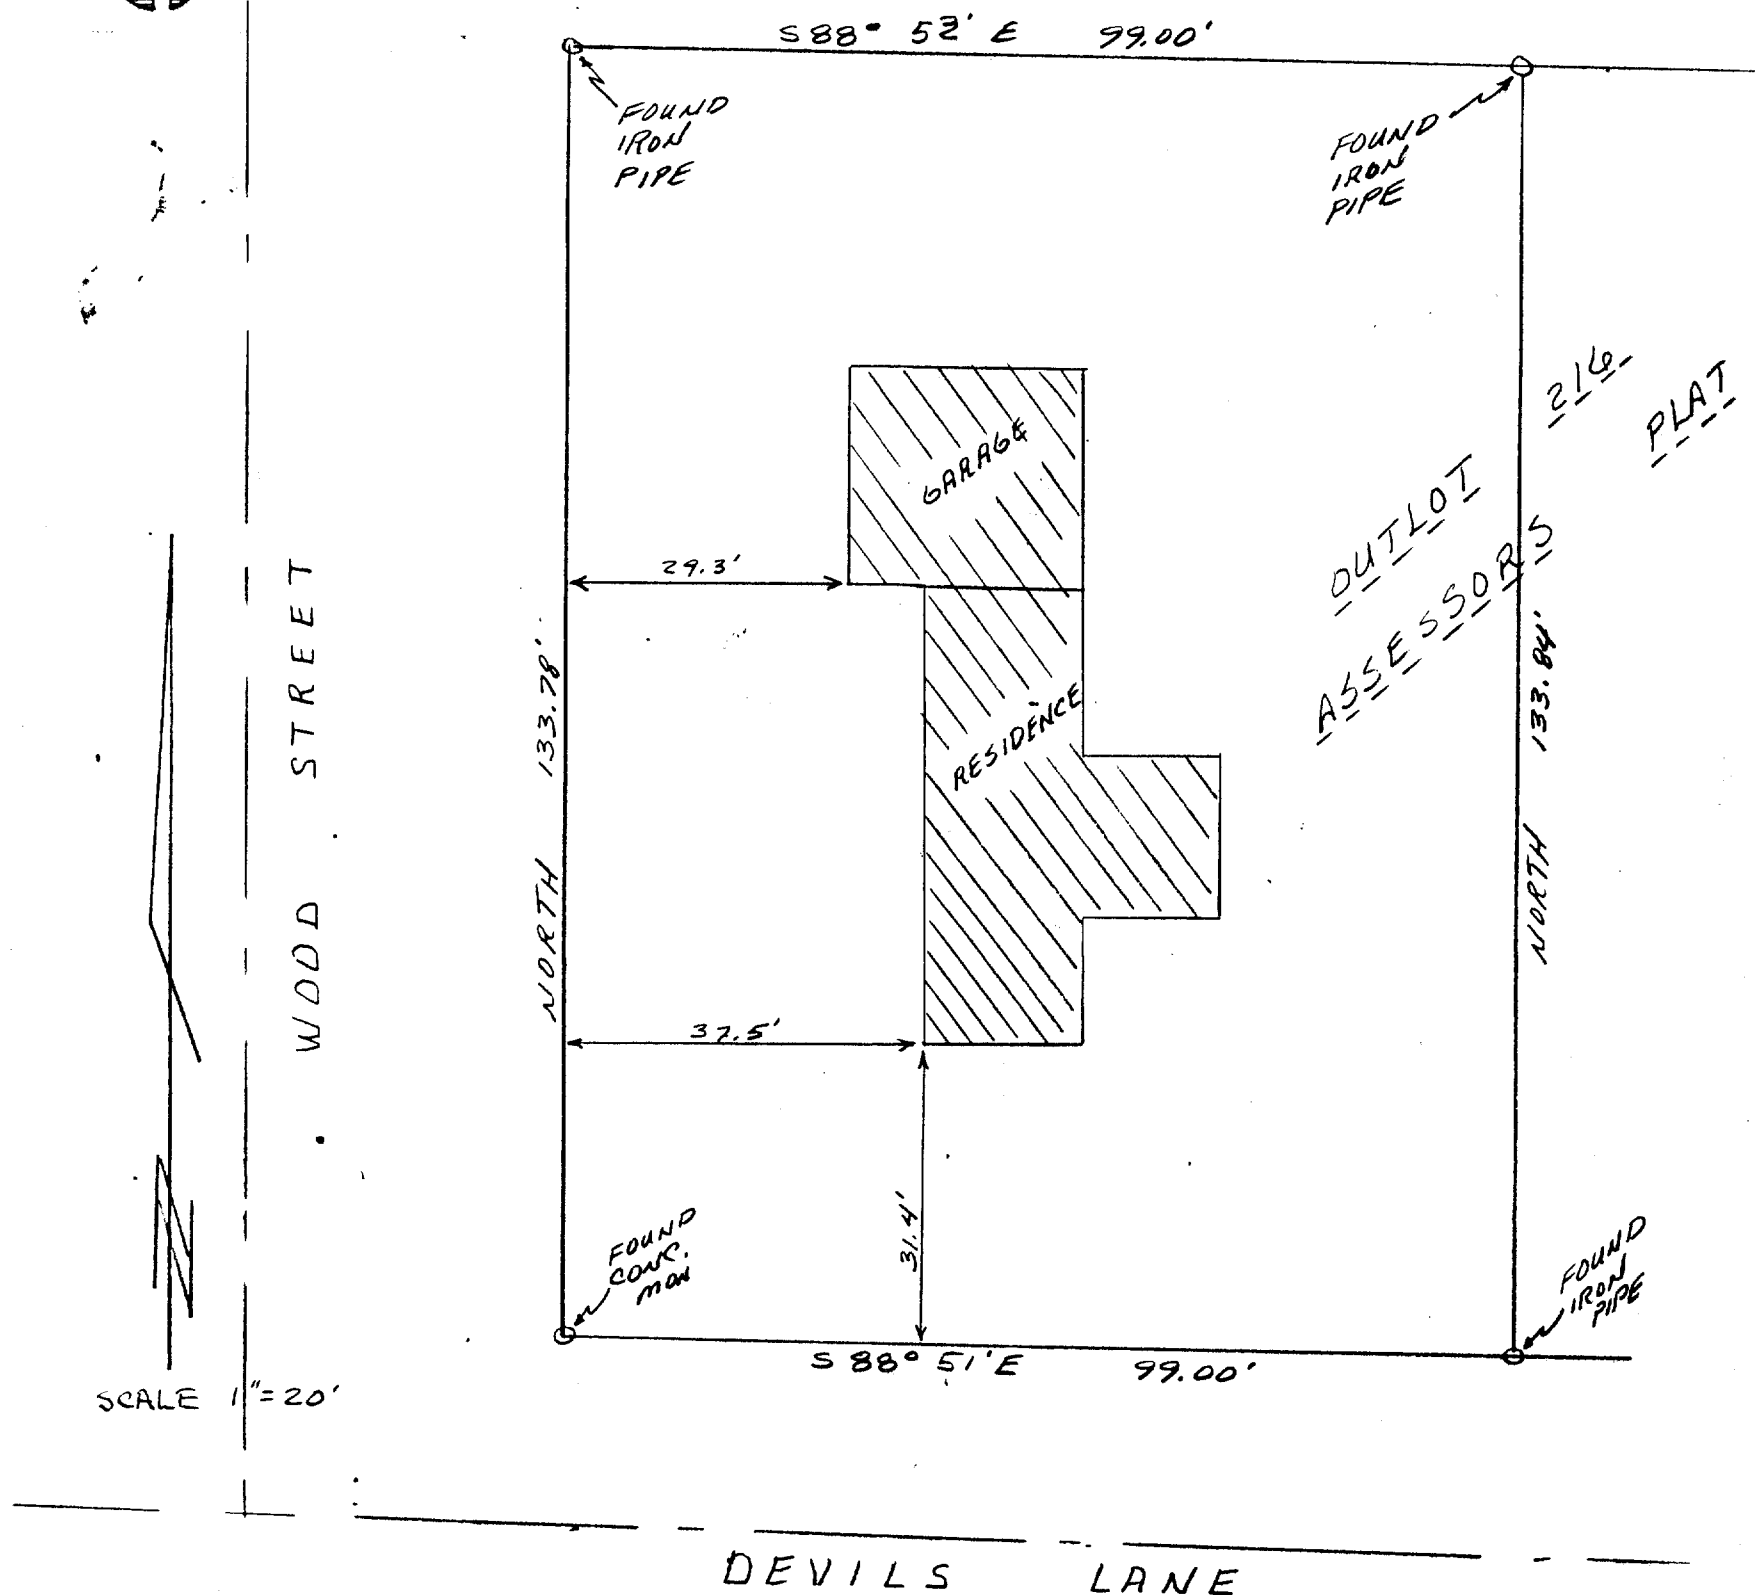


SURVEYED ORDERED BY
BANKERS MORTGAGE JANESVILLE WI

BEARING REFERENCE
WESTERLY LINE OF PARCEL ASSUMED
TO BEAR NORTH

I, DANIEL D. COOPER, REGISTERED SURVEYOR, DO HEREBY CERTIFY THAT I HAVE SURVEYED THE PROPERTY DESCRIBED HEREON AND THAT THE MAP SHOWN HEREON IS A TRUE AND ACCURATE REPRESENTATION THEREOF TO THE BEST OF MY PROFESSIONAL KNOWLEDGE AND BELIEF.

DATED THIS 22 DAY OF JAN . 1985

Daniel D Cooper
DANIEL D. COOPER. RLS NO. 5-1464

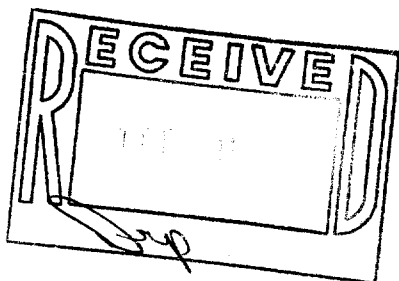

DRAWING NO. 2011