



DUNHAM SURVEYING, S.C.
SURVEYING & SUBDIVIDING
DELAVER, WISCONSIN 53115

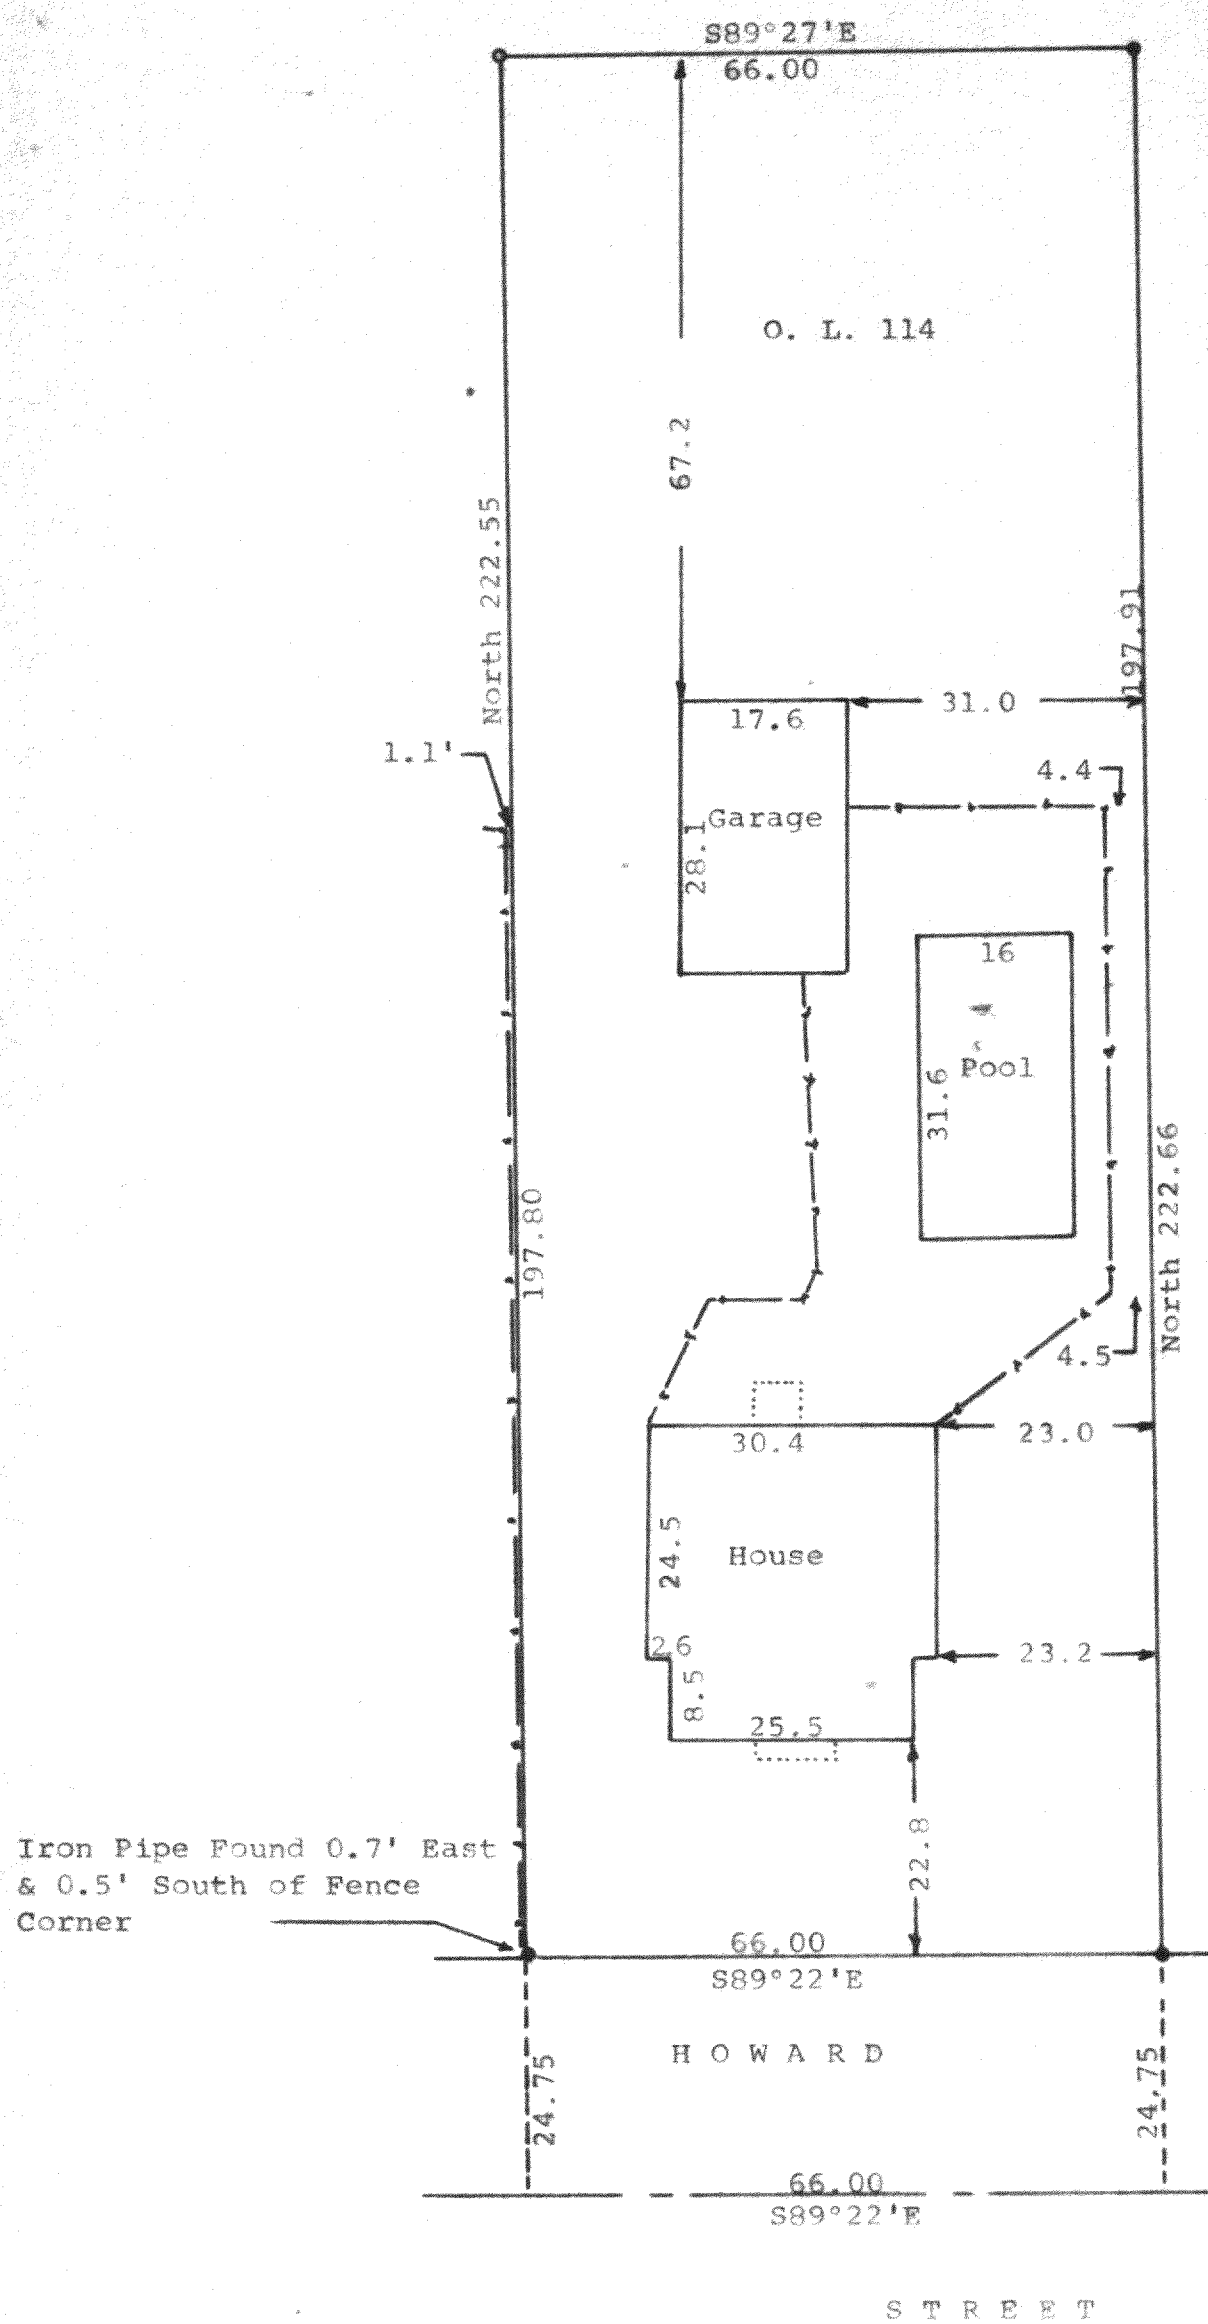

Scale - 1" = 20'
 • = 1" Iron Pipe Found
 • = 1 1/4" Iron Pipe Found
 --- = Fence line
 Bearings referenced to North along the east line of Outlot No. 114
 Survey ordered by: Churchill Real Estate
 322 Park
 Walworth, WI 53184

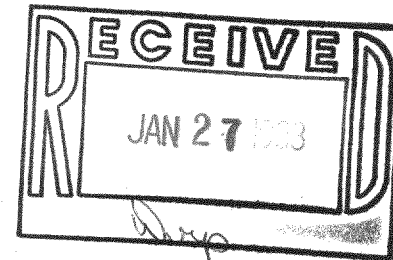

STATE OF WISCONSIN)
 COUNTY OF WALWORTH)

I, George T. Dunham, Surveyor, certify that I have surveyed the property described as follows:
 Outlot No. 114 of the Assessor's Plat of the Village of Walworth, Walworth County, Wisconsin,
 and that the above map is a true representation thereof and shows the size and location of the property, its exterior boundaries, the location of all visible structures and dimensions of all principal buildings thereon, boundary fences, apparent easements, roadways and visible encroachments, if any, and that I have surveyed the property hereon described, according to the official records, to the best of my knowledge and belief.
 January 14, 1988

George T. Dunham
 George T. Dunham, Surveyor

