


DUNHAM SURVEYING, S.C.
SURVEYING & SUBDIVIDING
DELAVER, WISCONSIN 53115

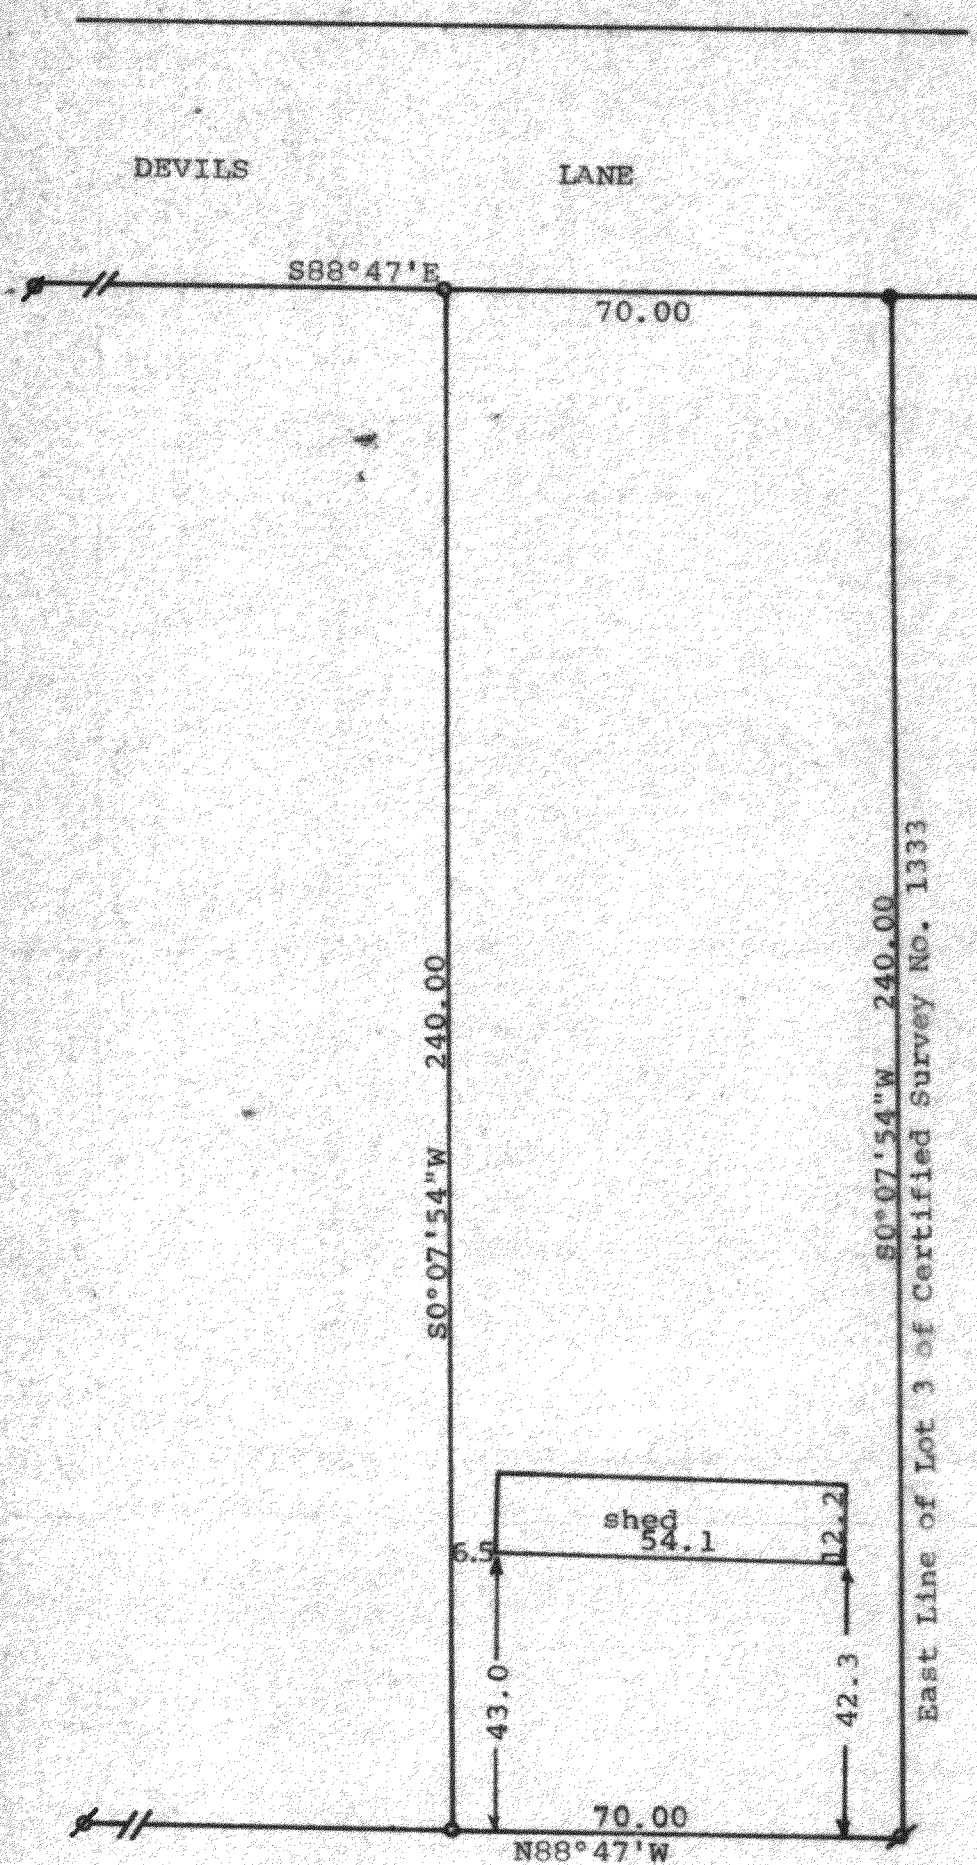


N

Scale - 1" = 30'

- = Concrete Monument Found
- ⊗ = 1" Iron Pipe Found
- = 1" Iron Pipe Set

Bearings are referenced to those shown on
Certified Survey No. 1333
Owner: William J. Washo
537 Devils Lane
Walworth, WI 53184

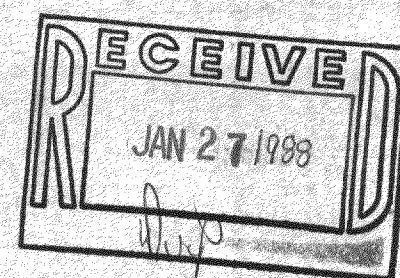

STATE OF WISCONSIN) SS
COUNTY OF WALWORTH)

I, George T. Dunham, Surveyor, certify that I have surveyed the
property described as follows:

The East 70.00 feet of Lot 3 of Certified Survey No. 1333, recorded
in Volume 6 of Certified Surveys on Page 155 as Document No. 97656,
being a part of O.L. 219 of the Assessor's Plat in the Village of
Walworth, in the SE $\frac{1}{4}$ of the SW $\frac{1}{4}$ of Section 22, T 1 N, R 16 E, Walworth
County, Wisconsin. Said survey was for a lot line adjustment and
not for the purpose of creating a new building lot.

and that the map shown hereon is a correct representation thereof and shows
the size and location of the property, its exterior boundaries, the location
of all visible structures and dimensions of all principal buildings thereon,
boundary fences, apparent easements, roadways and visible encroachments, if
any, and that I have surveyed the property hereon described according to the
official records, to the best of my knowledge and belief.

December 1, 1987

George T. Dunham
George T. Dunham, Surveyor

