



Plat of Survey of Lot 2, DaLaPe Heights being located
in the Villiage of Walworth, Walworth Couty, WI

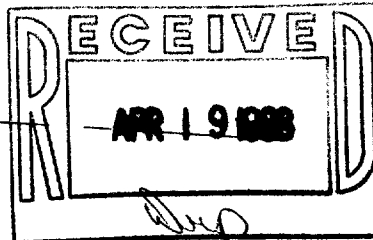

D. D. COOPER & CO., INC.
Daniel D. Cooper
Rt. 4 Box 508B
Elkhorn, WI 53121

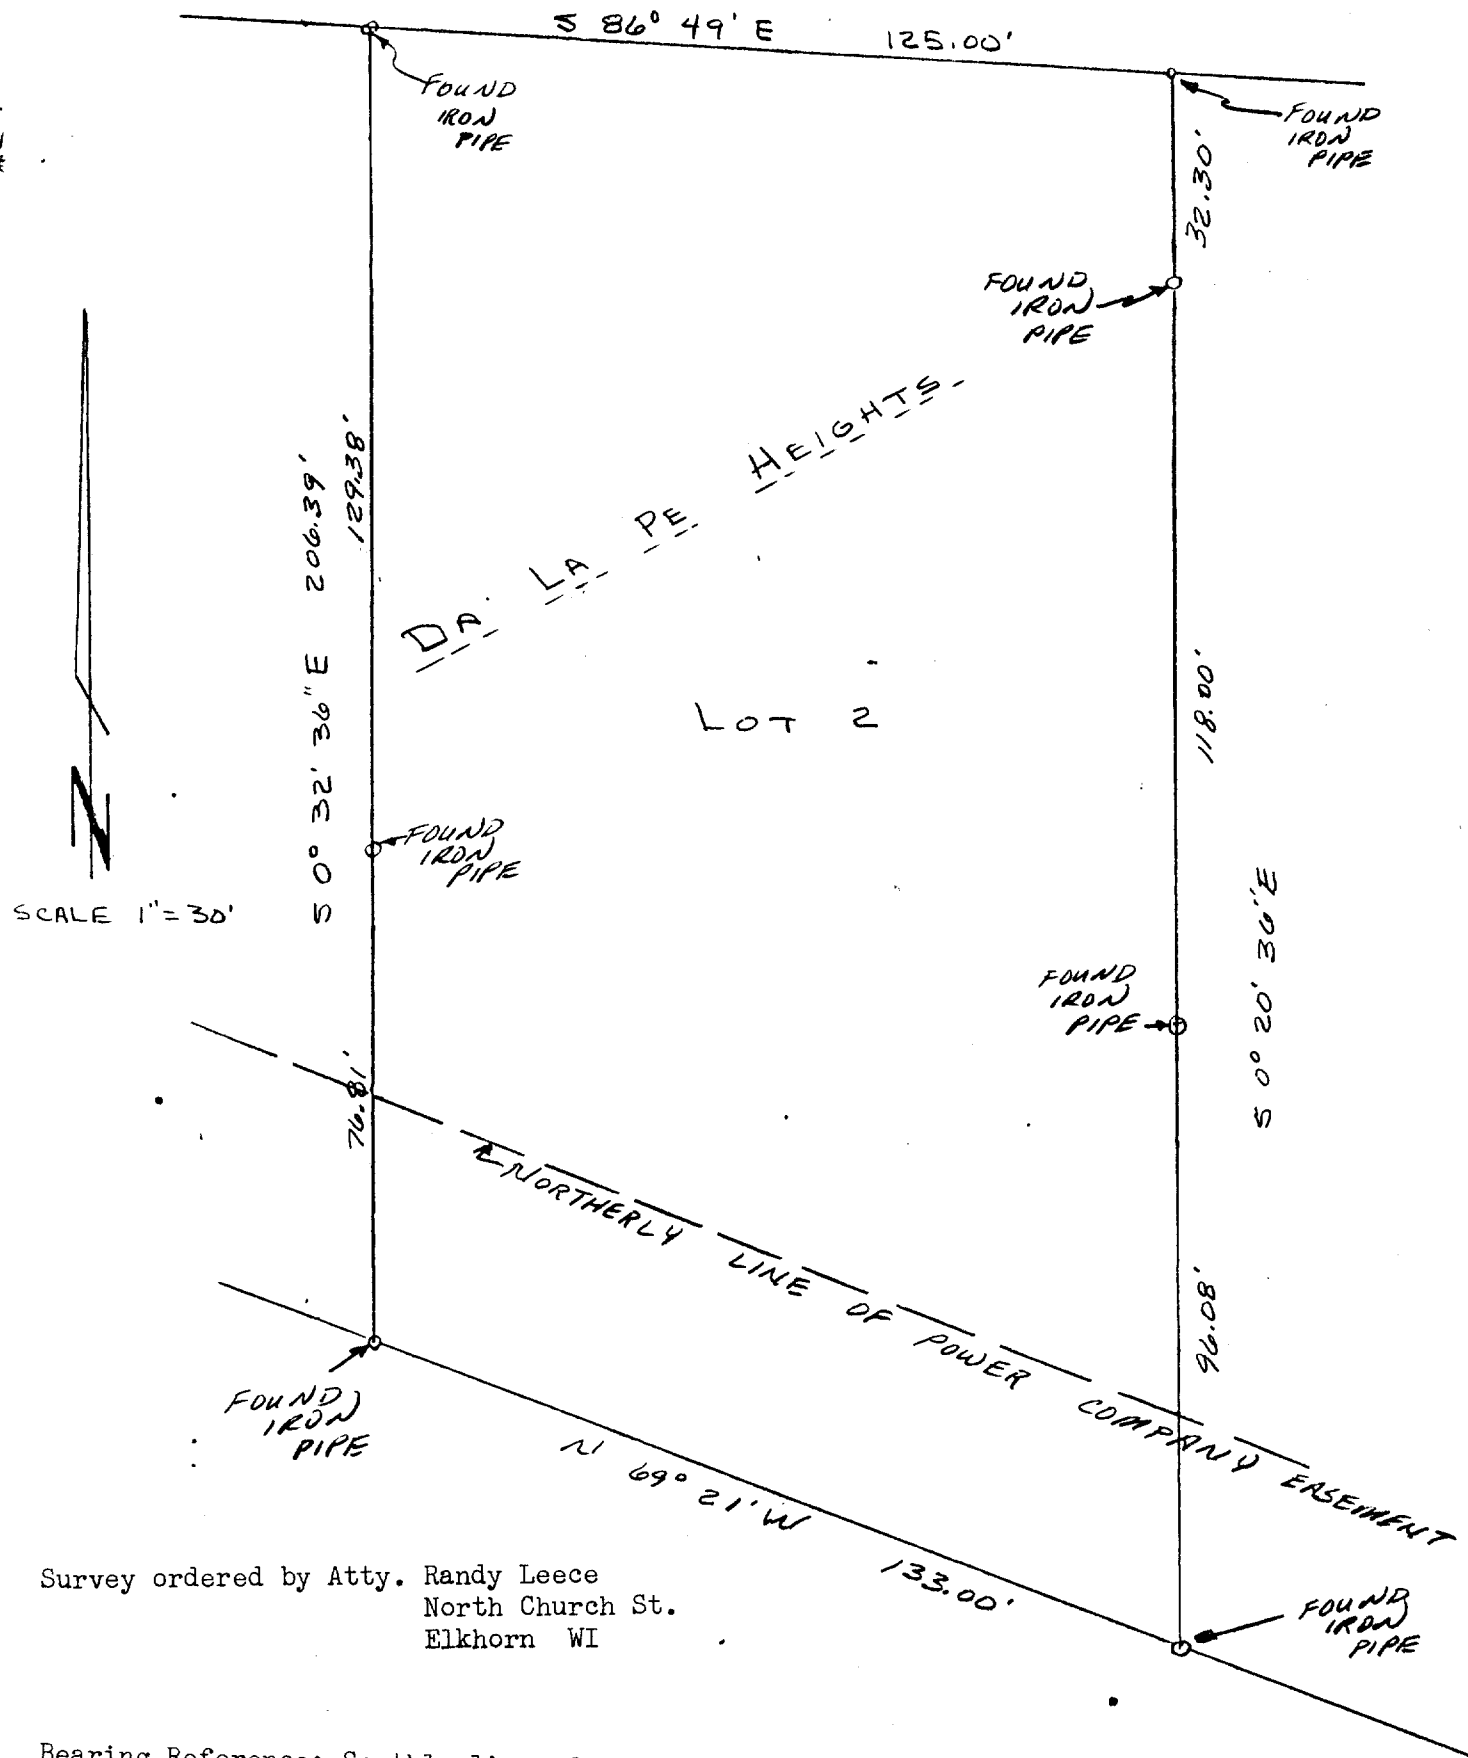


Survey ordered by Atty. Randy Leece
North Church St.
Elkhorn WI

Bearing Reference: Southly line of Hill St. assumed to
Bear S 86° 49'E as platted

I hereby certify that I have surveyed the property described hereon
and that the map shown hereon is a true and accurate representation
thereof the best of my professional knowledge and belief.

Dated this 14 day of May 1987

Daniel D. Cooper, RLS NO. S-1464

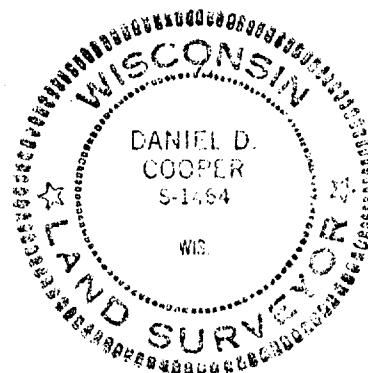

DRAWING NO. 3094
9-331