


DUNHAM SURVEYING, S.C.

SURVEYING & SUBDIVIDING  
DELAVAL, WISCONSIN 53115

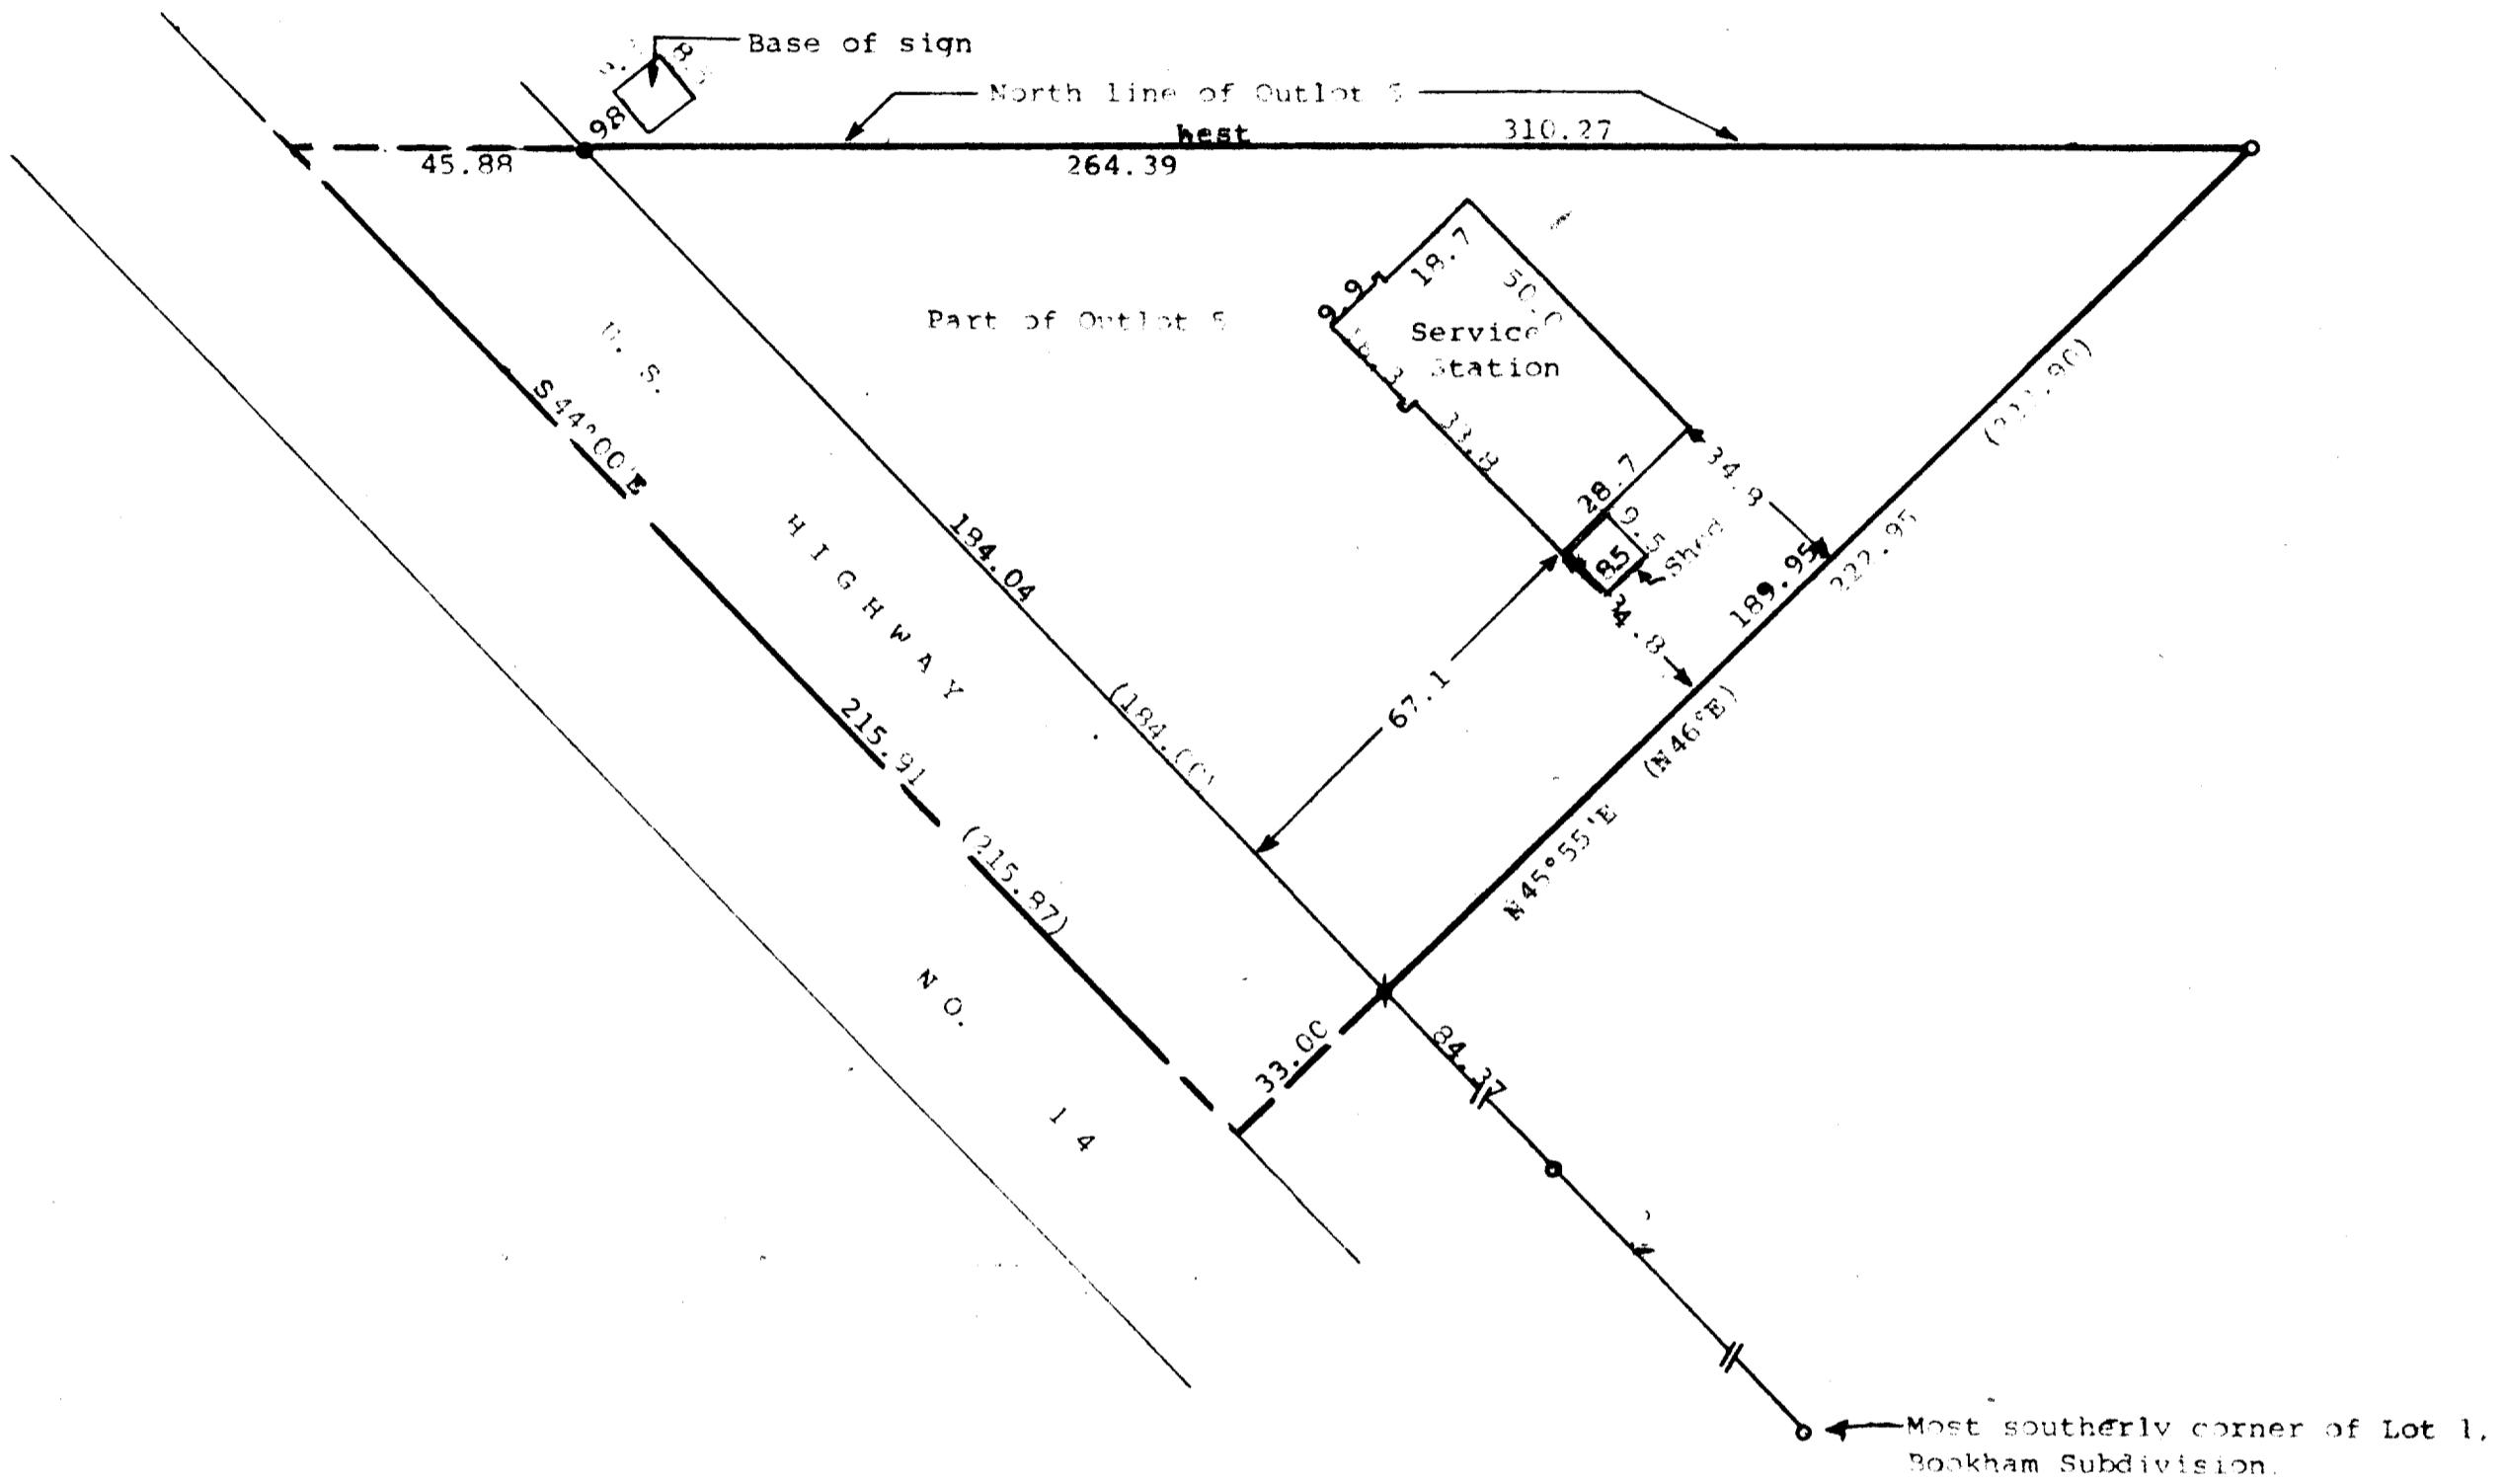

STATE OF WISCONSIN) SS  
COUNTY OF WALWORTH)

I, Richard C. Schulz, Surveyor, certify that I have surveyed the property described as follows,

A parcel of land located in Outlet 5 of the Assessor's Plat of the Village of Walworth, Walworth County, Wisconsin, described as follows: Beginning at the Northwest corner of said Outlet 5 which is also a point on the centerline of U. S. Highway No. 14; thence S44°00'E, along said centerline of highway, 215.87 feet; thence N46°00'E, 222.90 feet to the north line of said Outlet 5; thence West, along said north line of said Outlet 5, 310.27 feet to the place of beginning,

and that the map shown hereon is a correct representation thereof and shows the size and location of the property, its exterior boundaries, the location of all visible structures and dimensions of all principal buildings thereon, boundary fences, apparent easements, roadways and visible encroachments, if any and that I have surveyed the property hereon described according to the official records, to the best of my knowledge and belief.

August 10, 1988.

Richard C. Schulz  
Richard C. Schulz, Surveyor

Scale - 1" = 30'  
• = Concrete Monument Found  
♦ = 1" Dia. Iron Pipe Found  
○ = 3/4" Dia. Iron Pipe Found  
(0.00) = Recorded Distance or Bearing  
Bearings are referenced to the previously recorded bearing along the centerline of U. S. Highway No. 14, with a bearing of N44°00'W.  
Survey Ordered By: Big Foot Realty  
302 Kenosha St.  
Walworth, WI 53184

