


PLAT OF SURVEY of

Lot 22, Block 1 of Grandall and Swinney's Subdivision,  
Village of Walworth, Walworth County, Wisconsin

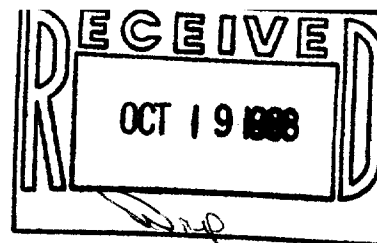

ORDERED BY: Terry Maynard  
Lt. 1 N600 Peters Road  
Chilton, WI 53585

SURVEYED BY:  
Jensen Surveying & Mapping S.C.  
45 S. Wisconsin St. P.O. Box 322  
Elkhorn, Wisconsin. 53121  
(414) 723-3434



LEGEND


- o Found iron pipe
- Found iron rod
- ⌘ Power pole

Note: This survey plat is not  
certified unless signed  
and sealed in red ink.

SCALE: 1" = 30'

Mapping Date: Sept. 27, 1988

- Overhead wires
- ( ) Recorded dimension

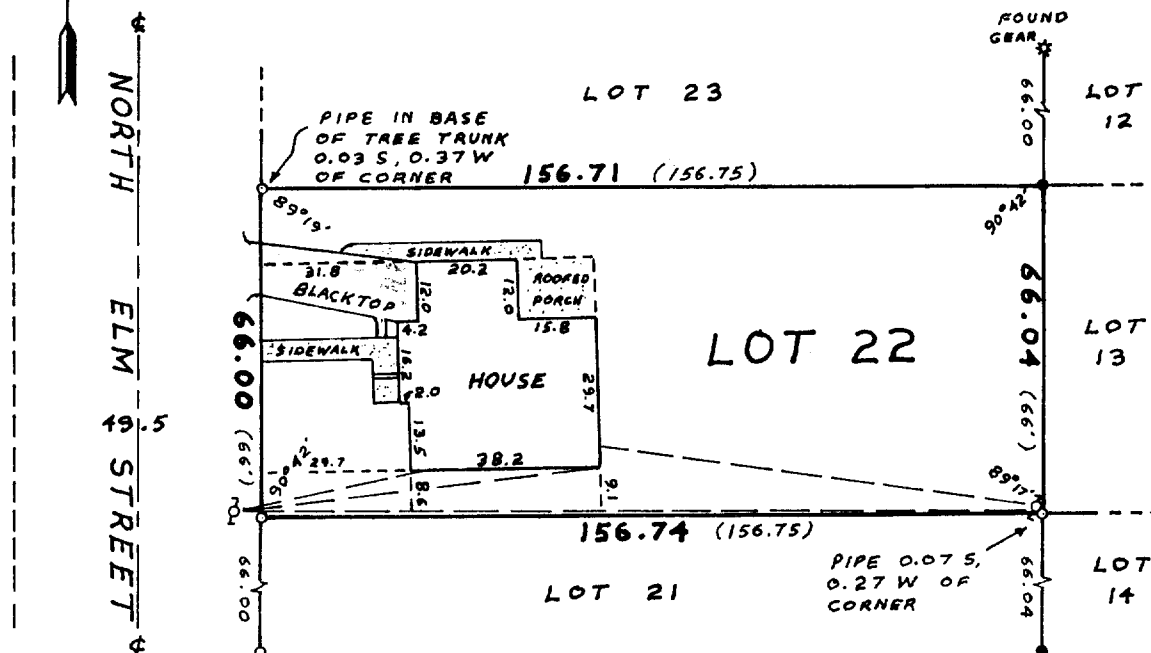

Copyright © 1988 by Jensen Surveying & Mapping S.C.

All rights reserved. No part of this survey plat may be reproduced or transmitted in any form by any means - graphic, electronic, or mechanical, including photocopying, tracing, or information storage and retrieval systems - without permission in writing from Thomas P.A. Jensen, Jensen Surveying & Mapping S.C.

I, Thomas P.A. Jensen, Wisconsin Registered Land Surveyor, do hereby certify that this survey was performed by me, or under my direction, in full compliance with the owner's/agent's instructions and Chapter A-E 5 of the Wisconsin Administrative Code "Minimum Standards For Property Surveys"; and that this map is an accurate representation thereof to the best of my knowledge and belief.

Thomas P.A. Jensen R.L.S-1084  
Jensen Surveying & Mapping S.C.

1988.100

9-349