


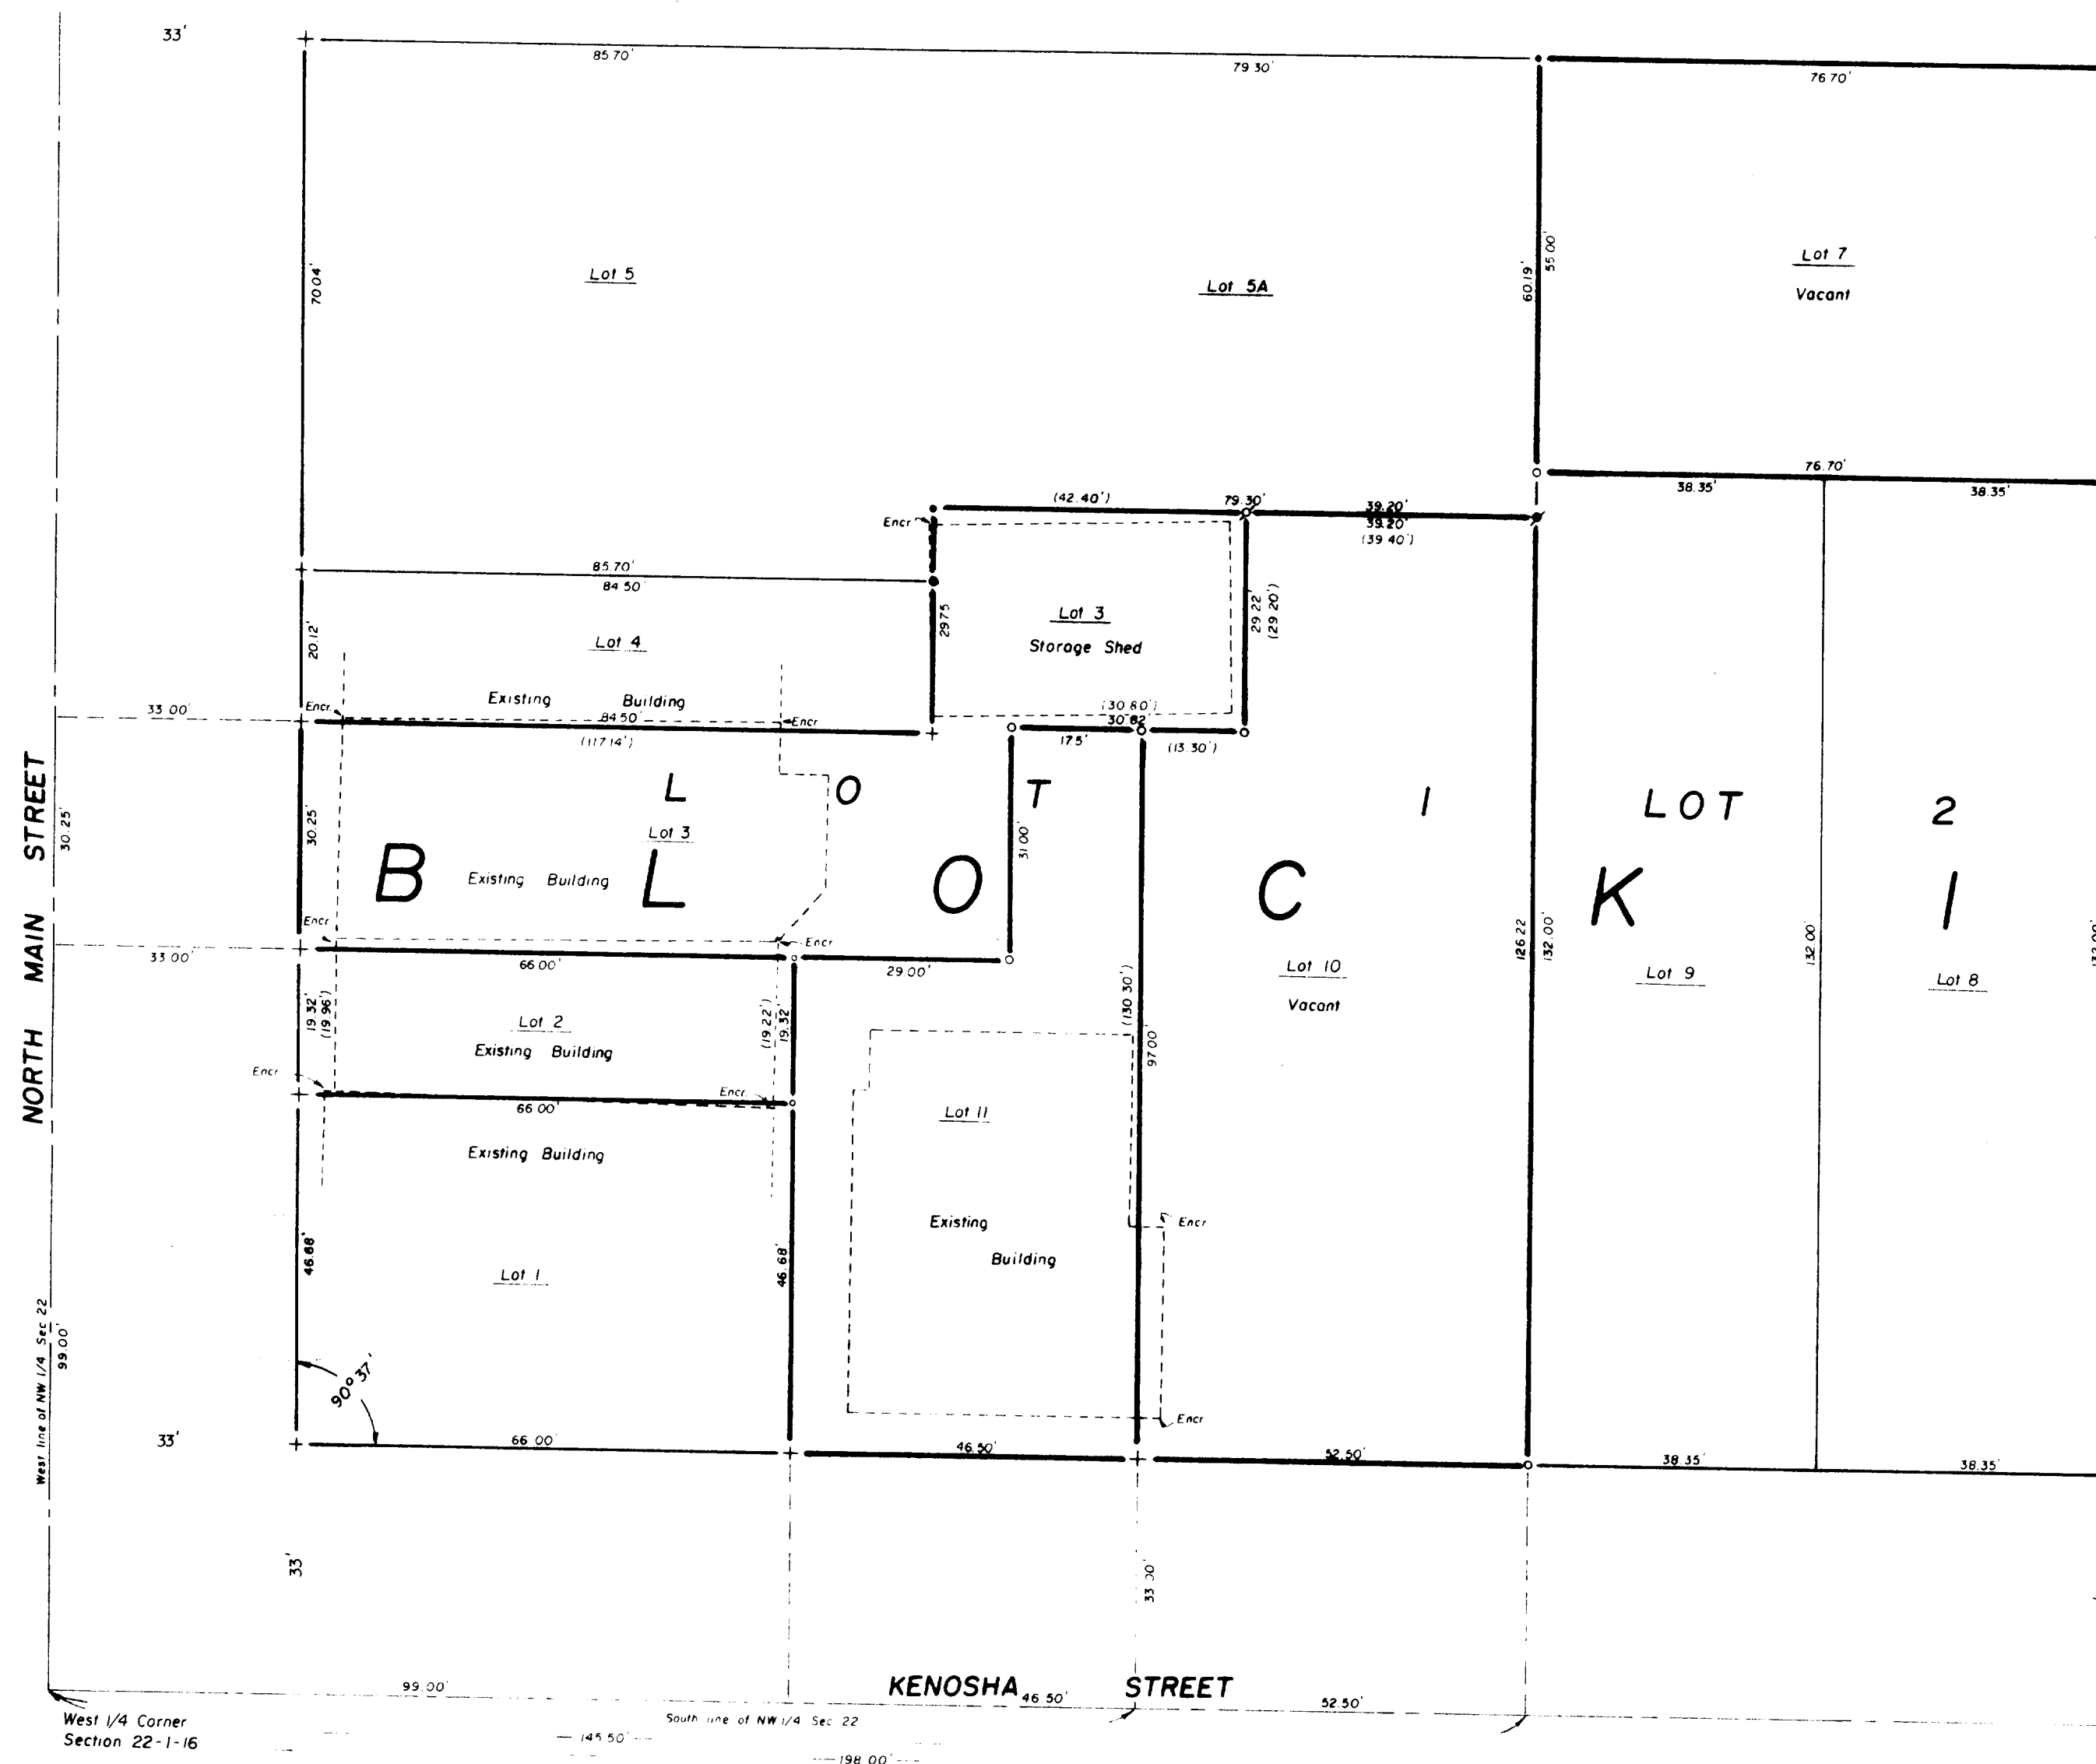

# LEGAL DESCRIPTIONS OF

Parts of Lot 1 and Lot 2 of Block 1, Original Plat of the Village of Walworth, Walworth County, Wisconsin.

## Parcel #2

Commencing at the West 1/4 section corner of Section 22; thence North 99 feet; thence South 89°24' East, 33.00 feet to the point of beginning; thence continue South 89°24' East, 66.00 feet on the north line of the out lot; thence South 19.22 feet; thence North 89°58' West, 66.00 feet; thence North 19.96 feet to the point of beginning.

## Parcel #3

Commencing 99 feet North of 1/4 corner; thence East 128 feet; thence North 31 feet; thence East 30.8 feet; thence North 29.2 feet; thence West 42.4 feet; thence South 29.75 feet; thence West 117.14 feet to the section line; thence South 30.25 feet to the point beginning.

## Parcel #7


Beginning at a point on the East-West 1/4 line 198.00 feet East of the 1/4 corner; thence North 165.00 feet to the point of beginning; thence continuing North 55.00 feet; thence East 76.70 feet; thence South 55.00 feet; thence West 76.70 feet to the point of beginning.

## Parcel #10

Beginning at a point on the East-West 1/4 line, 145.5 feet East of the 1/4 corner; thence North 130 feet; thence East 13.3 feet; thence North 29.2 feet; thence East 39.4 feet to the east line of Lot 1; thence South on the east line to the East-West 1/4 line; thence West to the point of beginning.

## Parcel #11


Beginning at a point on the East-West 1/4 line, 99 feet East of the 1/4 corner; thence North 99 feet to a point 99 feet East of the west line; thence East 29 feet to an iron pipe; thence North 31 feet; thence East 17.5 feet to an iron pipe; thence South 130.3 feet to the East-West 1/4 line; thence West to the point of beginning.

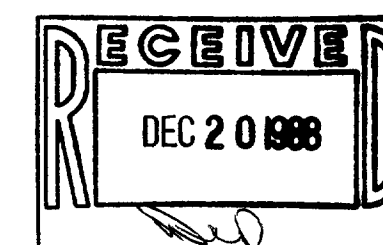

## LEGEND

- + CHISEL CUT IN CONCRETE
- o SET PK NAIL
- FOUND IRON PIPE - 1"
- # FOUND IRON PIPE - 1 1/4"
- SET IRON PIPE - 1"
- FOUND IRON ROD
- o SET R.R. SPIKE
- FENCE
- ( ) RECORDED AS
- / EXISTING GROUND ELEVATION

THIS IS AN ORIGINAL COPY OF THE SURVEY. IF SEAL IS IMPROVED.

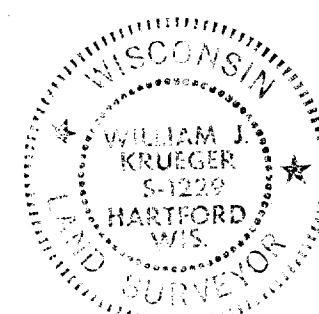

"I hereby certify that I have surveyed the above described property and that the above map is a true representation thereof and shows the size and location of the property, its exterior boundaries, the location of all visible structures and dimensions of all principal buildings thereon, boundary fences, apparent easements, roadways and visible encroachments, if any."

"This survey is made for the use of the present owners of the property, and also those who purchase mortgage or guarantee the title thereto within one year from date hereof."

NO MONUMENTATION HAS BEEN WAIVED IN ACCORDANCE WITH A-E 5.01(b) OF THE WISCONSIN ADMINISTRATIVE CODE

*William J. Krueger*  
WISCONSIN REGISTERED LAND SURVEYOR

## PLAT OF SURVEY FOR JOHN HEYER OF

Parts of Lot 1 and Lot 2 of Block 1 of the Original Plat of the Village of Walworth, Walworth County, Wisconsin.

DATE

11/8/88

SCALE

1" = 20'

DRAWN

SRM

**ROBERS & BOYD, INC.**  
CONSULTING ENGINEERS  
LAND SURVEYORS

326 NORTH PINE STREET  
BURLINGTON, WISCONSIN 53108  
PHONE 414-763-7834

JOB NO.

88231

CHECKED

14R

SHEET

1 OF 1

REVISED

9-351