


GEORGE T. DUNHAM
SURVEYING & SUBDIVIDING
DELAVER, WISCONSIN

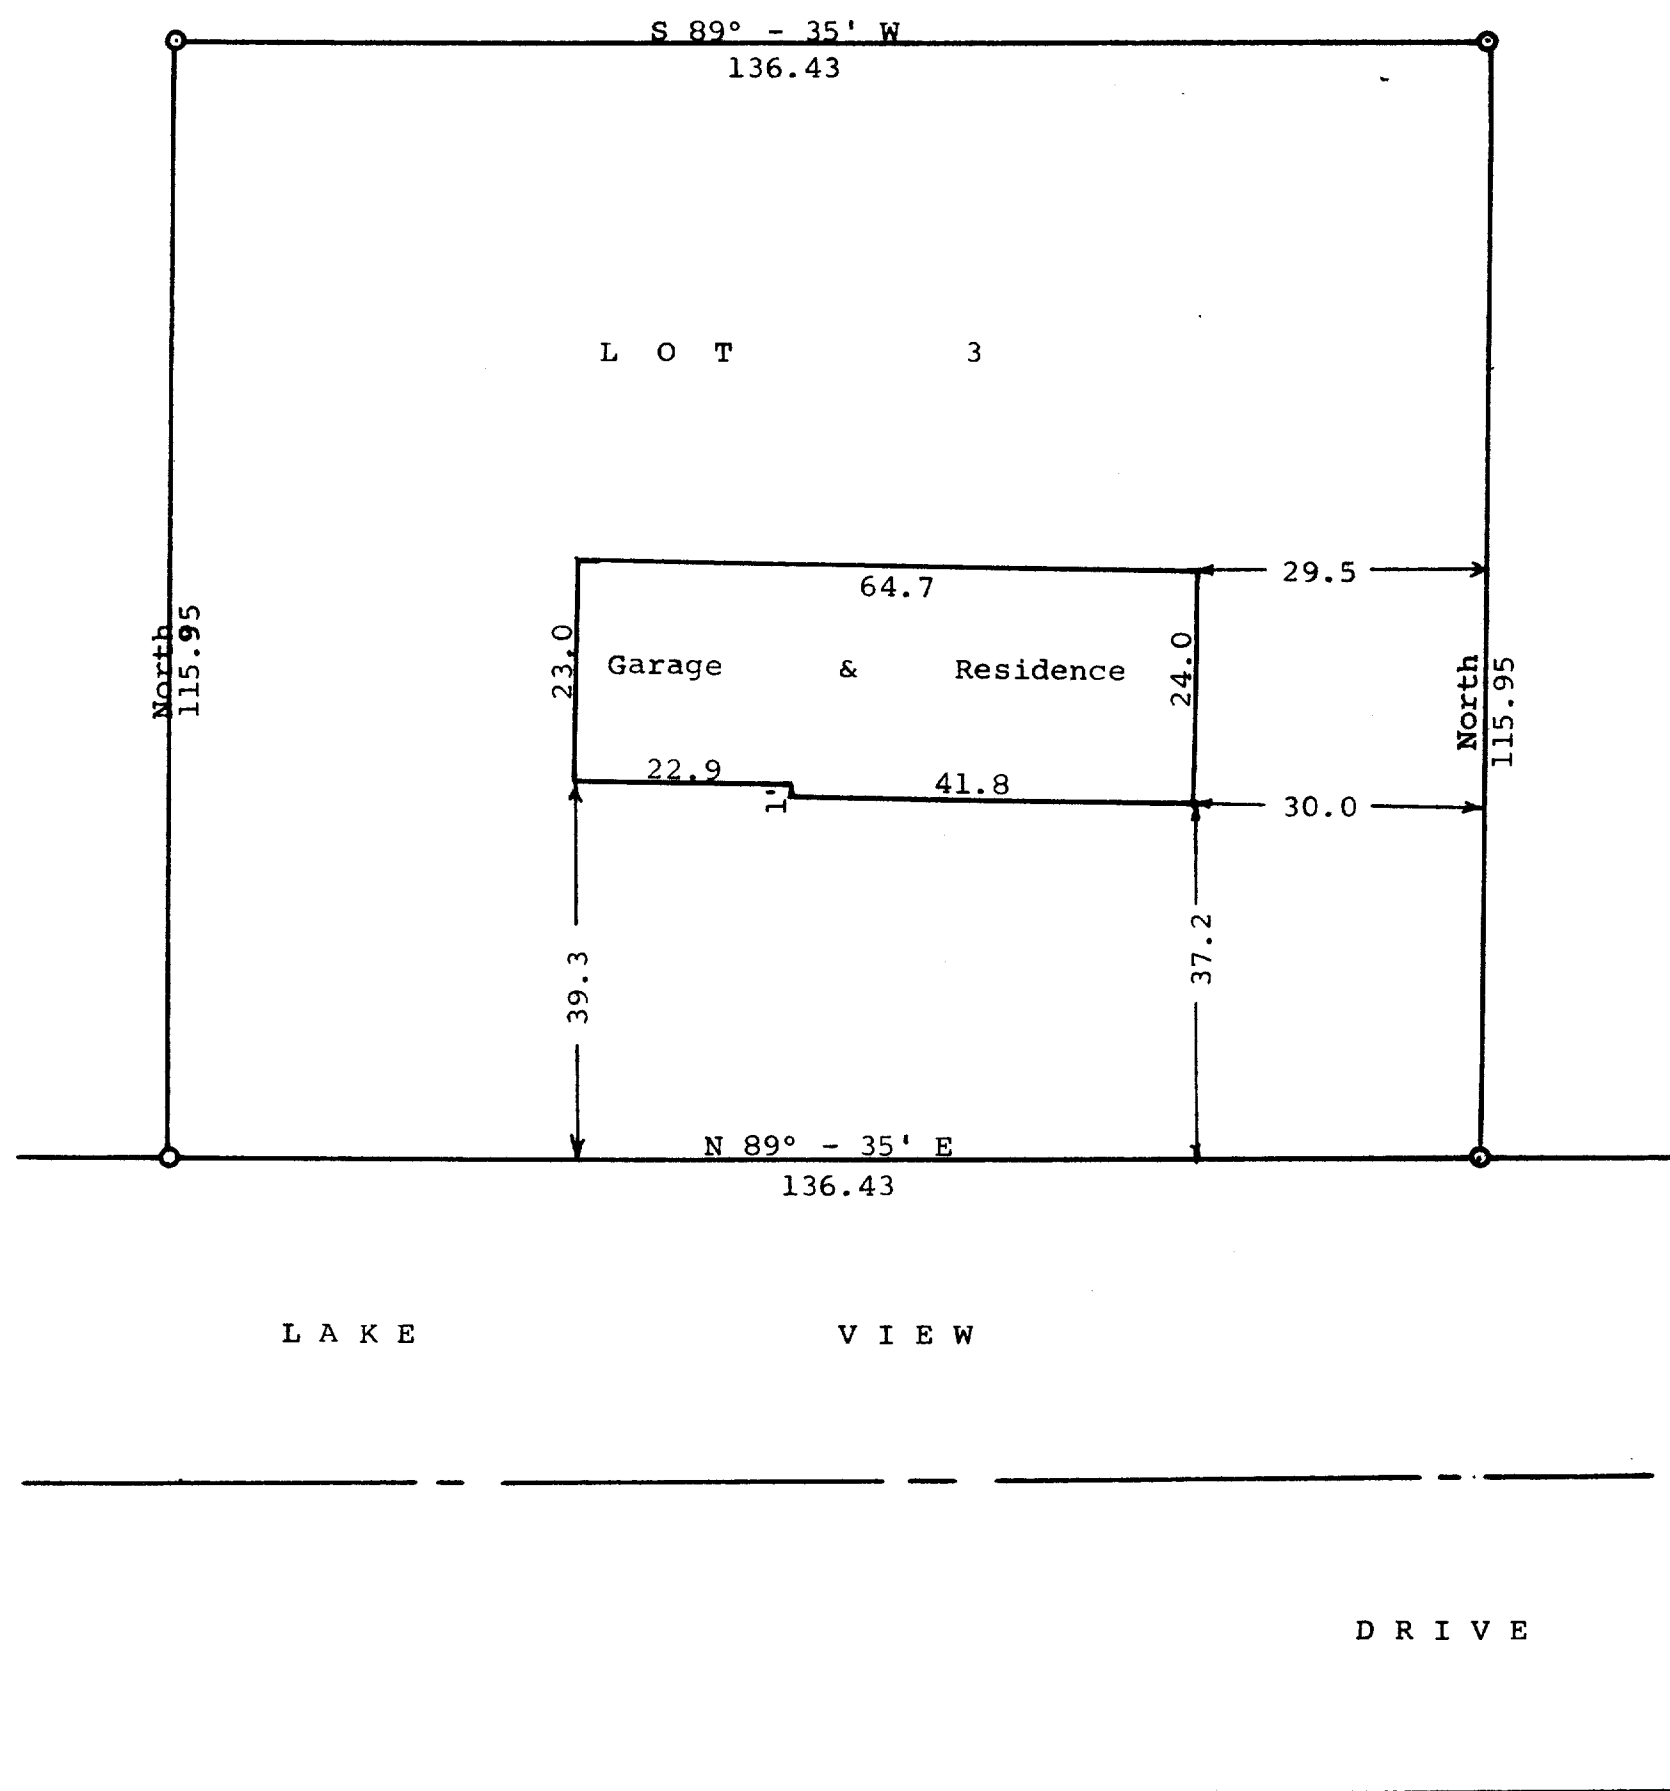

Scale - 1" = 20'
● = Iron Pipe

STATE OF WISCONSIN)
WALWORTH COUNTY)SS

I, George T. Dunham, surveyor, do certify that I have surveyed the property described as follows,

Lot 3 of Lake View Terrace, a subdivision located in Section 22, T 1 N R 16 E, Village of Walworth, Walworth County, Wisconsin.

and the above plat is an accurate survey and a true representation thereof and correctly shows the exterior boundary lines and location of the buildings and the correct measurements thereof.
October 6, 1964

George T. Dunham
George T. Dunham, Surveyor

9-36