


DUNHAM SURVEYING, S.C.
SURVEYING & SUBDIVIDING
DELAVER, WISCONSIN 53115


MAPLE

AVENUE

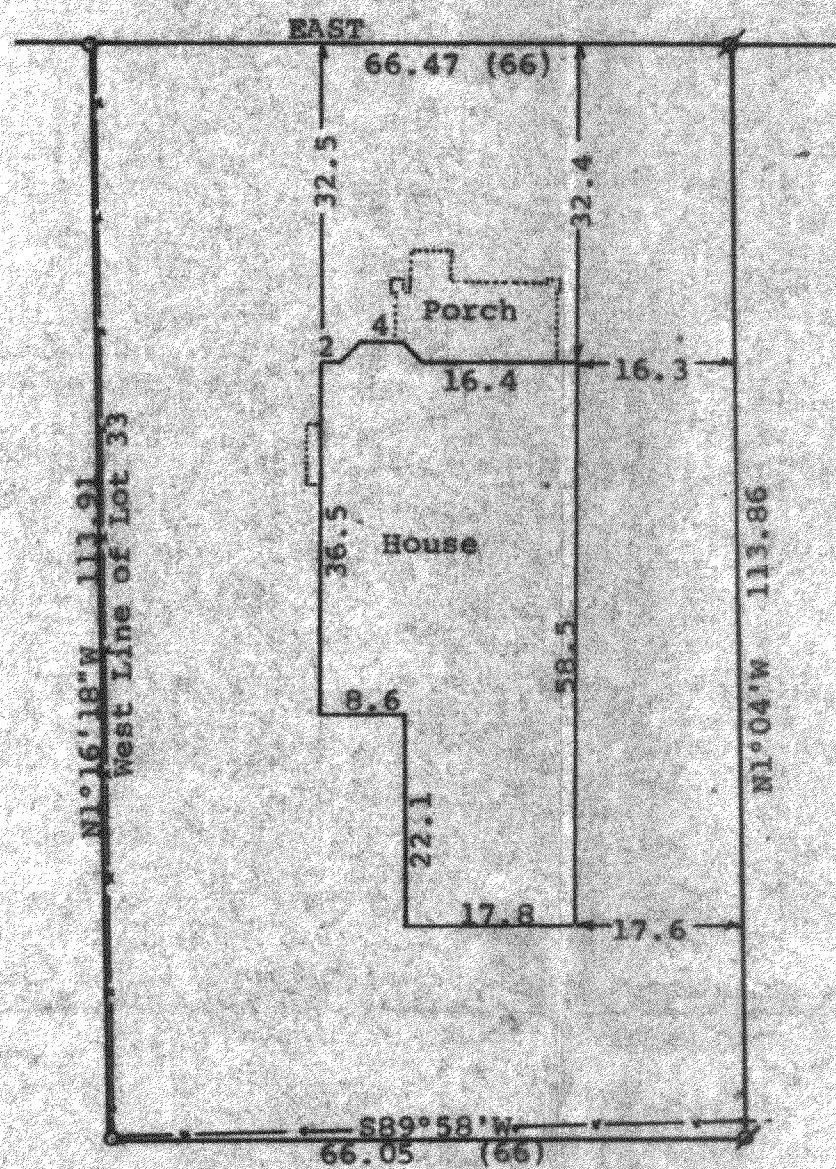

N

Scale - 1" = 20'
 ø = 1" Iron Pipe Found
 o = 3/4" Iron Pipe Found
 (0.00) = recorded distance
 — = Fence Line
 Bearings referenced to the assumed bearing of
 East along the south line of Maple Avenue
 Survey ordered by: Churchill Real Estate
 322 Park
 Walworth, WI 53184

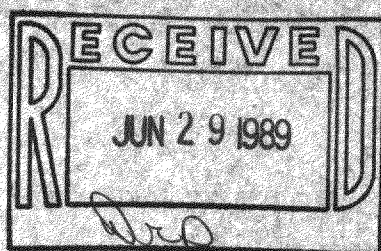

STATE OF WISCONSIN) SS
COUNTY OF WALWORTH)

I, George T. Dunham, Surveyor, certify that I have surveyed the property described as follows:

The West 66.00 feet of Lot 33, Clark's Addition to the Village of Walworth, Walworth County, Wisconsin,

and that the plat shown hereon is a correct representation thereof and shows the size and location of the property, its exterior boundaries, the location of all visible structures and dimensions of all principal buildings thereon, boundary fences, apparent easements, roadways and visible encroachments, if any, and that I have surveyed the property hereon described, according to the official records, to the best of my knowledge and belief.

December 6, 1988

George T. Dunham
George T. Dunham, Surveyor

