


GEORGE T. DUNHAM
SURVEYING & SUBDIVIDING
DELAVER, WISCONSIN

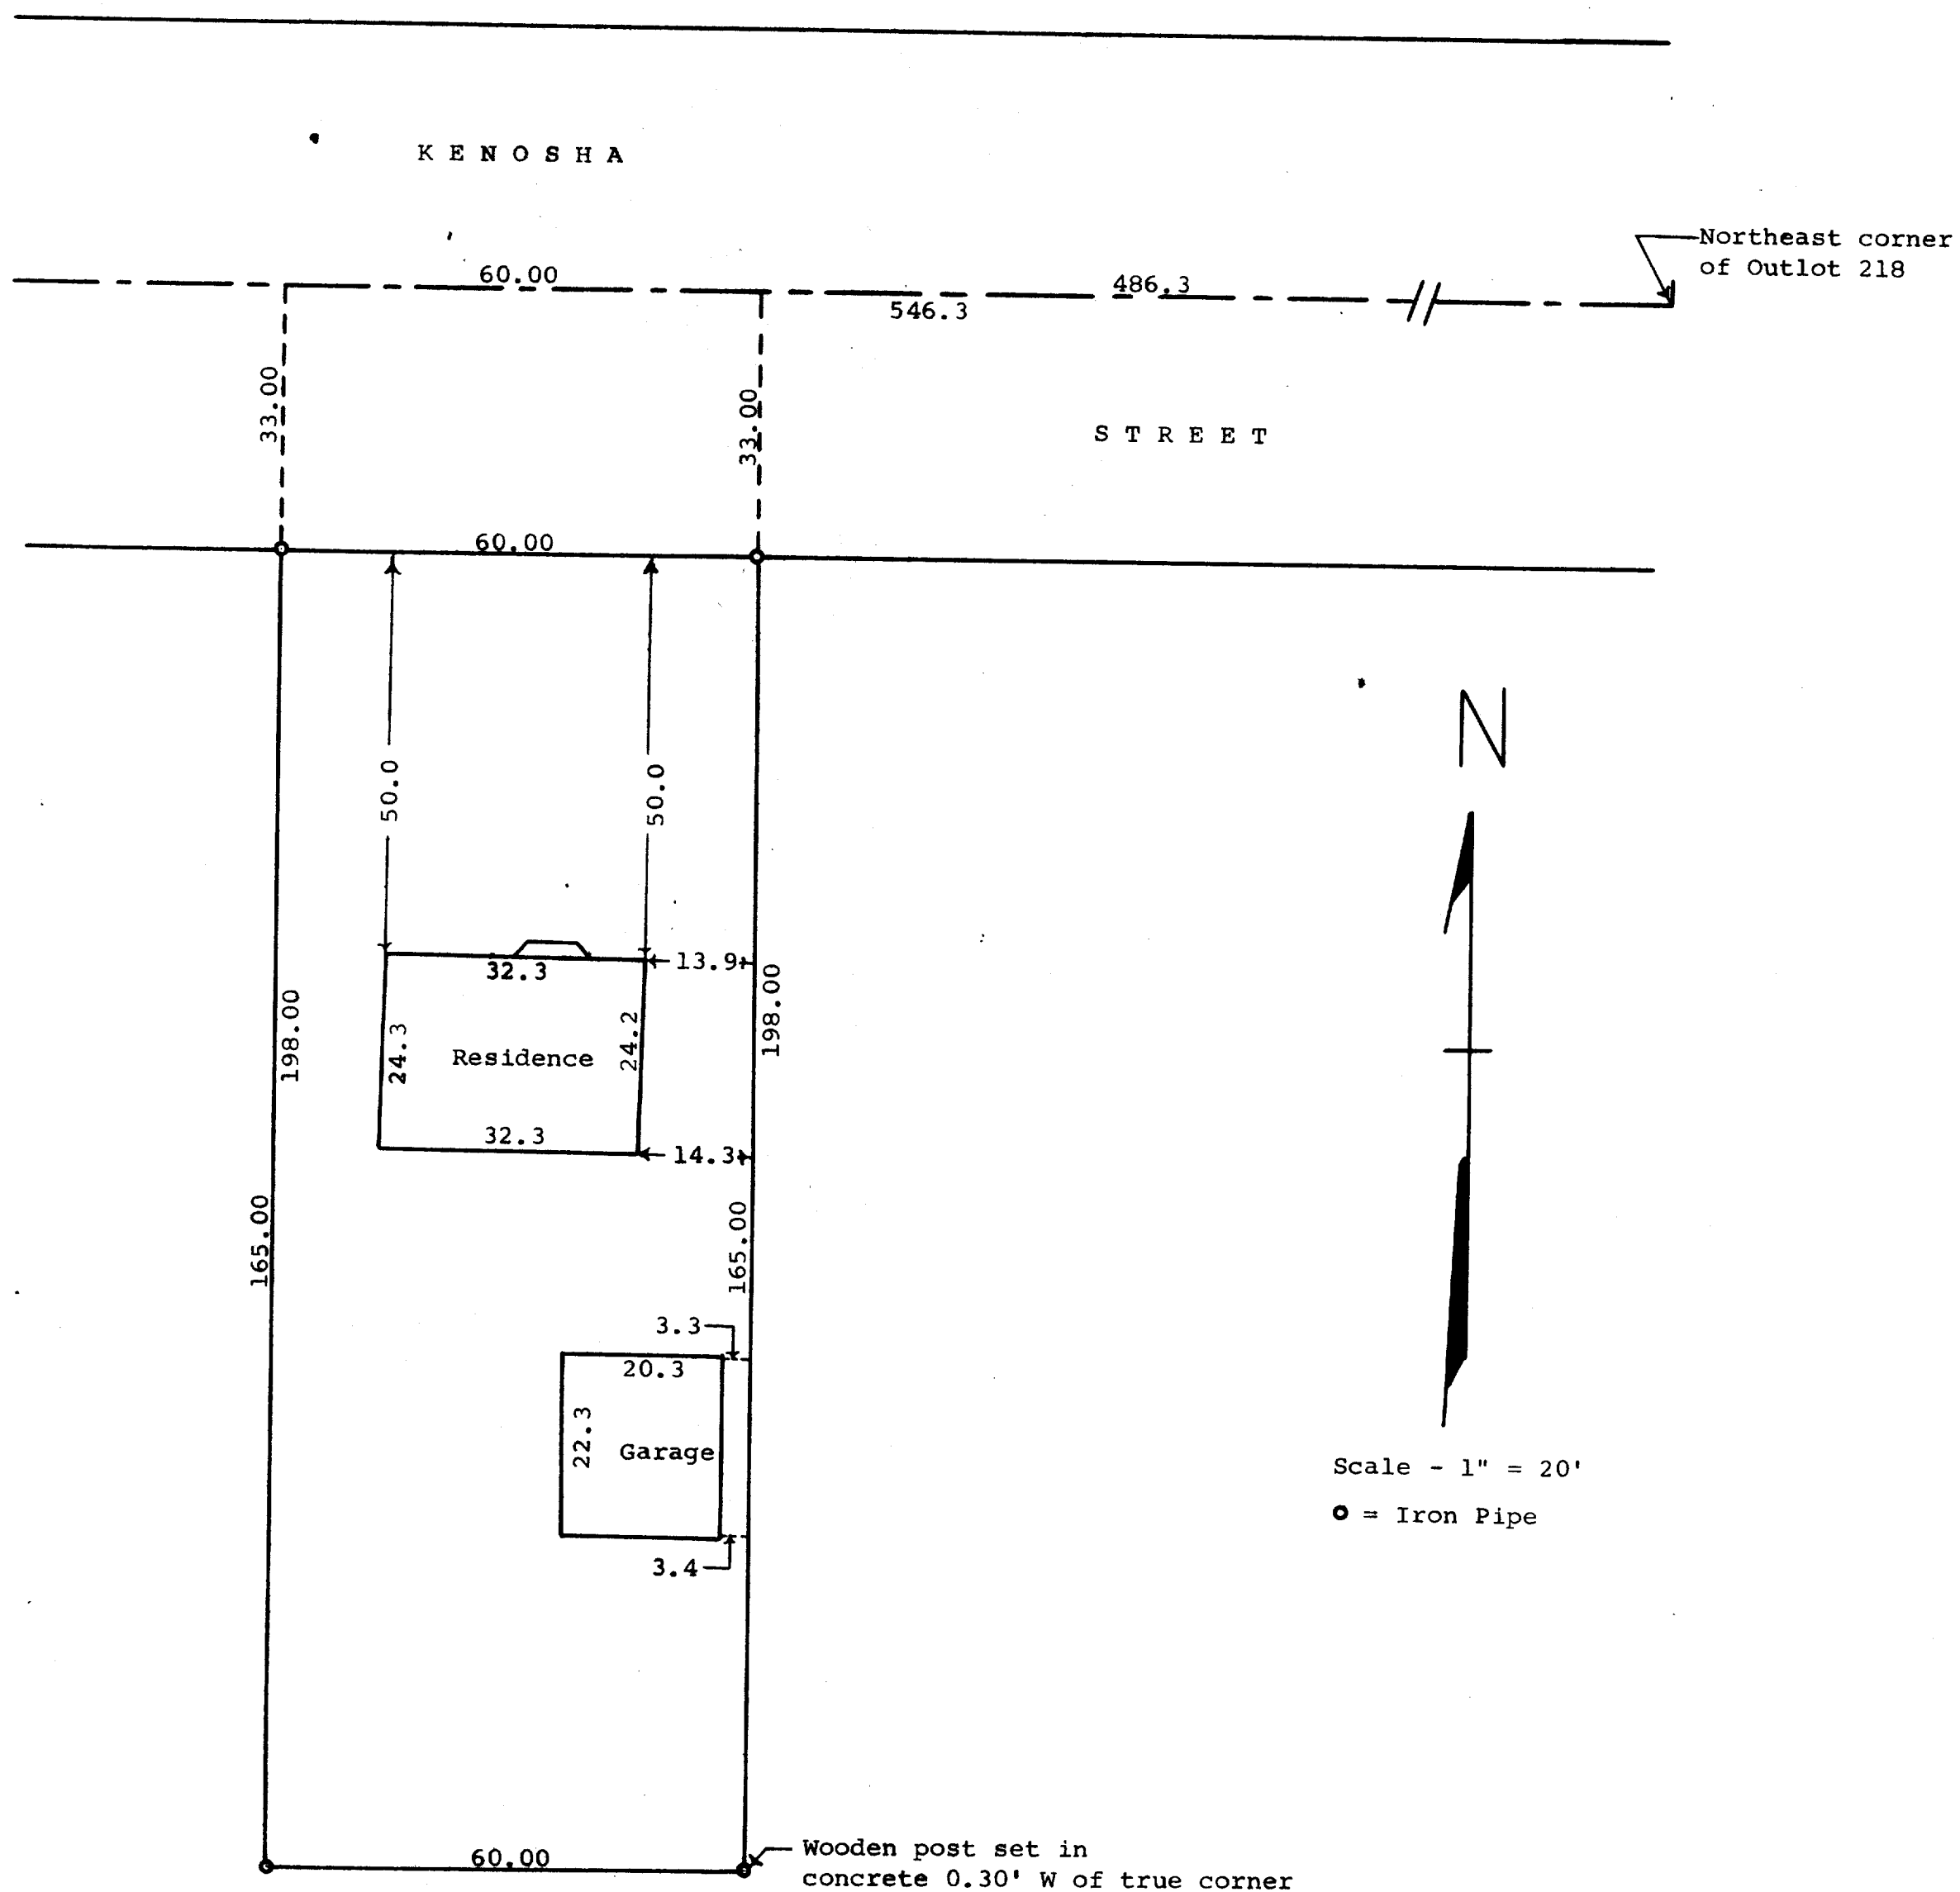

STATE OF WISCONSIN) SS
WALWORTH COUNTY)

I, George T. Dunham, surveyor, do certify that I have surveyed the property described as follows, the West 60 feet of the East 546.3 feet of the North 198 feet of Outlot 218, Assessor's Plat, Village of Walworth, Walworth County, Wisconsin as recorded in Volume 11 of Plats, Page 14, Register of Deeds Office, Elkhorn, Wisconsin and the above plat is an accurate survey and a true representation thereof and correctly shows the exterior boundary lines and location of buildings and the correct measurements thereof.
September 1, 1964

George T. Dunham
George T. Dunham, Surveyor