


DUNHAM SURVEYING, S.C.
SURVEYING & SUBDIVIDING
DELAVER, WISCONSIN 53115

N

Point located 33' south of the
centerline of Beloit Street and
of the NE Corner of Outlot 61

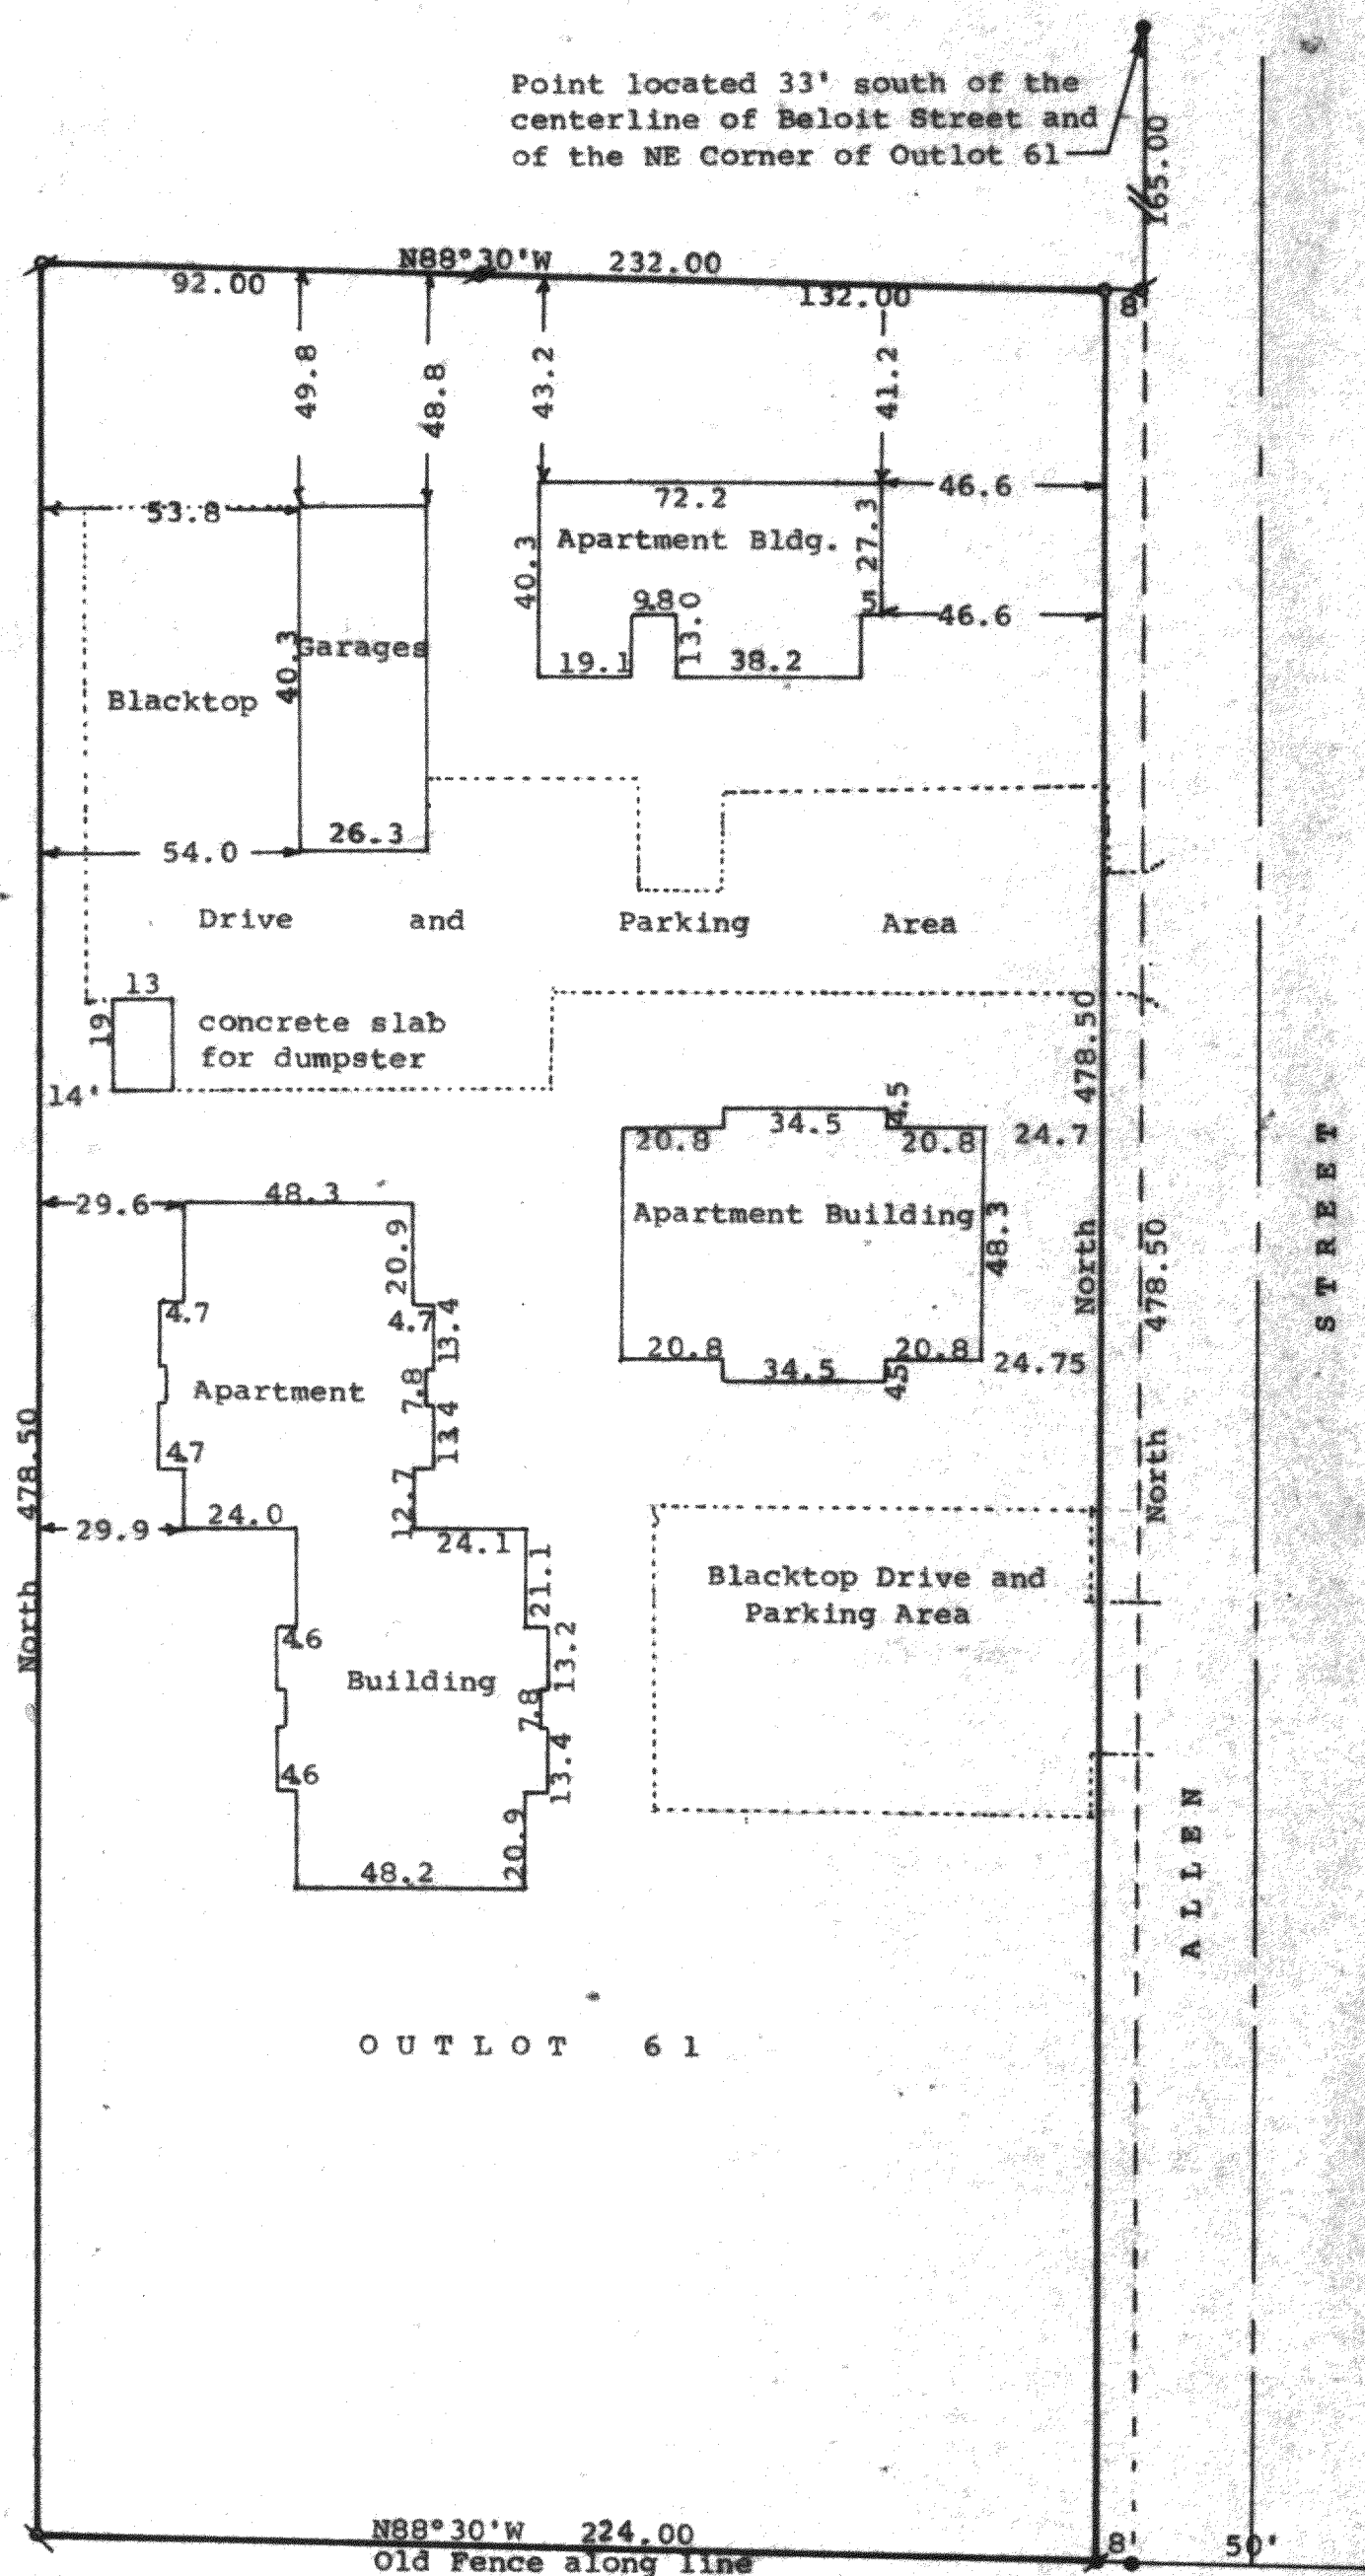

Scale 1" = 40'

- = Concrete Monument Found
- ⊥ = 1" Iron Pipe Found bent and reset
- = 1" Iron Pipe Set
- ⊥ = 1/2" X 24" Iron Pipe Set in base of 8" Box Elder Tree
- ⊥ = 3/4" Iron Pipe Found

Bearings referenced to the west line of Allen Street with the
assumed bearing of North

Owner: Village Commons Limited Partnership
697 South Blackhawk
Rockton, IL 60172

STATE OF WISCONSIN) SS
COUNTY OF WALWORTH)



I, George T. Dunham, Surveyor, certify that I have surveyed the
property described as follows:

Outlot No. 61 of the Assessor's Plat of the Village of Walworth,
Walworth County, Wisconsin, excepting therefrom the North
198.00 feet and also excepting therefrom the Easterly 8.00
feet to the southerly 478.50 feet thereof,

and that the plat shown hereon is a correct representation thereof and
shows the size and location of the property, its exterior boundaries, the
location of all visible structures and dimensions of all principal
buildings thereon, boundary fences, apparent easements, roadways and
visible encroachments, if any, and that I have surveyed the property
hereon described, according to the official records, to the best of my
knowledge and belief.

August 29, 1989

George T. Dunham
George T. Dunham, Surveyor

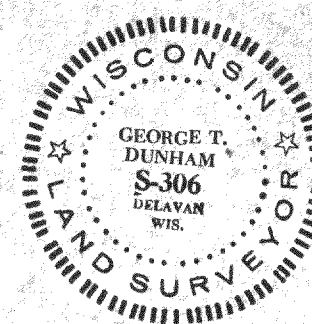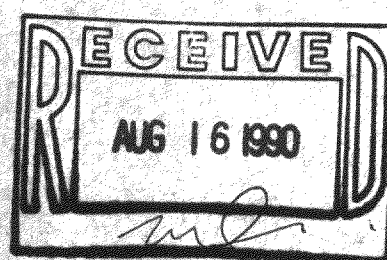

Tax Key # JWP 00071

Survey # 9-383