


DUNHAM SURVEYING, S.C.
SURVEYING & SUBDIVIDING
DELAVAN, WISCONSIN 53115

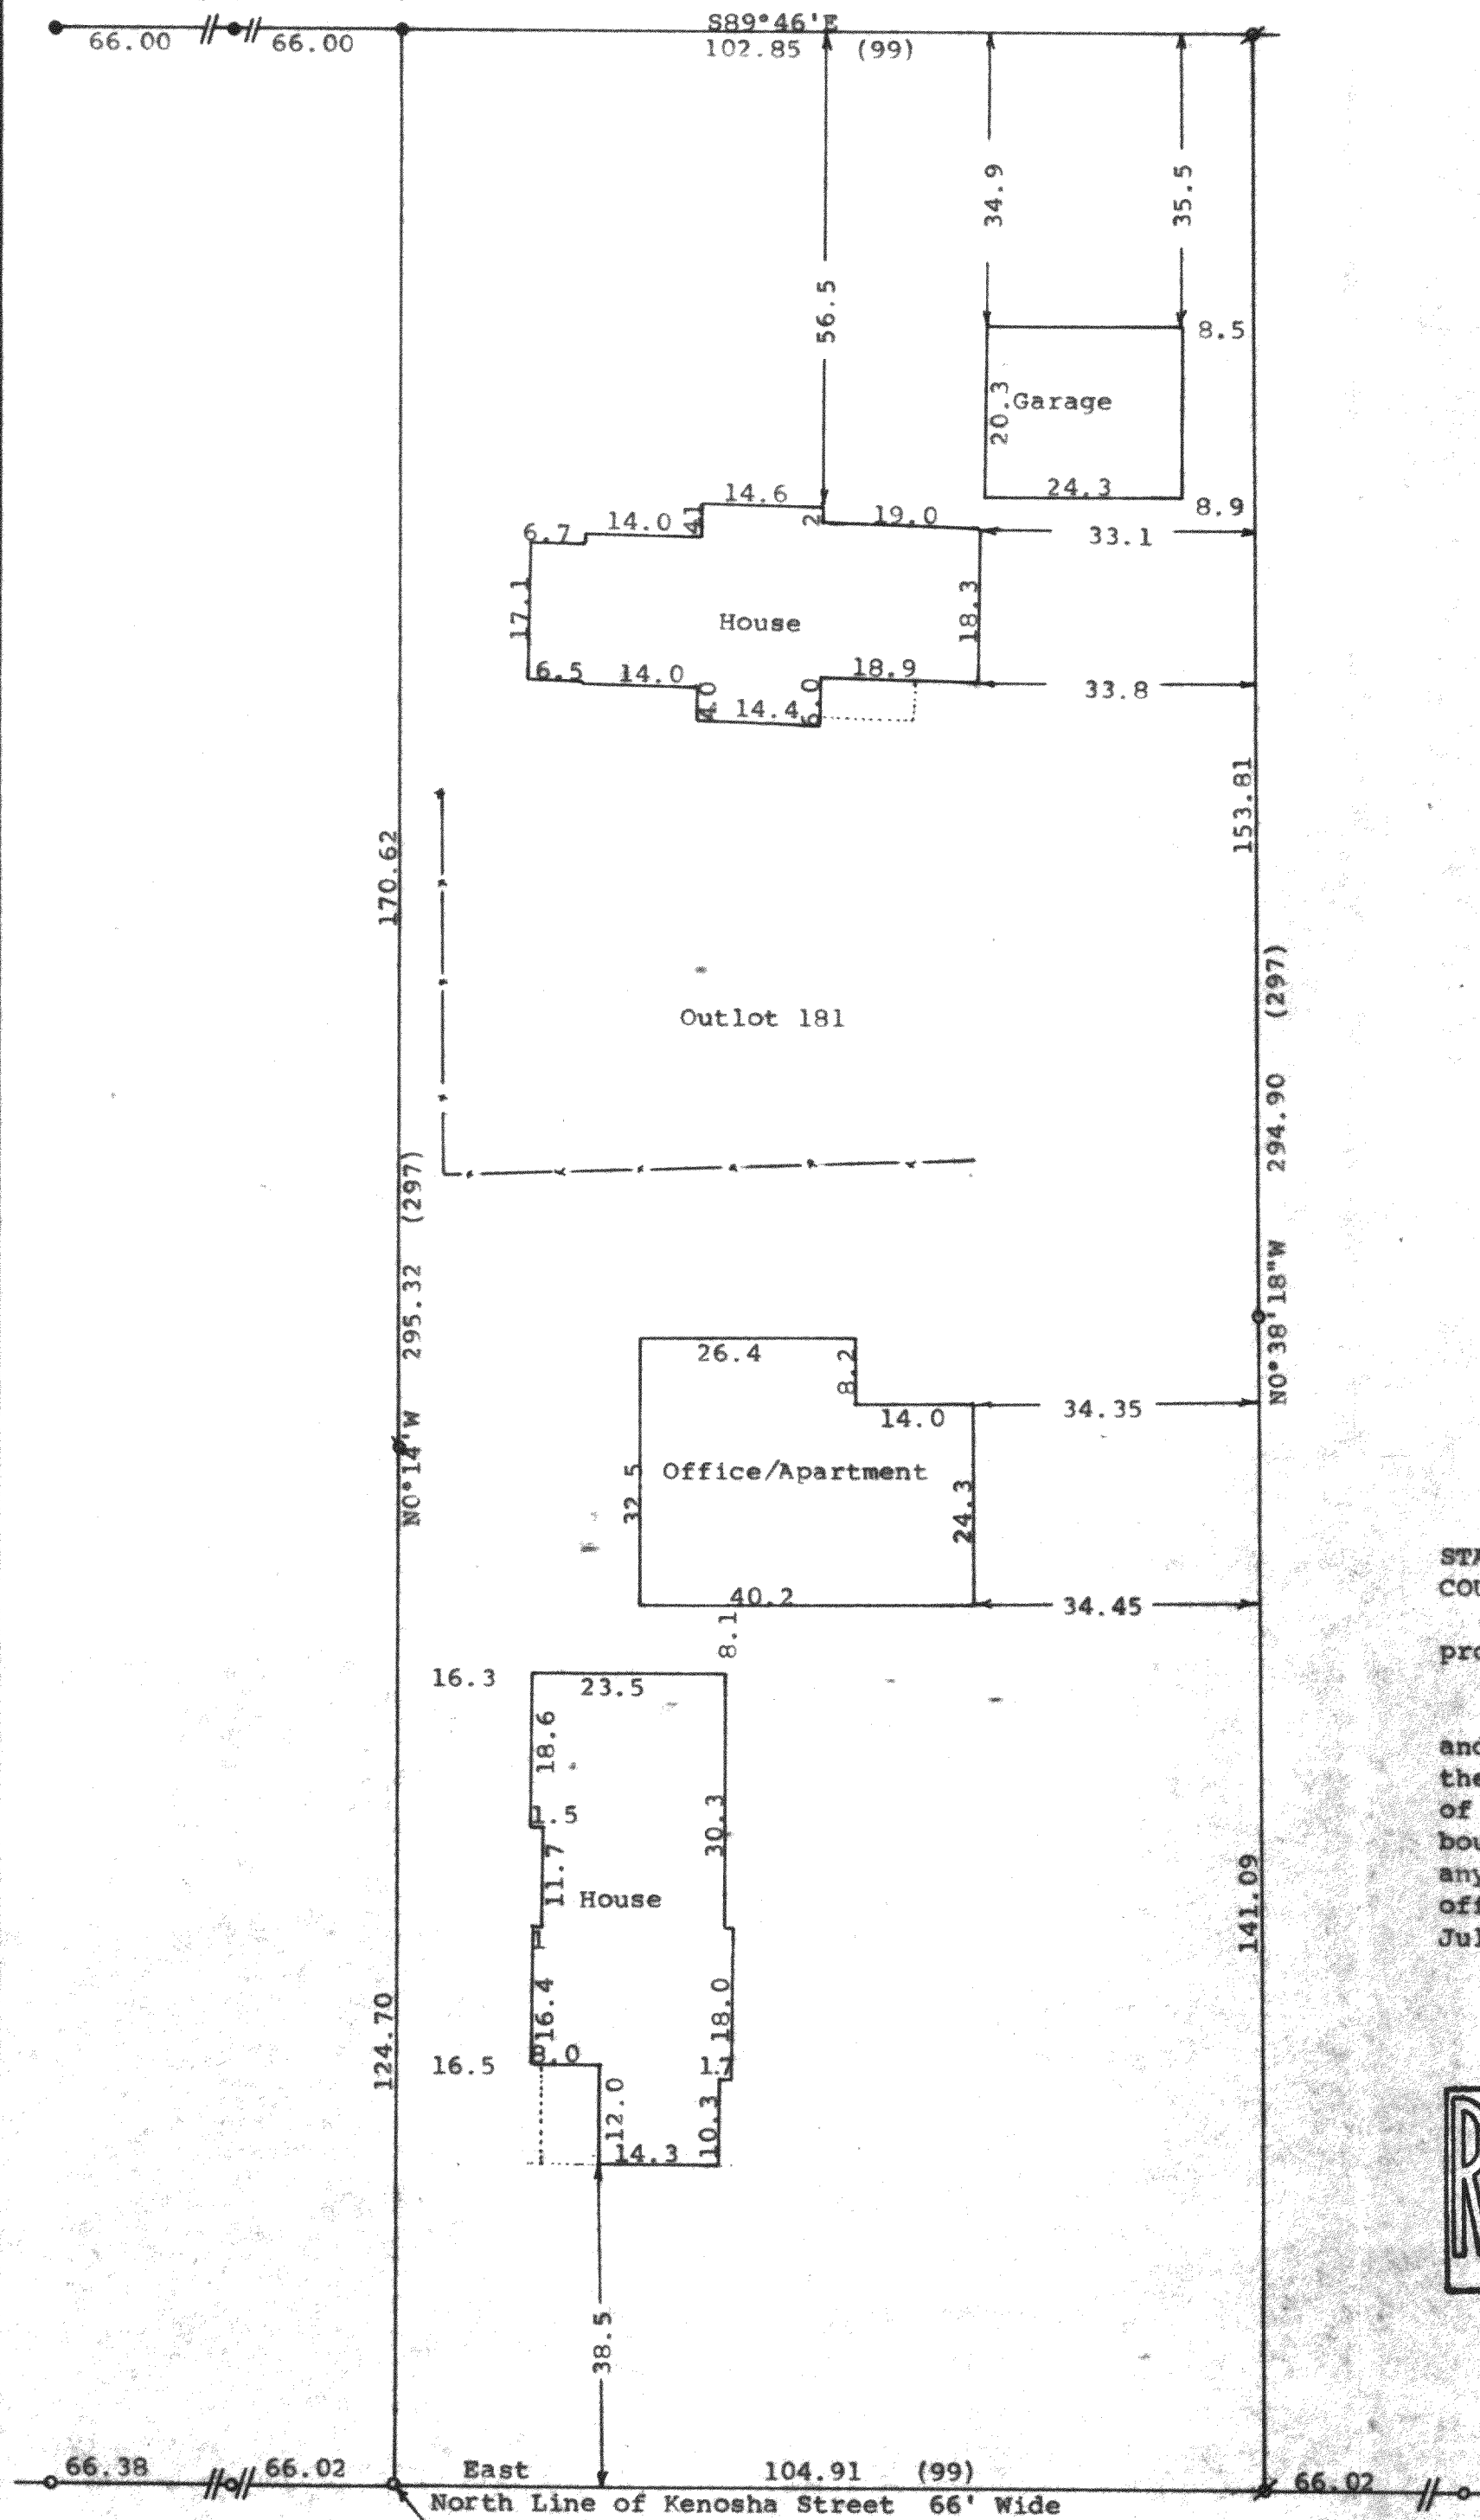

Scale - 1" = 20'

- = 1 1/2" Iron Pipe Found
- ⦿ = 3/4" Iron Pipe Found
- ⊗ = 1/2" X 24" Iron Pipe Set
- = Iron Pipe Found & size not noted
- = Fence Line

(0.00) = recorded distance

Bearings referenced to the assumed bearing of East along the north line of Kenosha Street

Survey ordered by+

Don Nichols

Walworth, WI 53184

(0.00) = recorded distance

STATE OF WISCONSIN) SS
COUNTY OF WALWORTH)



I, George T. Dunham, Surveyor, certify that I have surveyed the property described as follows:

Outlot No. 181 of the Assessors Plat of the Village of Walworth, Walworth County, Wisconsin,

and that the plat shown hereon is a correct representation thereof and shows the size and location of the property, its exterior boundaries, the location of all visible structures and dimensions of all principal buildings thereon, boundary fences, apparent easements, roadways and visible encroachments, if any, and that I have surveyed the property hereon described, according to the official records, to the best of my knowledge and belief.

July 12, 1990

George T. Dunham
George T. Dunham, Surveyor

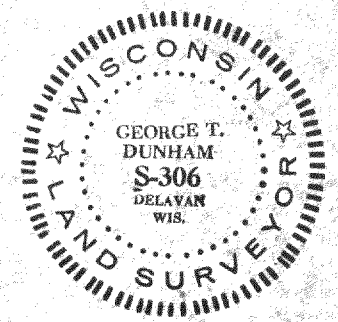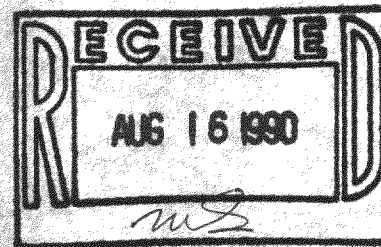

TAX KEY # VWP 00211

SURVEY # 9-386