


DUNHAM SURVEYING, S.C.
SURVEYING & SUBDIVIDING
DELAVER, WISCONSIN 53115

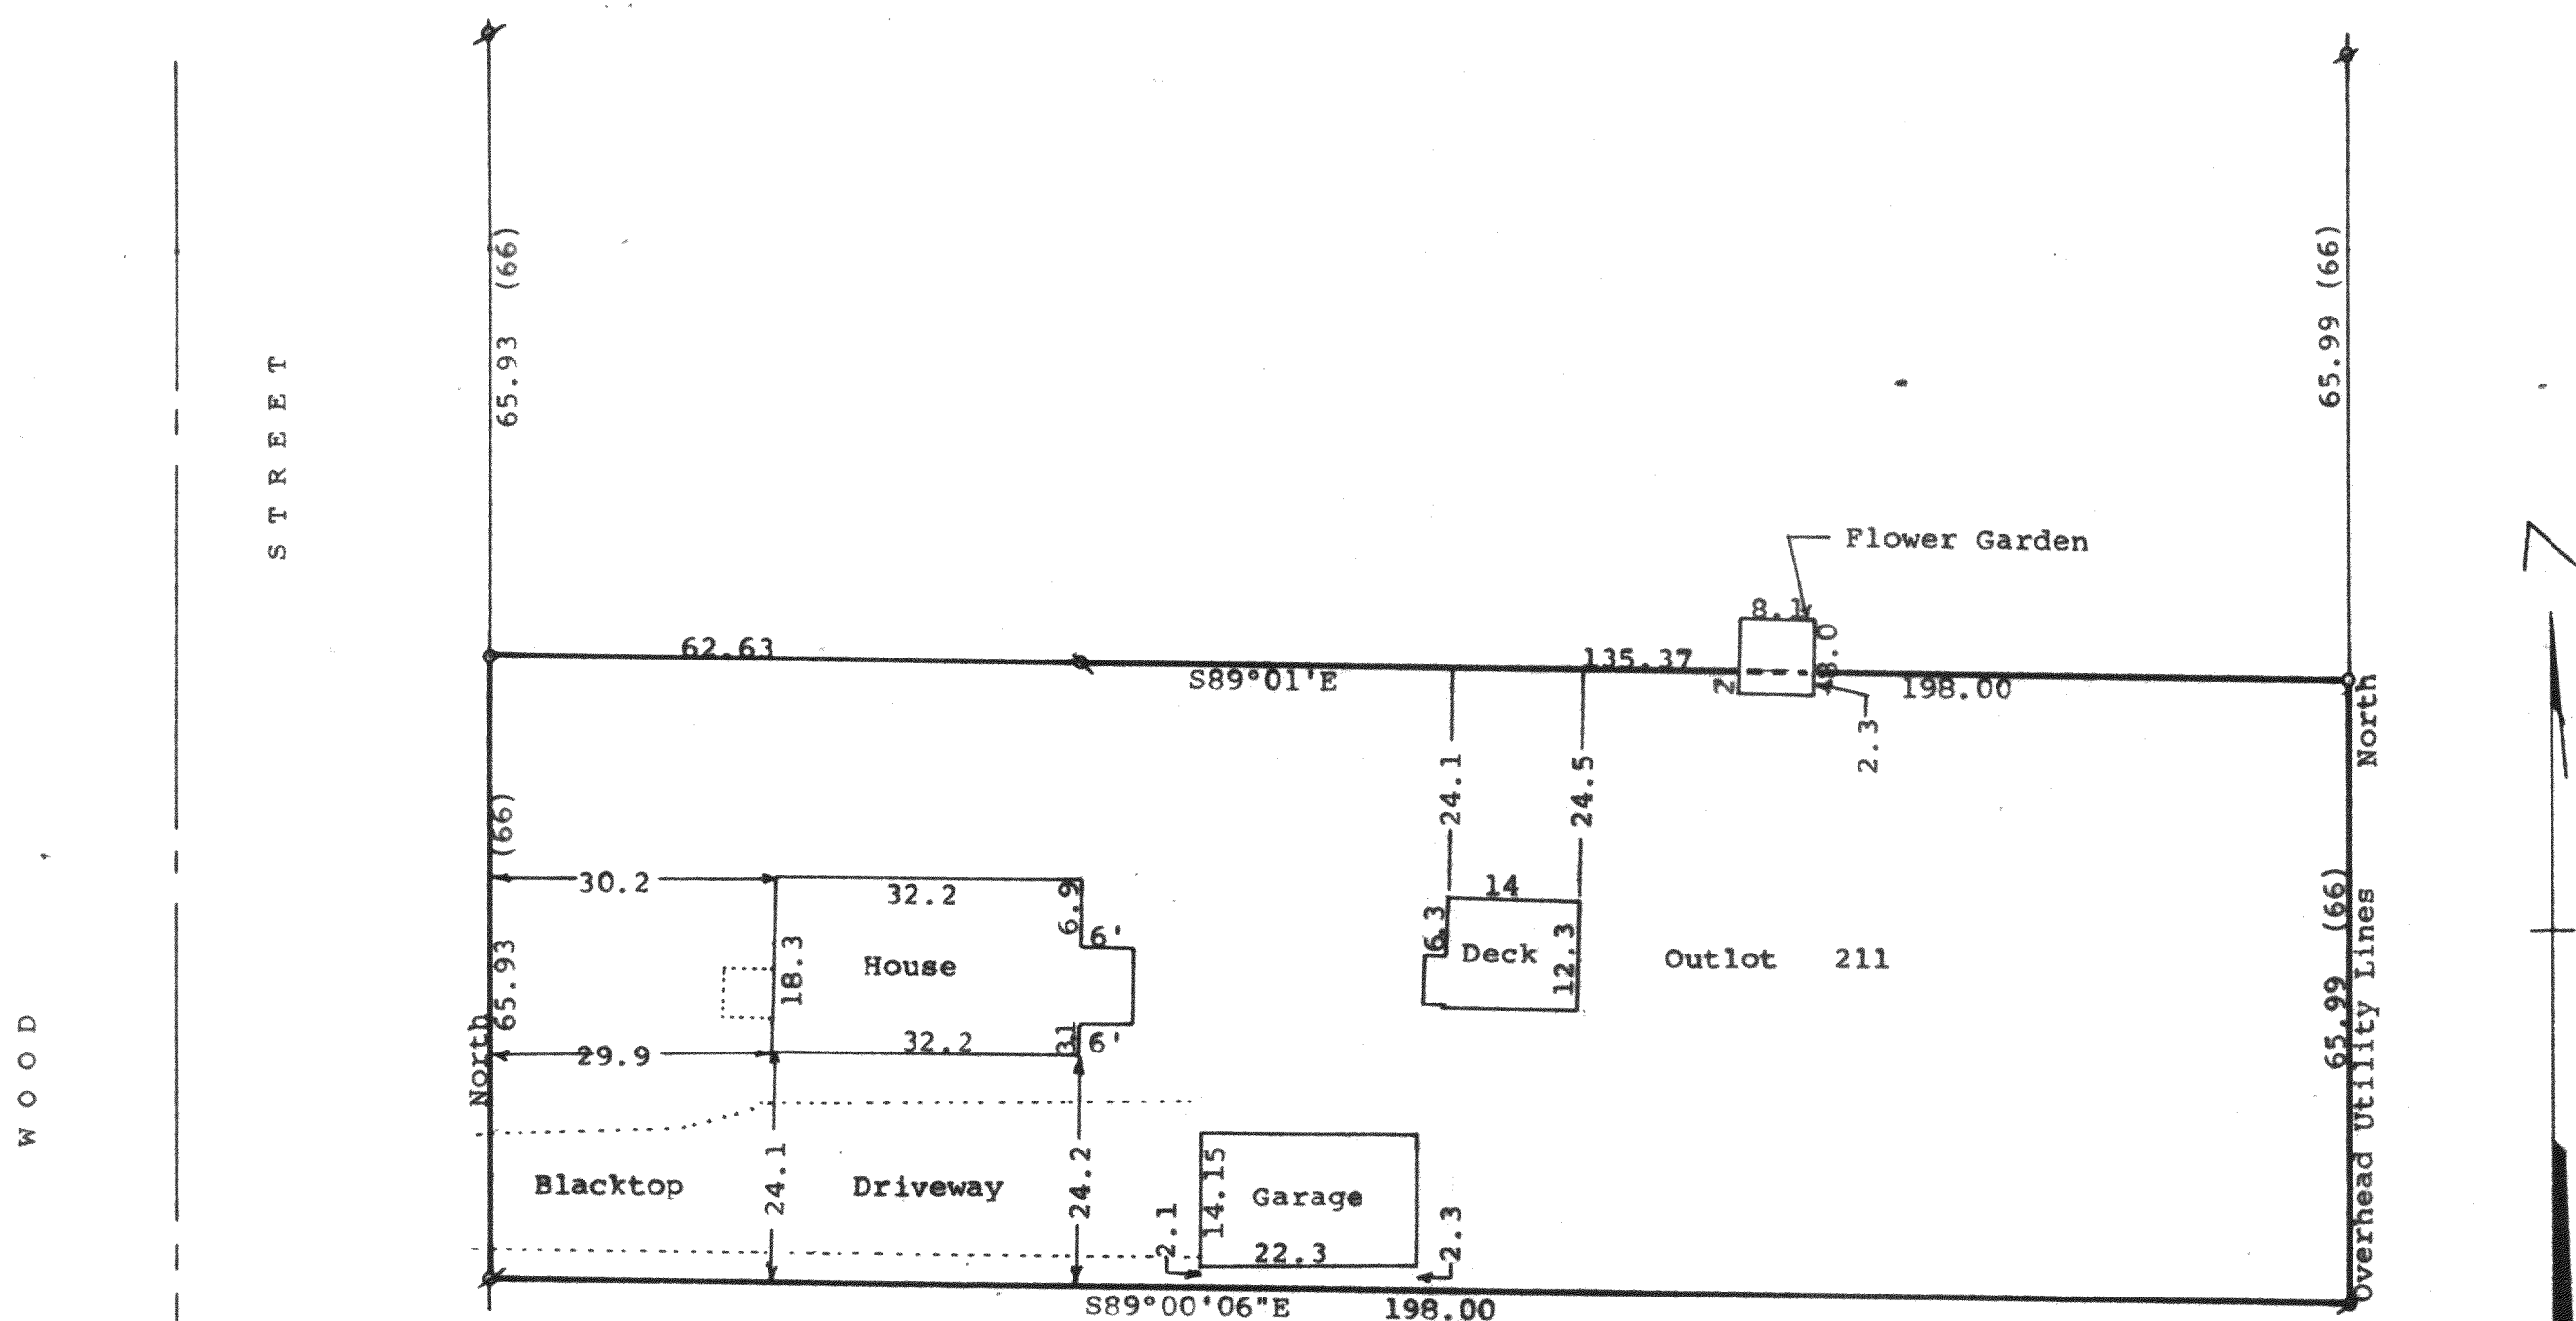



Scale - 1" = 20'
 ⌀ = 3/4" Iron Pipe Found
 ⌀ = 1/2" X 24" Iron Pipe Set
 ○ = 1" X 24" Iron Pipe Set
 (0.00) = recorded distance
 Bearings referenced to the assumed bearing of North along the east line of Wood Street
 Survey ordered by:
 Churchill Real Estate
 322 Park Street
 Walworth, WI 53184

STATE OF WISCONSIN) SS
 COUNTY OF WALWORTH)

I, George T. Dunham, Surveyor, certify that I have surveyed the property described as follows:

Outlot 211 of the Assessor's Plat of the Village of Walworth, Walworth County, Wisconsin, and that the plat shown hereon is a correct representation thereof and shows the size and location of the property, its exterior boundaries, the location of all visible structures and dimensions of all principal buildings thereon, boundary fences, apparent easements, roadways and visible encroachments, if any, and that I have surveyed the property described hereon, according to the official records, to the best of my knowledge and belief.
 August 14, 1989

George T. Dunham
 George T. Dunham, Surveyor

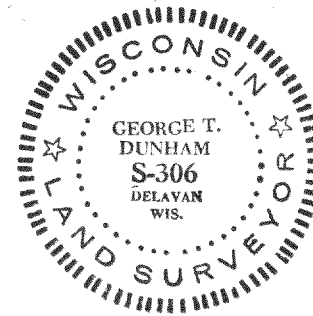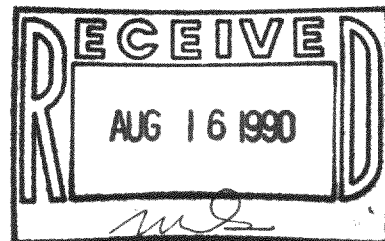

TAX KEY # VWP 00276

SURVEY # 9-387