


DUNHAM SURVEYING, S.C.
SURVEYING & SUBDIVIDING
DELAVER, WISCONSIN 53115

F I F T H

S T R E E T

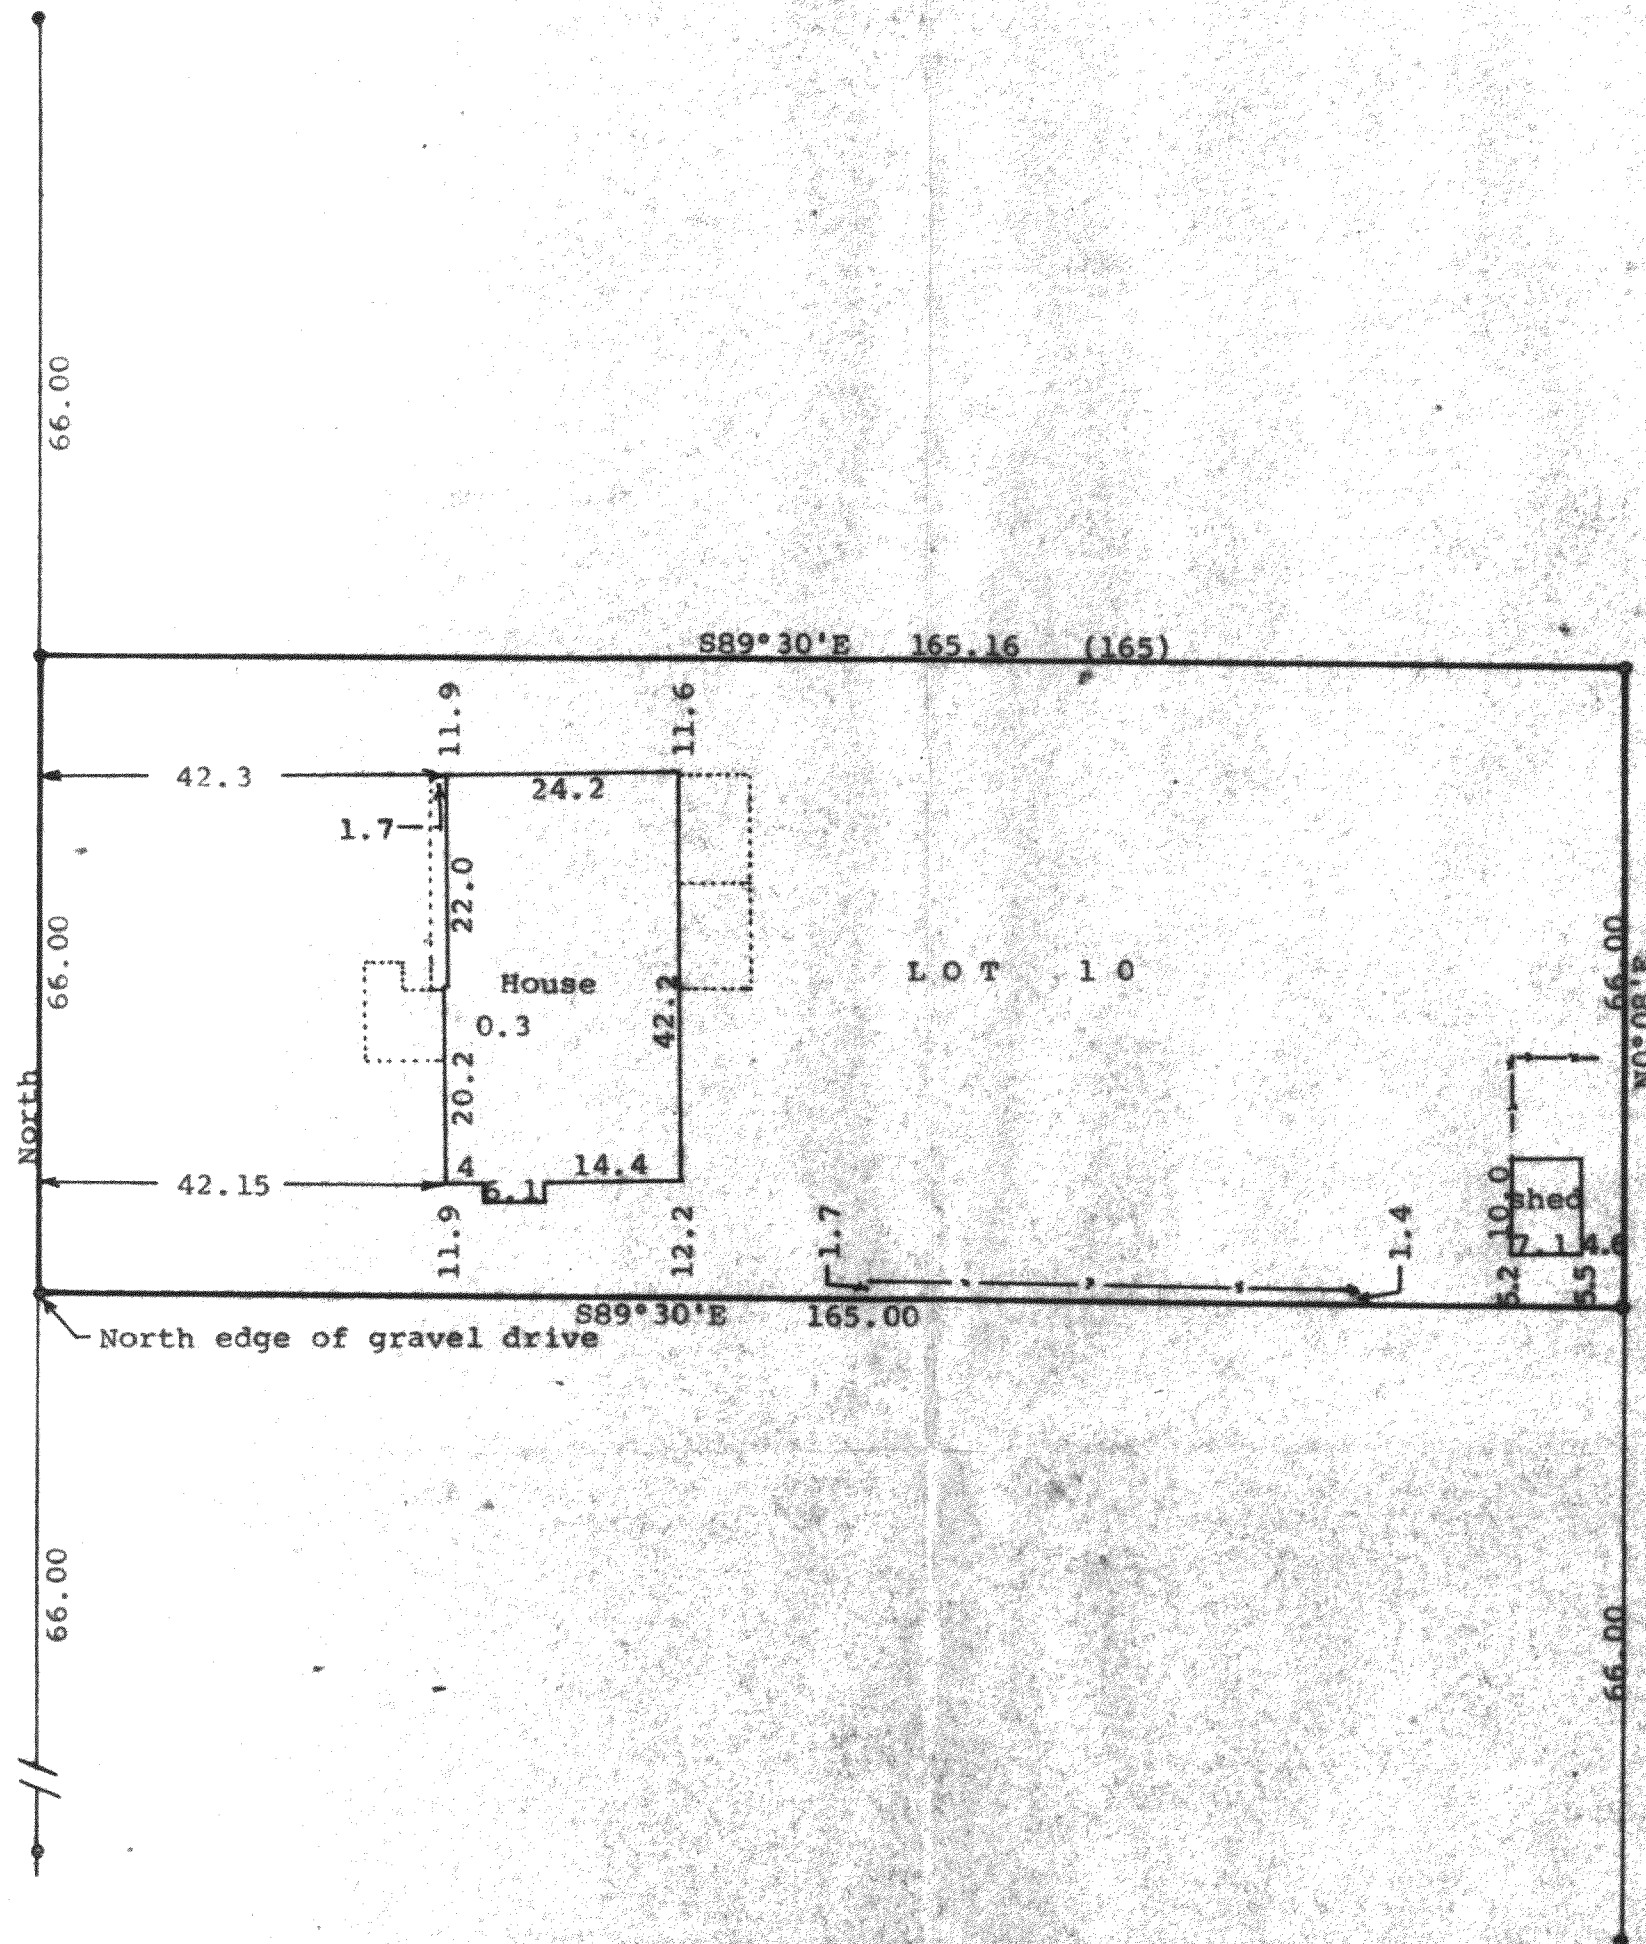

N

Scale - 1" = 20'
o = 3/4" Iron Pipe Found
• = 1" Iron Pipe Found
--- = Fence Line
Bearings referenced to the east line of Fifth Street with the assumed bearing of North
Survey ordered by:
Churchill Real Estate
322 Park
Walworth, WI 53184
(0.00) = recorded distance

STATE OF WISCONSIN) ss
COUNTY OF WALWORTH)



I, George T. Dunham, Surveyor, certify that I have surveyed the property described as follows:

Lot 10 in Block 1 of E. W. Crumbs Addition to the Village of Walworth, Walworth County, Wisconsin,

and that the plat shown hereon is a correct representation thereof and shows the size and location of the property, its exterior boundaries, the location of all visible structures and dimensions of all principal buildings thereon, boundary fences, apparent easements, roadways and visible encroachments, if any and that I have surveyed the property hereon described, according to the official records, to the best of my knowledge and belief.

April 24, 1990

George T. Dunham
George T. Dunham, Surveyor

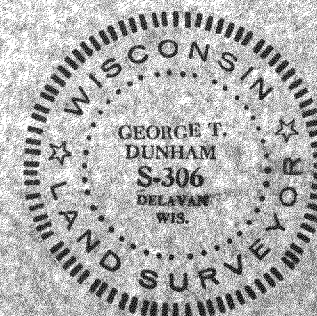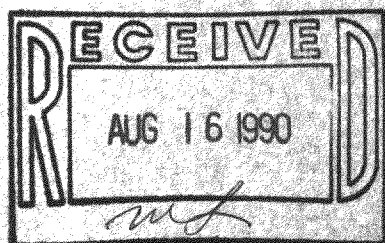

TAX KEY # VECR-00007

Survey # 9-388