


GEORGE T. DUNHAM
SURVEYING & SUBDIVIDING
DELAVER, WISCONSIN

N

Scale - 1" = 20'

○ = Iron Pipe

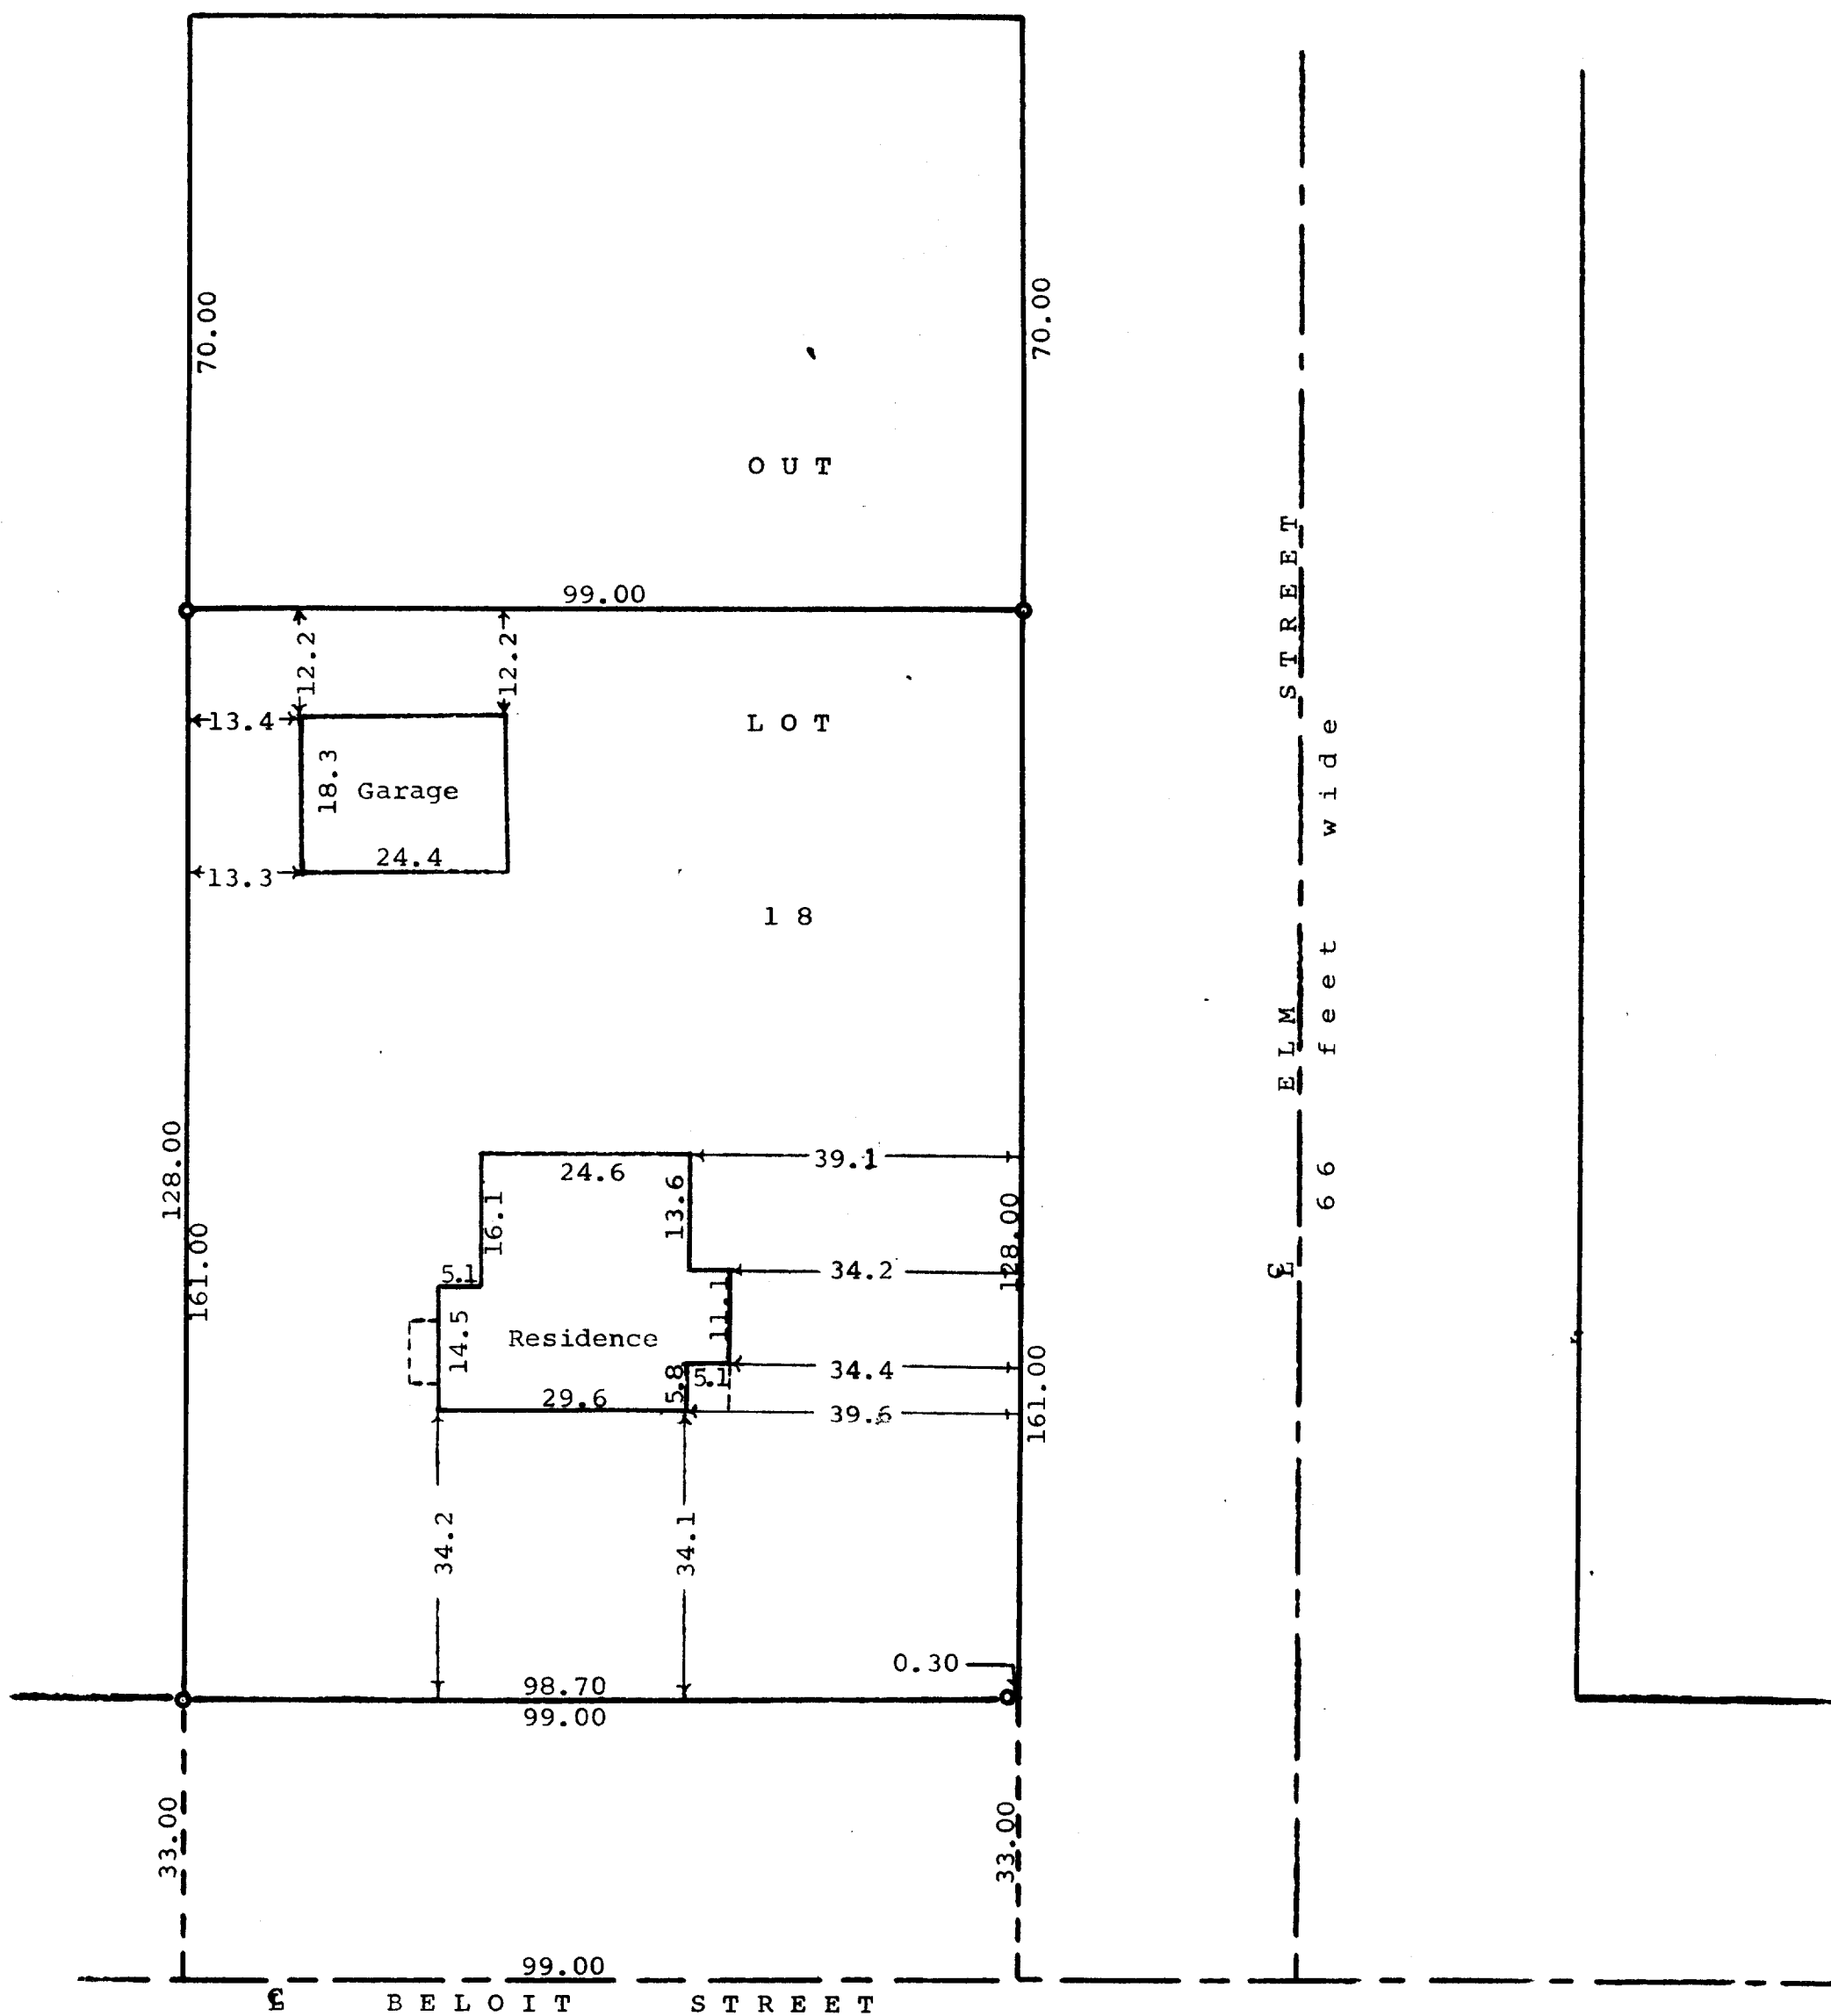

STATE OF WISCONSIN) ss
WALWORTH COUNTY)

I, George T. Dunham, surveyor, do certify that I have surveyed the property described as follows,
Outlot 18 of the Assessor's Plat in the Village of Walworth, Walworth County, Wisconsin, EXCEPTING the North 70.00 feet thereof as recorded in Volume 11 of Plats, Page 14, Register of Deeds Office, Elkhorn, Wisconsin and the above plat is an accurate survey and a true representation thereof and correctly shows the exterior boundary lines and location of buildings and the correct measurements thereof.
September 1, 1964

George T. Dunham
George T. Dunham, Surveyor