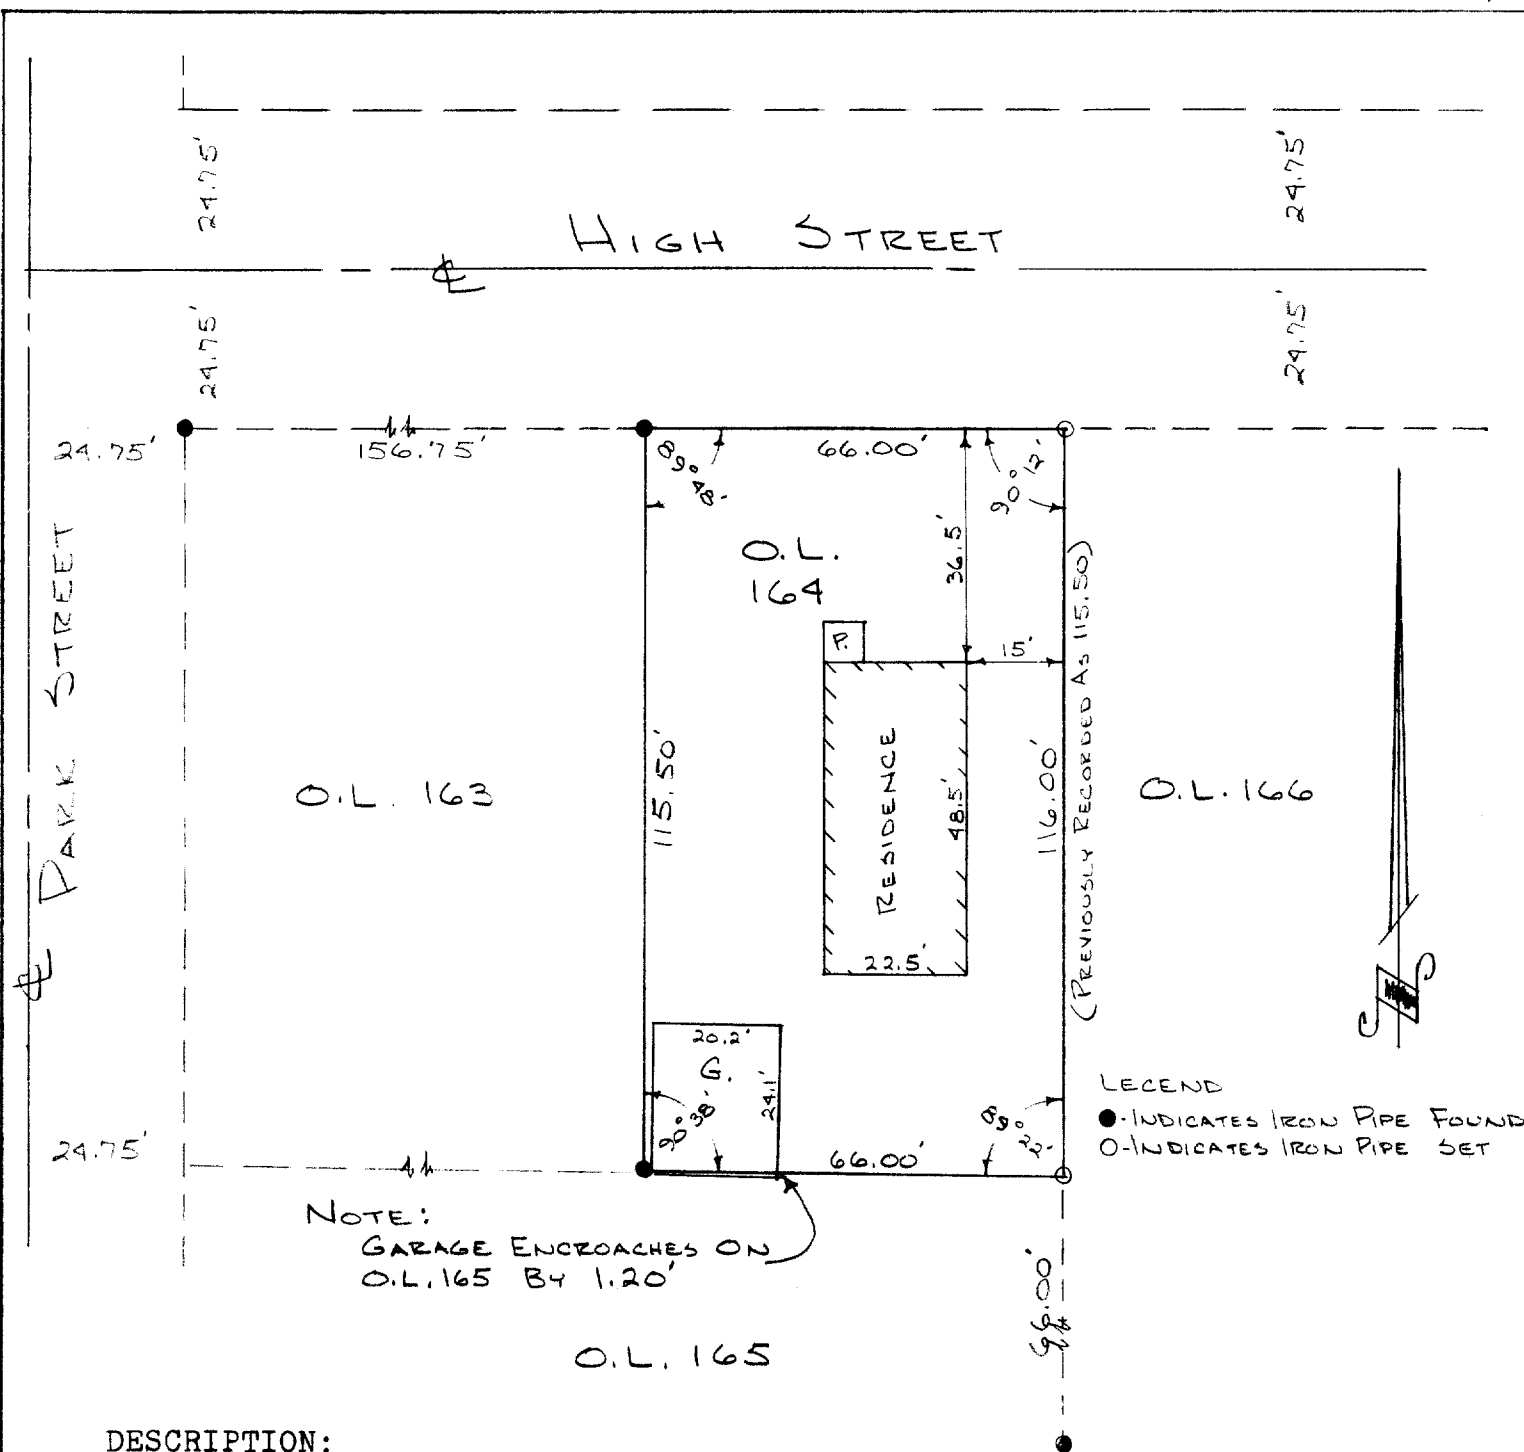


120/72

9-3B

DESCRIPTION:

Out Lot 164 of Assessors Plat, Village of Walworth, Walworth County, Wisconsin.

CERTIFICATE:

I, James F. Biagi, surveyor, do hereby certify that I have surveyed the lands hereon described.

September 27, 1972

James F. Biagi RLS #272



VWP 181

9-3B