


Wisconsin Registered Land Surveyor S-1594

Rt. 3, Box 273
Elkhorn, Wisconsin 53121
Phone: (414) 723-4260 (office)
(414) 723-4813 (residence)

ORDERED BY: WAUWATOSA REALTY
P.O. BOX 215
FONTANA, WI. 53105

LOT 4 OF CERTIFIED SURVEY MAP NO.
1896 AS RECORDED IN VOL. 9 OF
CERTIFIED SURVEY MAPS AS PAGES 81
- 84 AS DOCUMENT NO. 187485 AND
LOCATED IN THE SOUTHEAST 1/4 OF
THE SOUTHEAST 1/4 OF SECTION 22,
TOWN 1 NORTH, RANGE 16 EAST,
VILLAGE OF WALWORTH, WALWORTH
COUNTY, WISCONSIN.

CURVE	ARC	DELTA	RADIUS	CHORD LENGTH	CHORD BEARING
C1	124.09	3°59'05"	1784.17	124.06	S 87°47'33" E

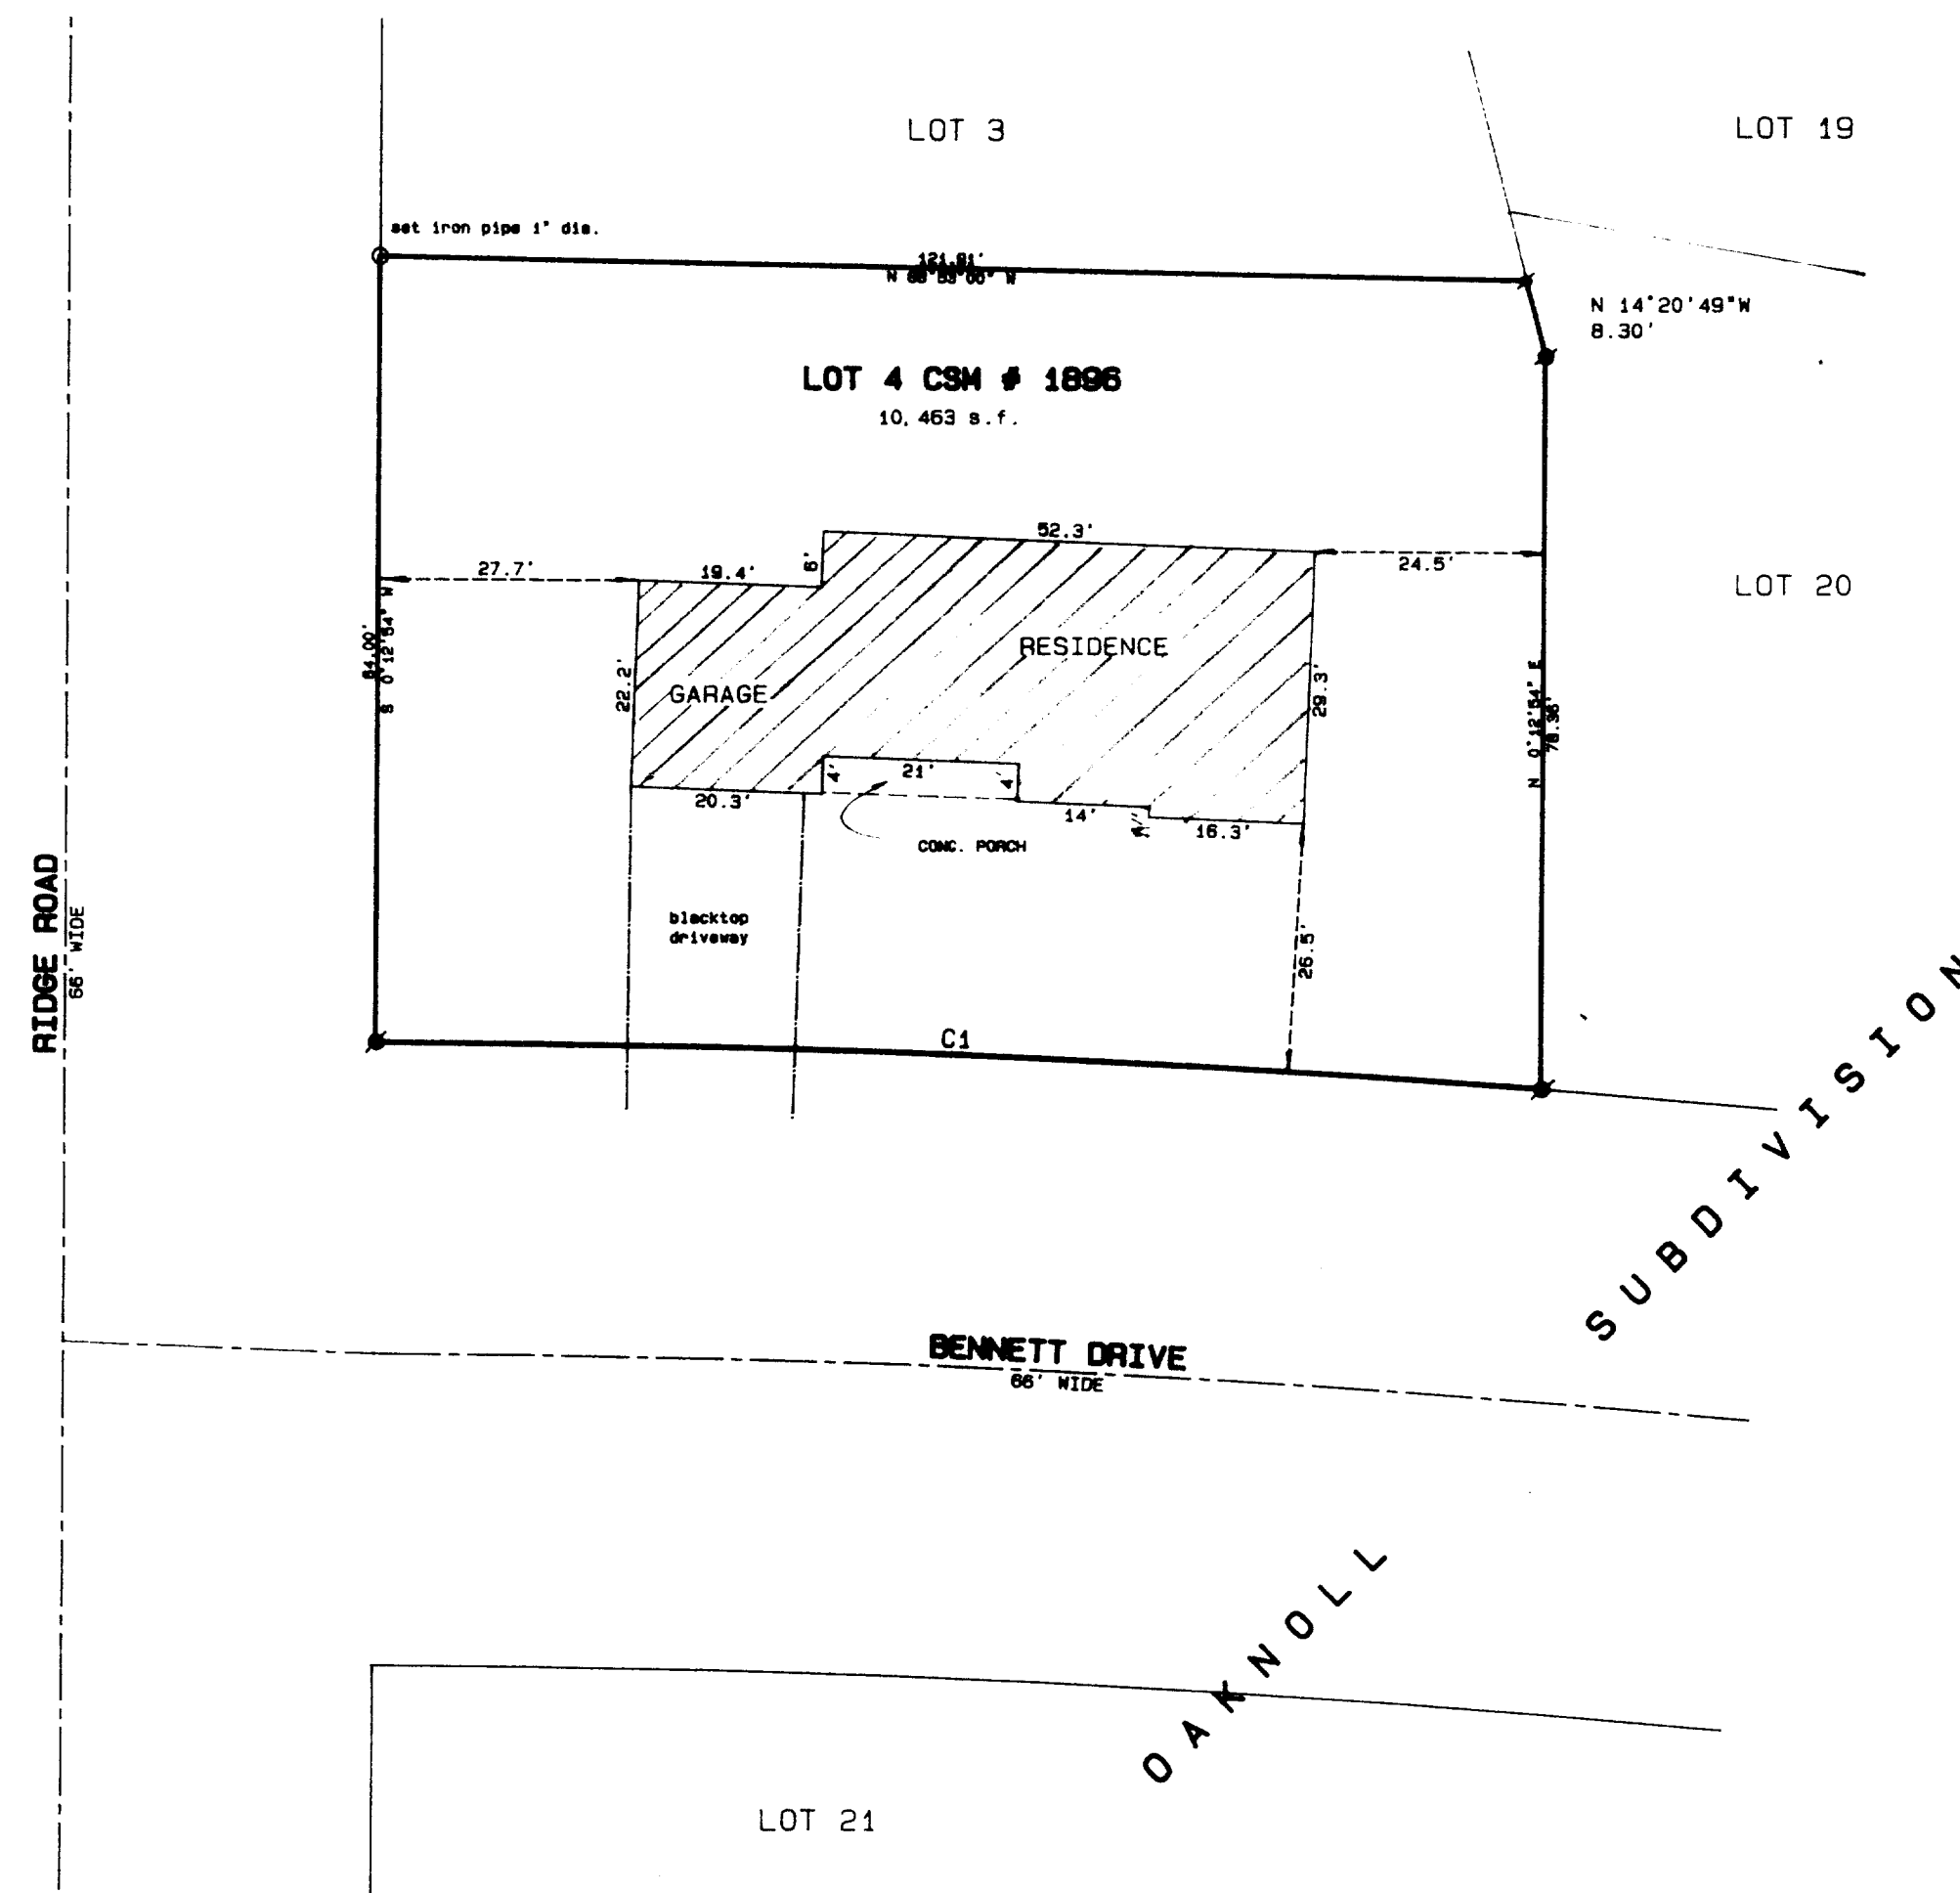


SCALE 1' = 20 FEET

BEARINGS ARE BASED ON PLATTED NORTH

Legend

- * FOUND IRON PIPE
 ● FOUND IRON ROD
 ○ FOUND BRASS CAPPED MONUMENT
 * FOUND CONCRETE MONUMENT
 + CHISEL CUT IN CONCRETE
 ● SET IRON ROD, 24" LONG, WEIGHING
 1.5 LBS. LINEAL FT., 3 3/4" DIA.
 ● SET IRON ROD, 30" LONG, WEIGHING
 4.5 LBS. LINEAL FT., 1-11/16" DIA.
 (xx) RECORDED AS DIMENSION
 — x — x — EXISTING FENCE

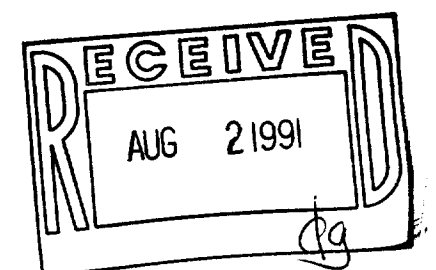


SCALE: 1" = 20' FEET

"I hereby certify that I have surveyed the above described property and that the above map is a true representation thereof and shows the size and location of the property, its exterior boundaries, the location of all visible structures and dimensions of all principal buildings thereon, boundary fences, apparent easements, roadways and visible encroachments, if any."

"This survey is made for the use of the present owners of the property and also those who purchase mortgage, or guarantee the title thereto within one year from date hereof."

Kenneth B. Abernathy, Jr.
KENNETH B. ABERNATHY, JR.
WISCONSIN REGISTERED LAND SURVEYOR,
S-1594

Date: MAY 5, 1991 Job No. 91.510

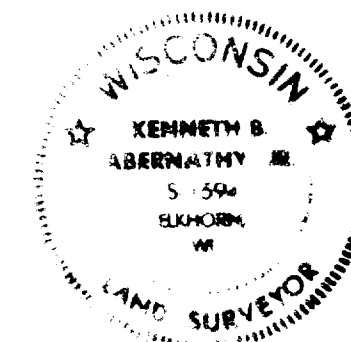

009-406

VA 1896 0004