



Plat of Survey

of

Lot 5 of DaLaPe Heights, located in Section 22, Town 1 North, Range 16 East, Village of Walworth, Walworth County, Wisconsin.

Surveyed for: Ed Wellnitz Builder, Inc.
1001 Highway 14 North
Janesville, Wisconsin. 53545

Bearings referenced to the Subdivision Plat.

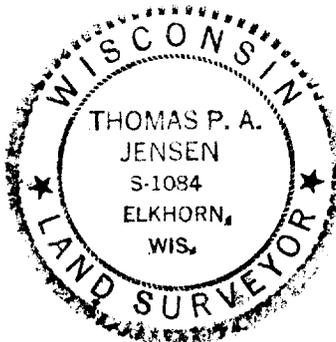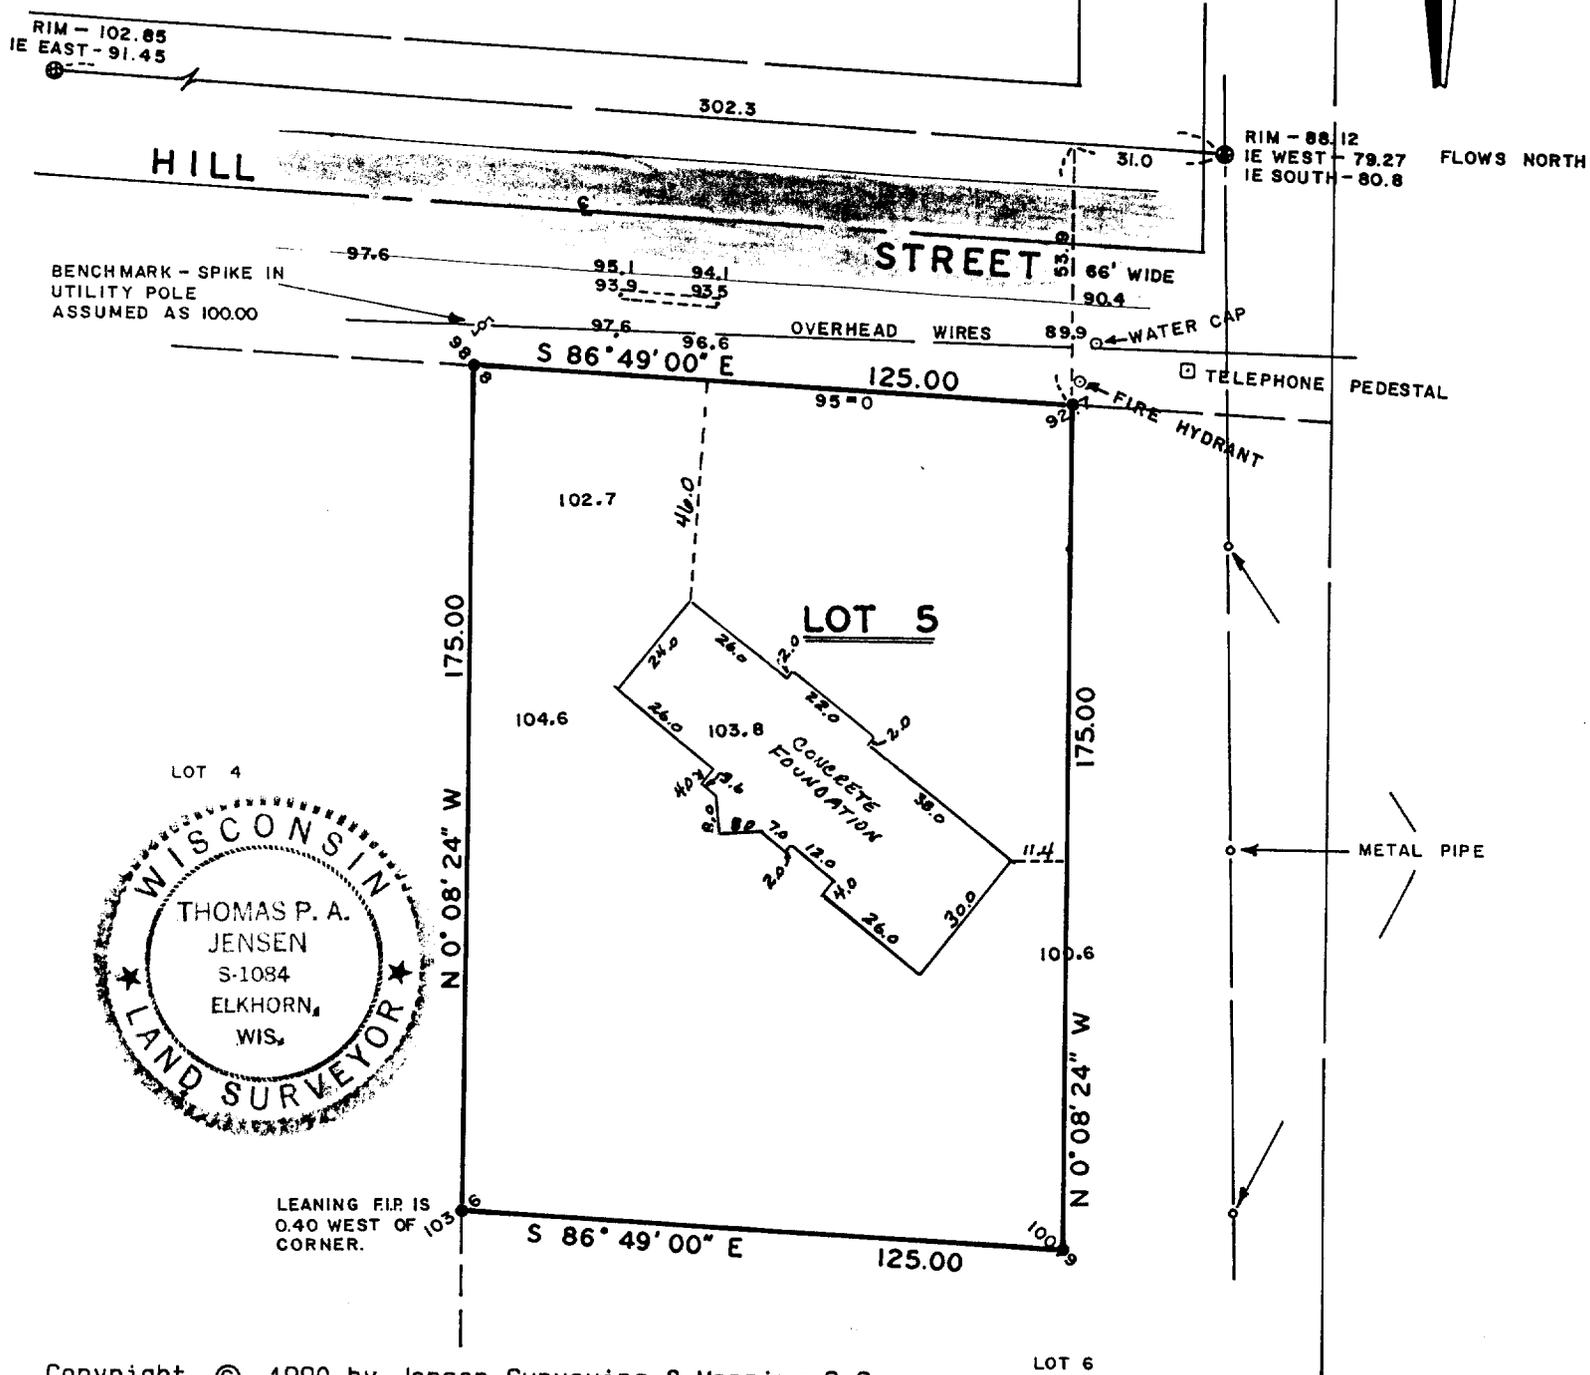


Copyright © 1990 by Jensen Surveying & Mapping S.C.

All rights reserved. No part of this survey plat may be reproduced or transmitted in any form by any means - graphic, electronic, or mechanical, including photocopying, tracing, or information storage and retrieval systems - without permission in writing from Thomas P.A. Jensen.

I, Thomas P.A. Jensen, Wisconsin Registered Land Surveyor, do hereby certify that this survey was performed by me, or under my direction, in full compliance with the owner's/agent's instructions and Chapter A-E 7 of the Wisconsin Administrative Code ' Minimum Standards For Property Surveys ', and that this map is an accurate representation thereof to the best of my knowledge and belief.

Note: This survey plat is not certified unless signed and sealed in red ink.

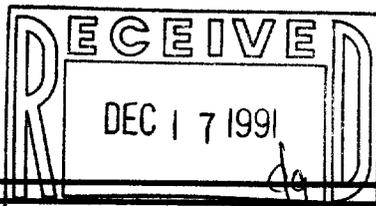

Thomas P. A. Jensen
Thomas P.A. Jensen R.L.S. 1084

Legend

- ~ Found iron pipe
- () ~ Recorded as dimension
- ~ Wood stake 2"x4"
- 972 ~ Spot elevation
- ~ Blacktop surface
- ~ Culvert
- ⊙ ~ Manhole

Jensen Surveying & Mapping S.C.

45 South Wisconsin Street P.O. Box 322
Elkhorn, Wisconsin. 53121.
(414) 723-3434


Mapping date: September 26, 1990

Revisions: 11-06-90

Sheet 1 of 1 Sheets

Job reference number:

1990.145

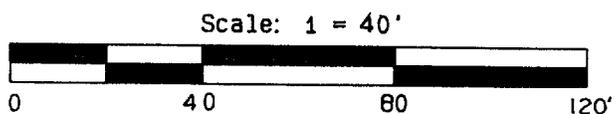

VCBH-5