


DUNHAM SURVEYING, S.C.
SURVEYING & SUBDIVIDING
DELAVER, WISCONSIN 53115

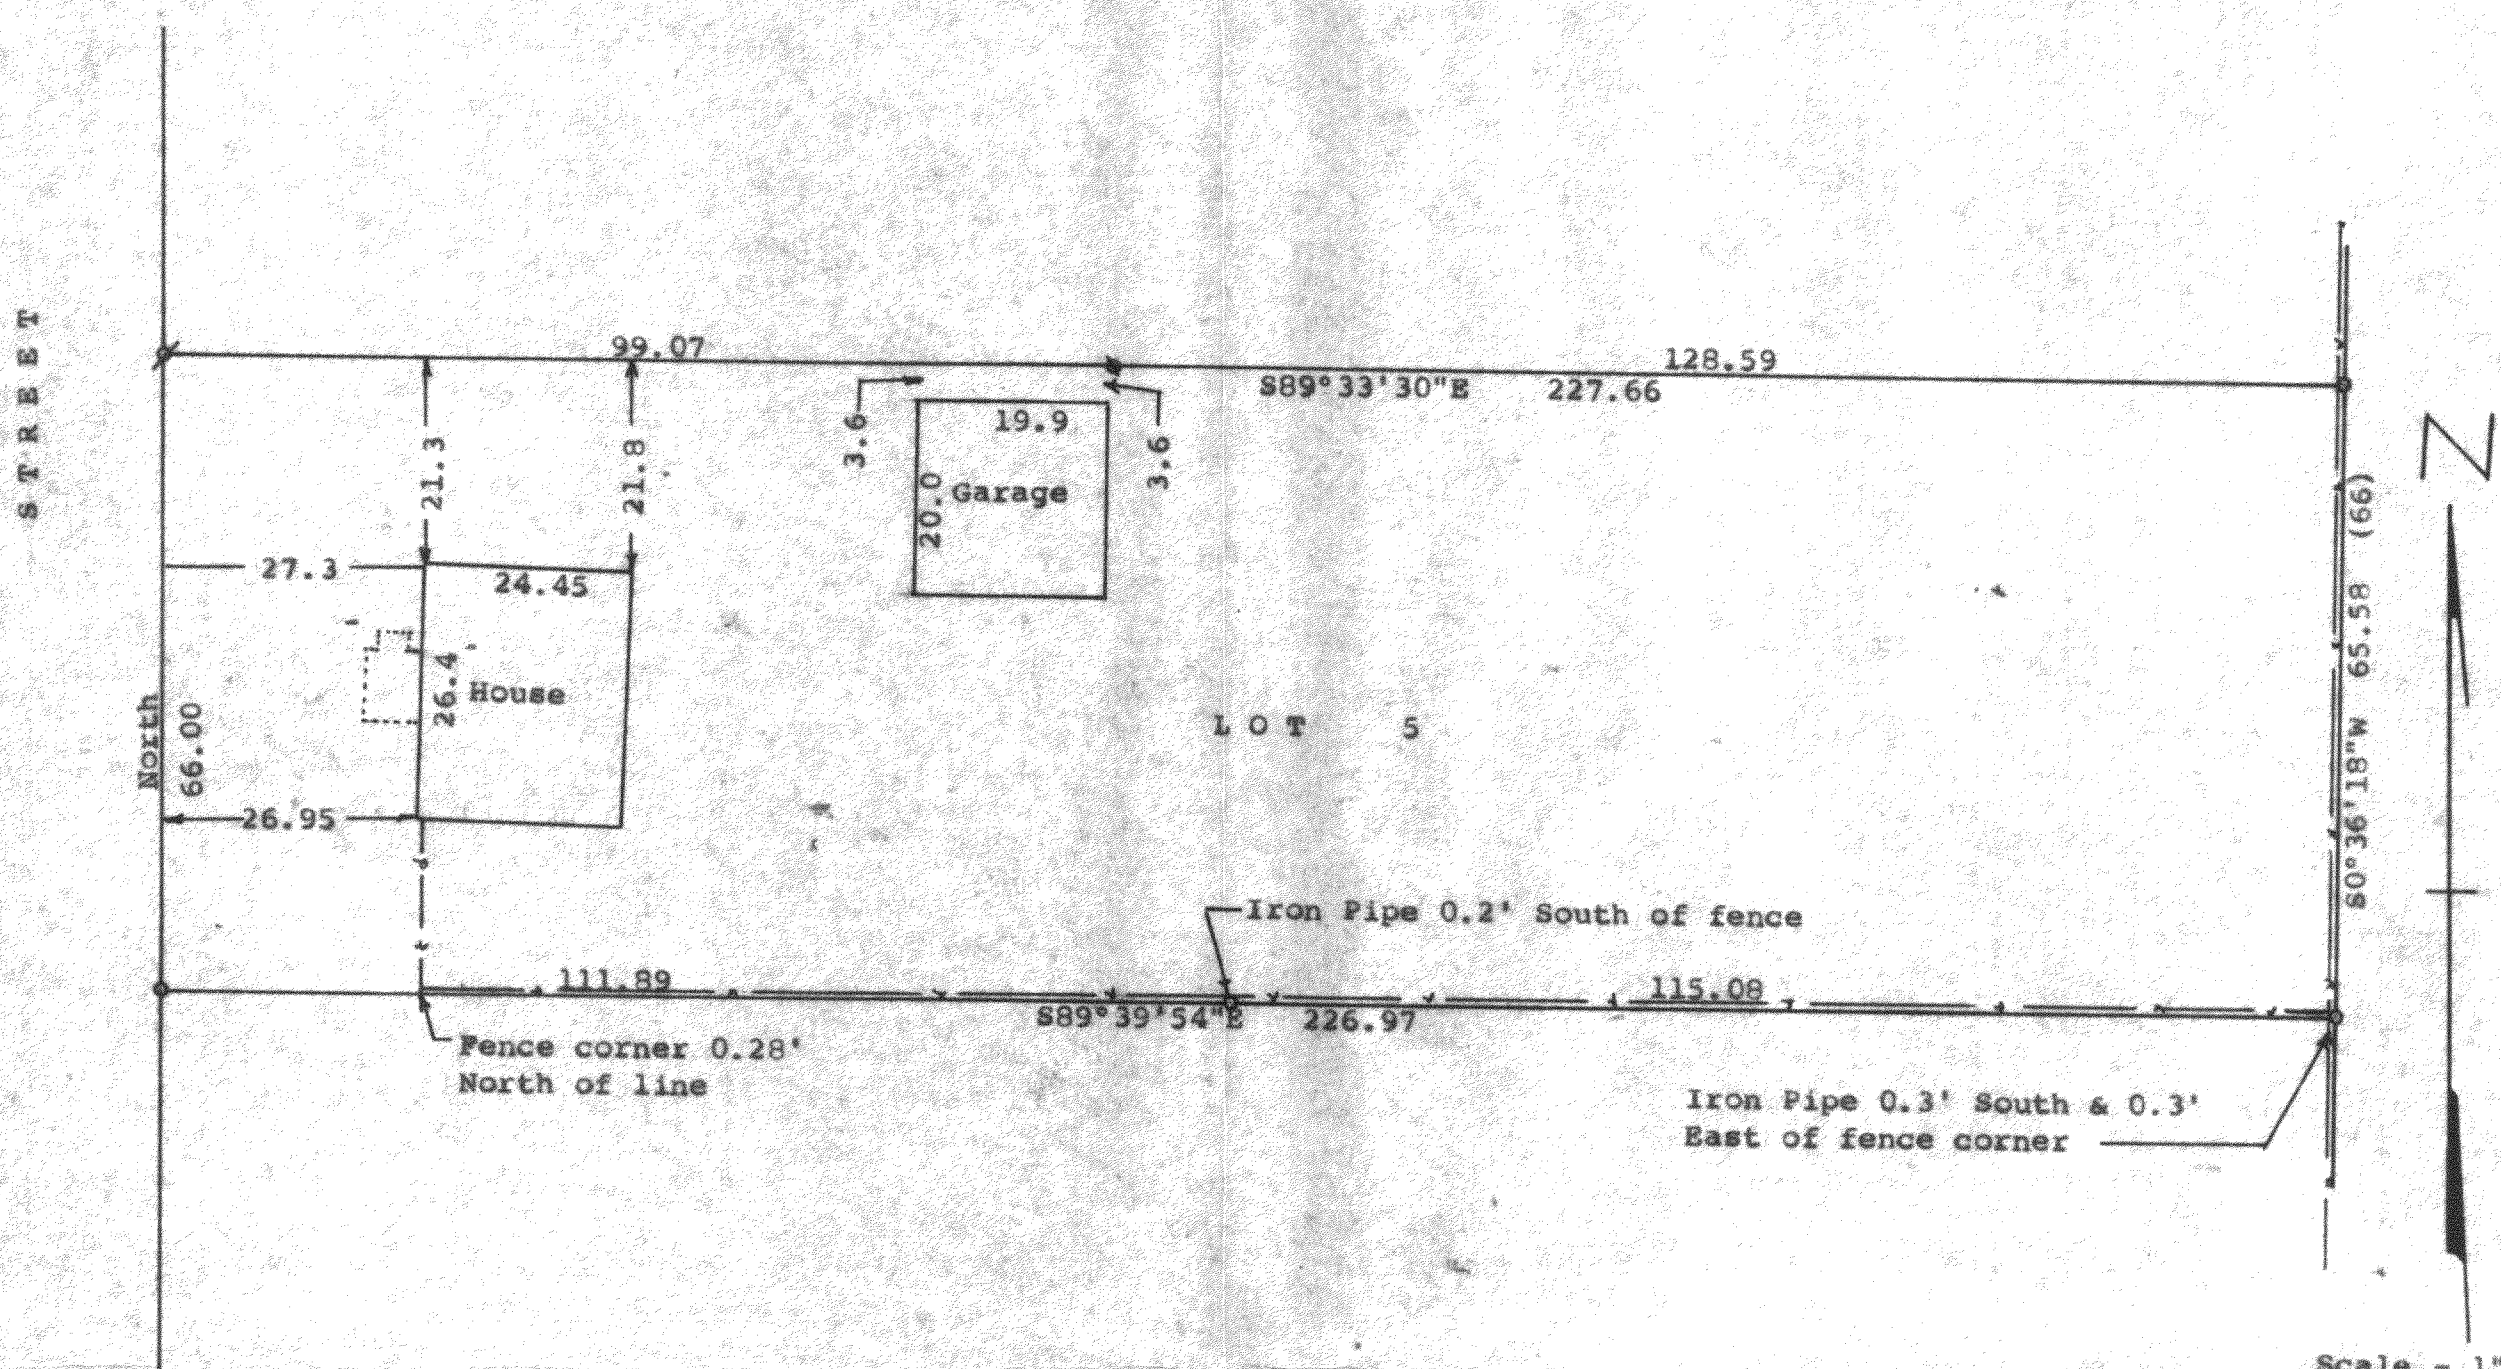

Scale - 1" = 20'

⊗ = 1" Iron Pipe Found

○ = 1½" Iron Pipe Found

⊙ = 1½" Iron Pipe Found

(0.00) = recorded distance

Bearings referenced to the east line of Weber Street with the assumed bearing of North

Survey ordered by:

Churchill Real Estate

322 Park

Walworth, WI 53184

--- fence line

STATE OF WISCONSIN)
COUNTY OF WALWORTH)

I, George T. Dunham, Surveyor, certify that I have surveyed the property described as follows:

Lot 5 in Block 1 of Crandall and Swinney's Subdivision, located in the Village of Walworth, Walworth County, Wisconsin, and that the plat shown hereon is a correct representation thereof and shows the size and location of the property, its exterior boundaries, the location of all visible structures and dimensions of all principal buildings thereon, boundary fences, apparent easements, roadways and visible encroachments, if any, and that I have surveyed the property hereon described, according to the official records, to the best of my knowledge and belief.

October 19, 1990

George T. Dunham
George T. Dunham, Surveyor

